




SEKSIJON 4 I SANEIET  
 MARØYVEGEN 154-156

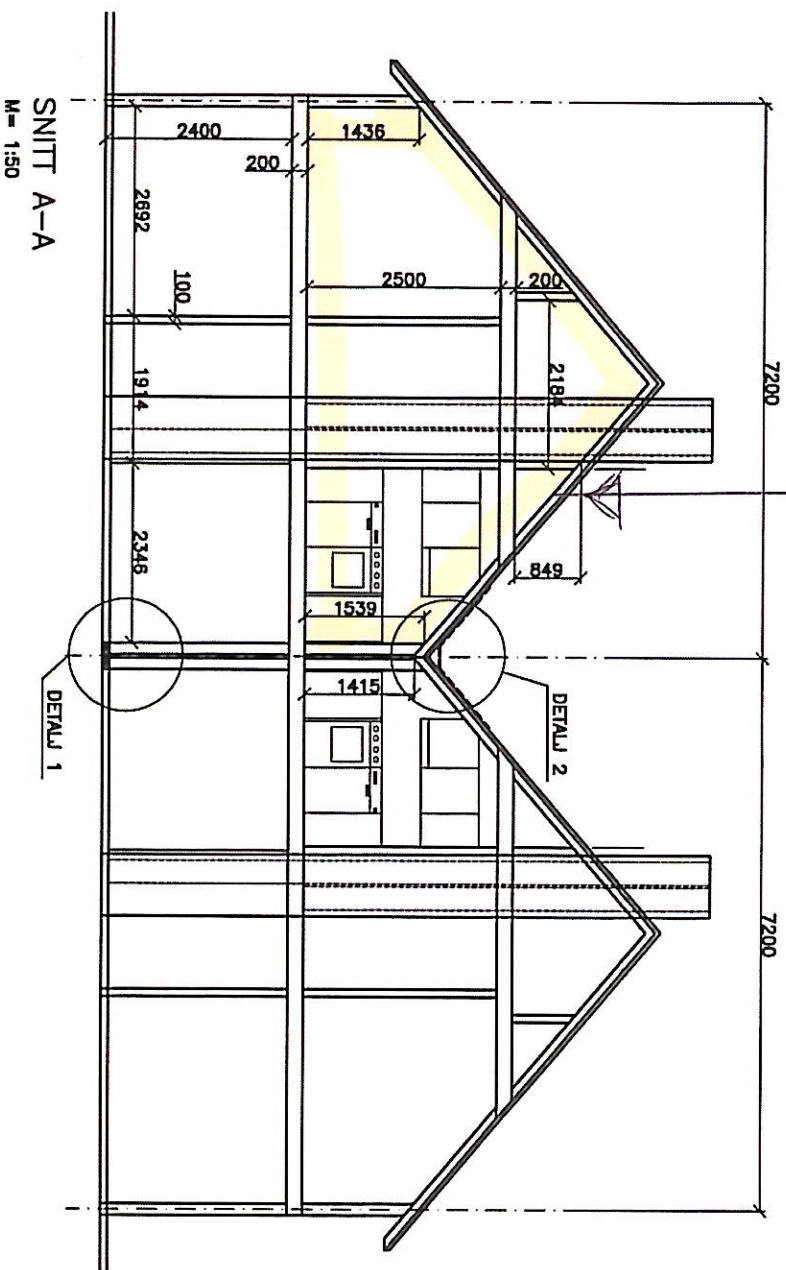

SNITT A-A  
 M = 1:50

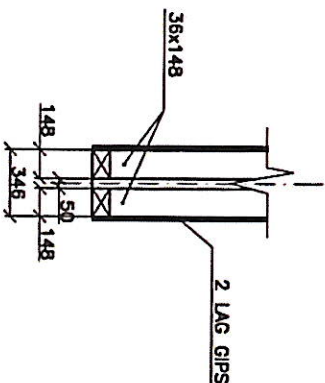

DETALJ 1  
 M = 1:20

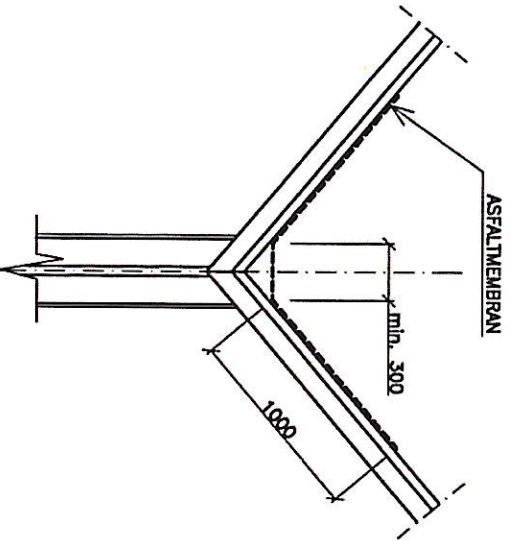

DETALJ 2  
 M = 1:20

SOM BYGGET

DETALJ 1: PIPER	1	10/10/07
KVALHEIM FRITDSSENTER AS		
KVALHEIMNESSET, RADØY KOMMUNE		
ROBBUER, ENHET 35 - 38, SNITT A-A		
<b>Siv.ing. Atle Sundal</b>	<b>5.104-A</b>	
15	15	
1:50	1:50	
22.02.07		