






TEGNFORKLARING

- — — SENTERLINJE VEG
-  VEGFYLLING
-  SKJÆRING

NOTE:	ACCORDING TO INTERNATIONAL LAWS, THIS DRAWING IS NOT VALID FOR CONSTRUCTION. THE DRAWING CAN NOT BE USED, MADE PUBLIC OR HANDED OVER TO A THIRD PARTY WITHOUT OUR WRITTEN CONSENT. ANY INFRACTION WILL LEAD TO LEGAL PROCEEDINGS
* PART OF DRAWING MAY NOT BE SHOWN IN SCALE	
* DO NOT TAKE MEASURES ON DRAWING	
* ONLY RELY ON GIVE DIMENSIONS	
DATE/REVISION	REVISION/DATE:
	PROJECT NO.: 2013233
	DRAWING NO.: 41013233A01
	SCALE: 1:500
	FORMAT: A2
	DRAWN: PKT
	DATE: 31.10.13
	CHECKED:
	DATE:
REV. DESCRIPTION	
	ODD SAMSONSEN / BIRTE JENSEN
	NY HYTTEVEG
	VEGPLAN
	
	ARKOCONSULT AS, Postboks 103, 5291 Volest.f., Tel.: 56390003 – Fax: 56191130 – Mob.: 93241511 Mail: post@arkoconsult.no – Org.nr.: 997089782 MVA

1-A

HOH.  
1-13

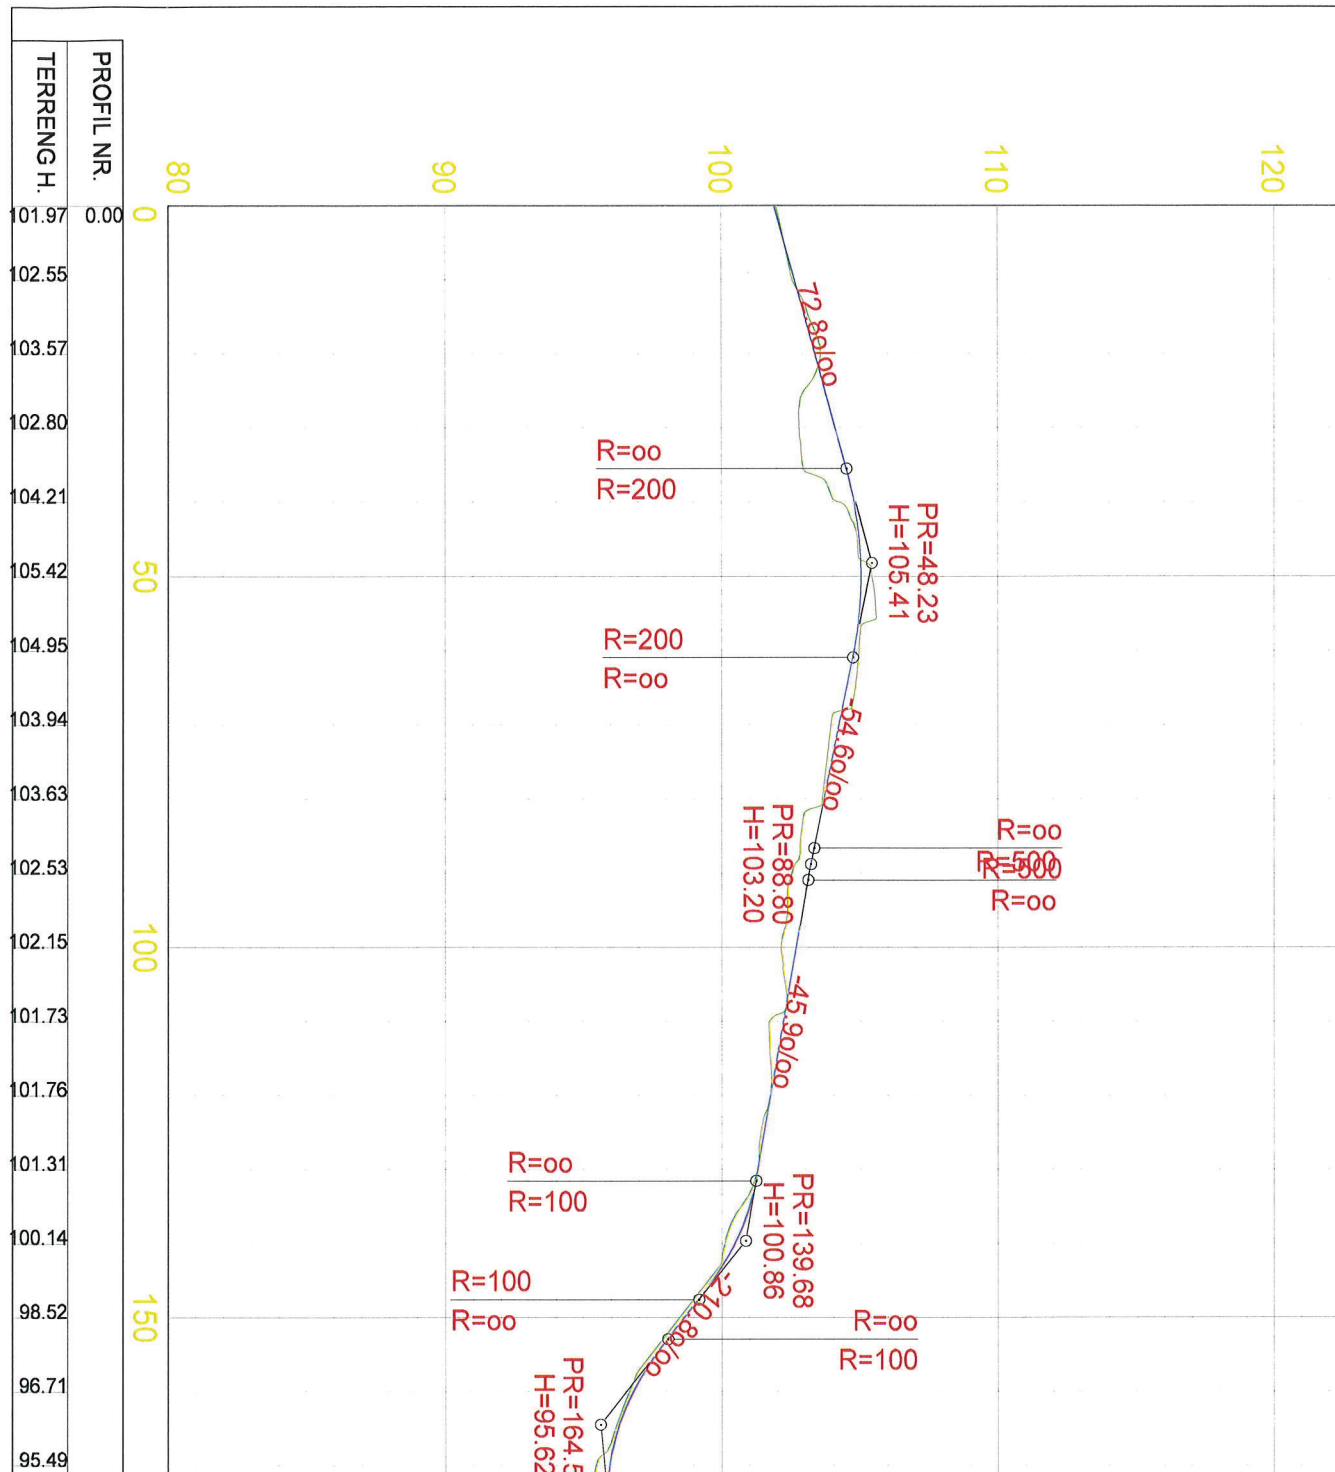

REV.	DESCRIPTION	DATE/SIGN
	NOTE: * PART OF DRAWING MAY NOT BE SHOWN IN SCALE * DO NOT TAKE MEASURES ON DRAWING * ONLY RELAY ON GIVEN DIMENSIONS	
	ACCORDING TO INTERNATIONAL LAWS THIS DRAWING IS THE PROPERTY OF ARKOCONSULT AS. THE DRAWING CAN NOT BE USED, MADE PUBLIC OR HANDED OVER TO A THIRD PARTY WITHOUT OUR WRITTEN CONSENT. ANY INFRINGEMENT WILL LEAD TO LEGAL PROCEEDINGS.	
	ODD SAMSONSEN/BIRTHE JENSEN NY HYTTEVEG - AS BUILT	REVISION/DATE: PROJECT NO.: 2013233
	LENGDEPROFIL VEG GNR. 193 BNR 2, 9, 15	DRAWING NO.: 41013233A02
	SCALE: 1:750/200	FORMAT: A3
	DRAWN: PNT	DATE: 31.10.13
	CHECKED:	DATE:

ARKOCONSULT AS, Postboks 103, 5291 Valeså, L.  
Tel.: 56390003 - Fax.: 56191130 - Mob: 93241511  
Mail: post@arkoconsult.no - Org.nr.: 997089782 MVA



PROFIL NR.  
TERRENG H.