

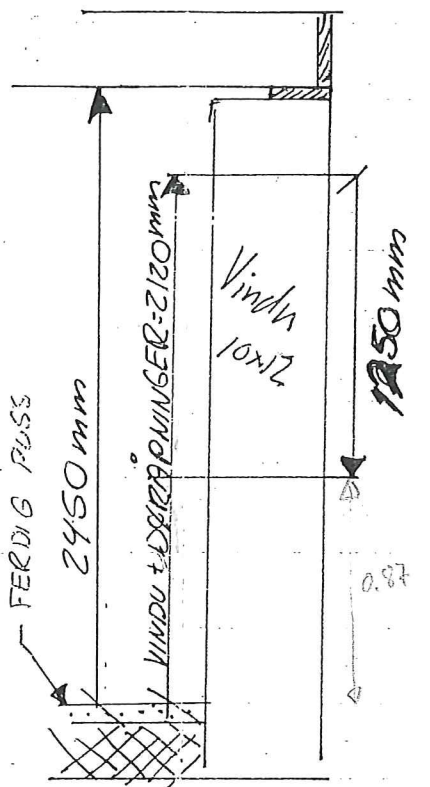


7.5cm Leca 1.4m²

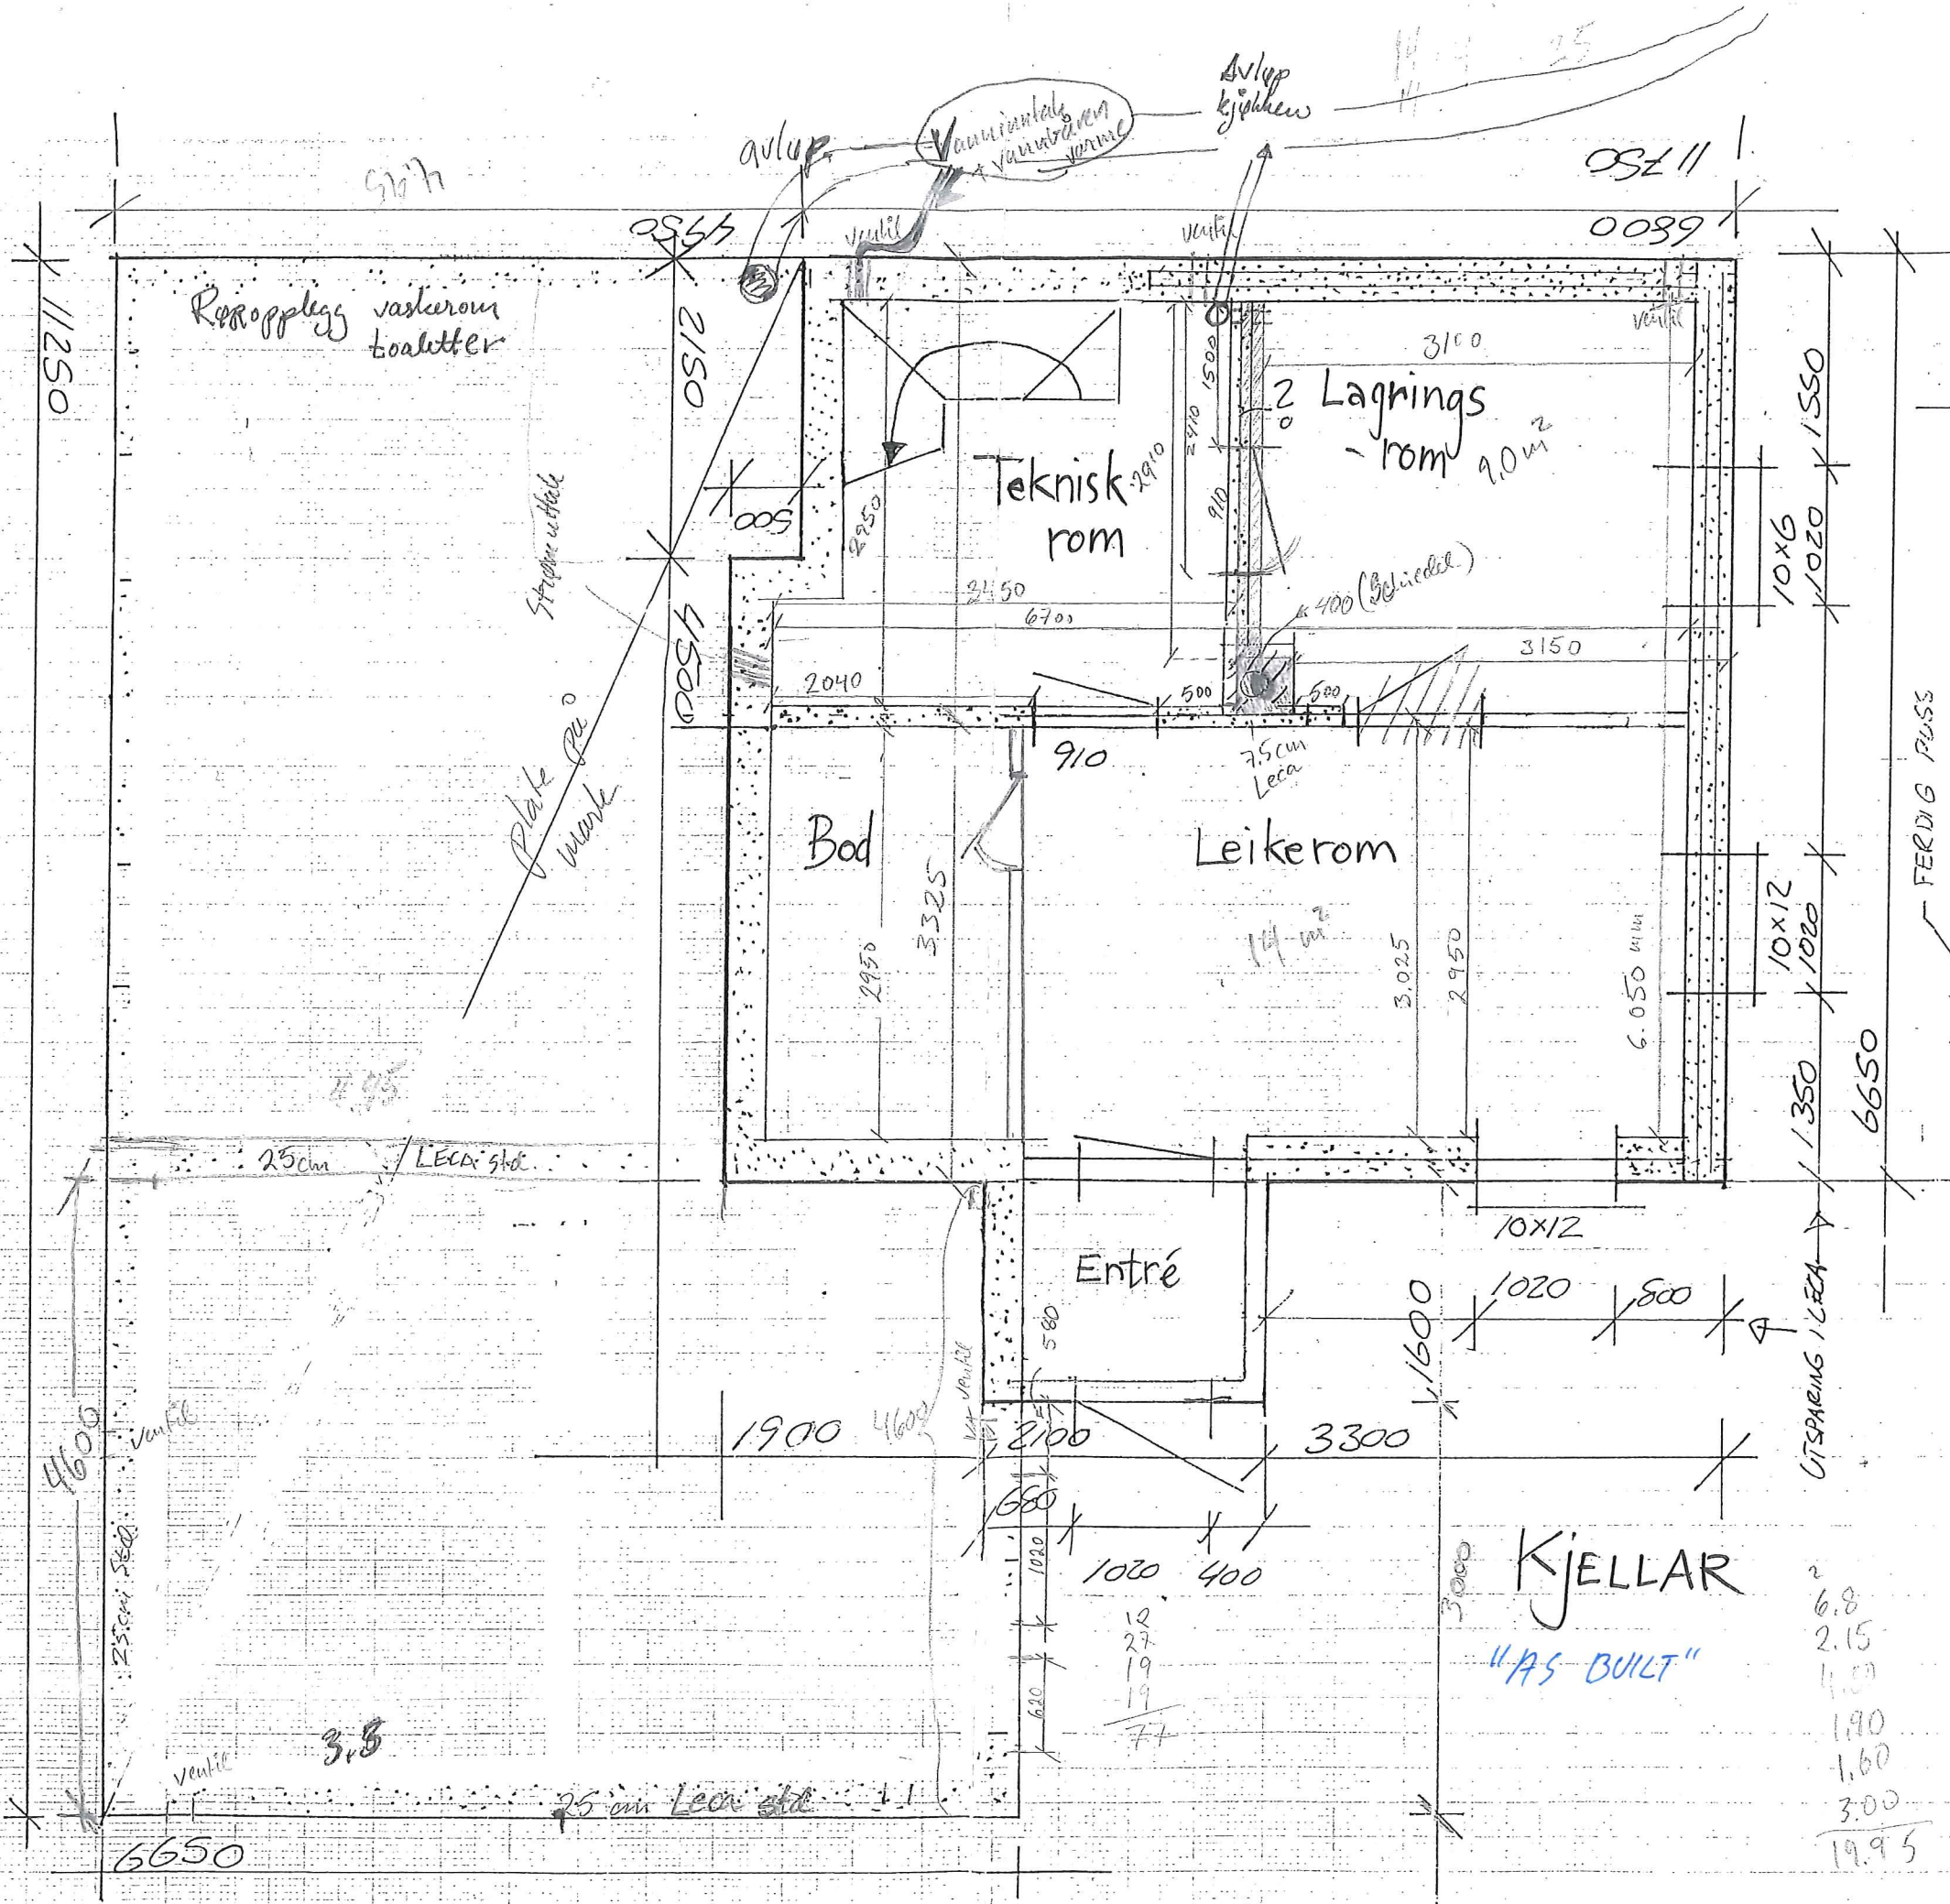

1.3.0.35.0.20
 0.8 m
 55.19

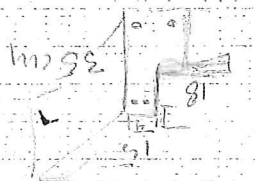

2.130
 1.250
 0.87

KJELLAR
 "AS BUILT"

6.8
 2.15
 1.0
 1.90
 1.60
 3.00
 19.95 * 4 ~ 80 sett/sett

6650

4600

6650

10x12
 1020

10x6
 1020

0511
 0089

25 cm Leca etc

25cm Leca etc

Plate på vane
 Strøper utkle

Ressopplegg vaserom toaletter

Teknisk rom

Lagringsrom 9.0m²

Leikerom 14 m²

Bod

Entré

7.5cm Leca

1900

4550

2150

11250

12
 27
 19
 19
 77

2100

3300

1600

10x12

1020

500

10x12

1020

10x6

1020

1550

3100

2910

2910

