



6721820

6721800

6721780

300840

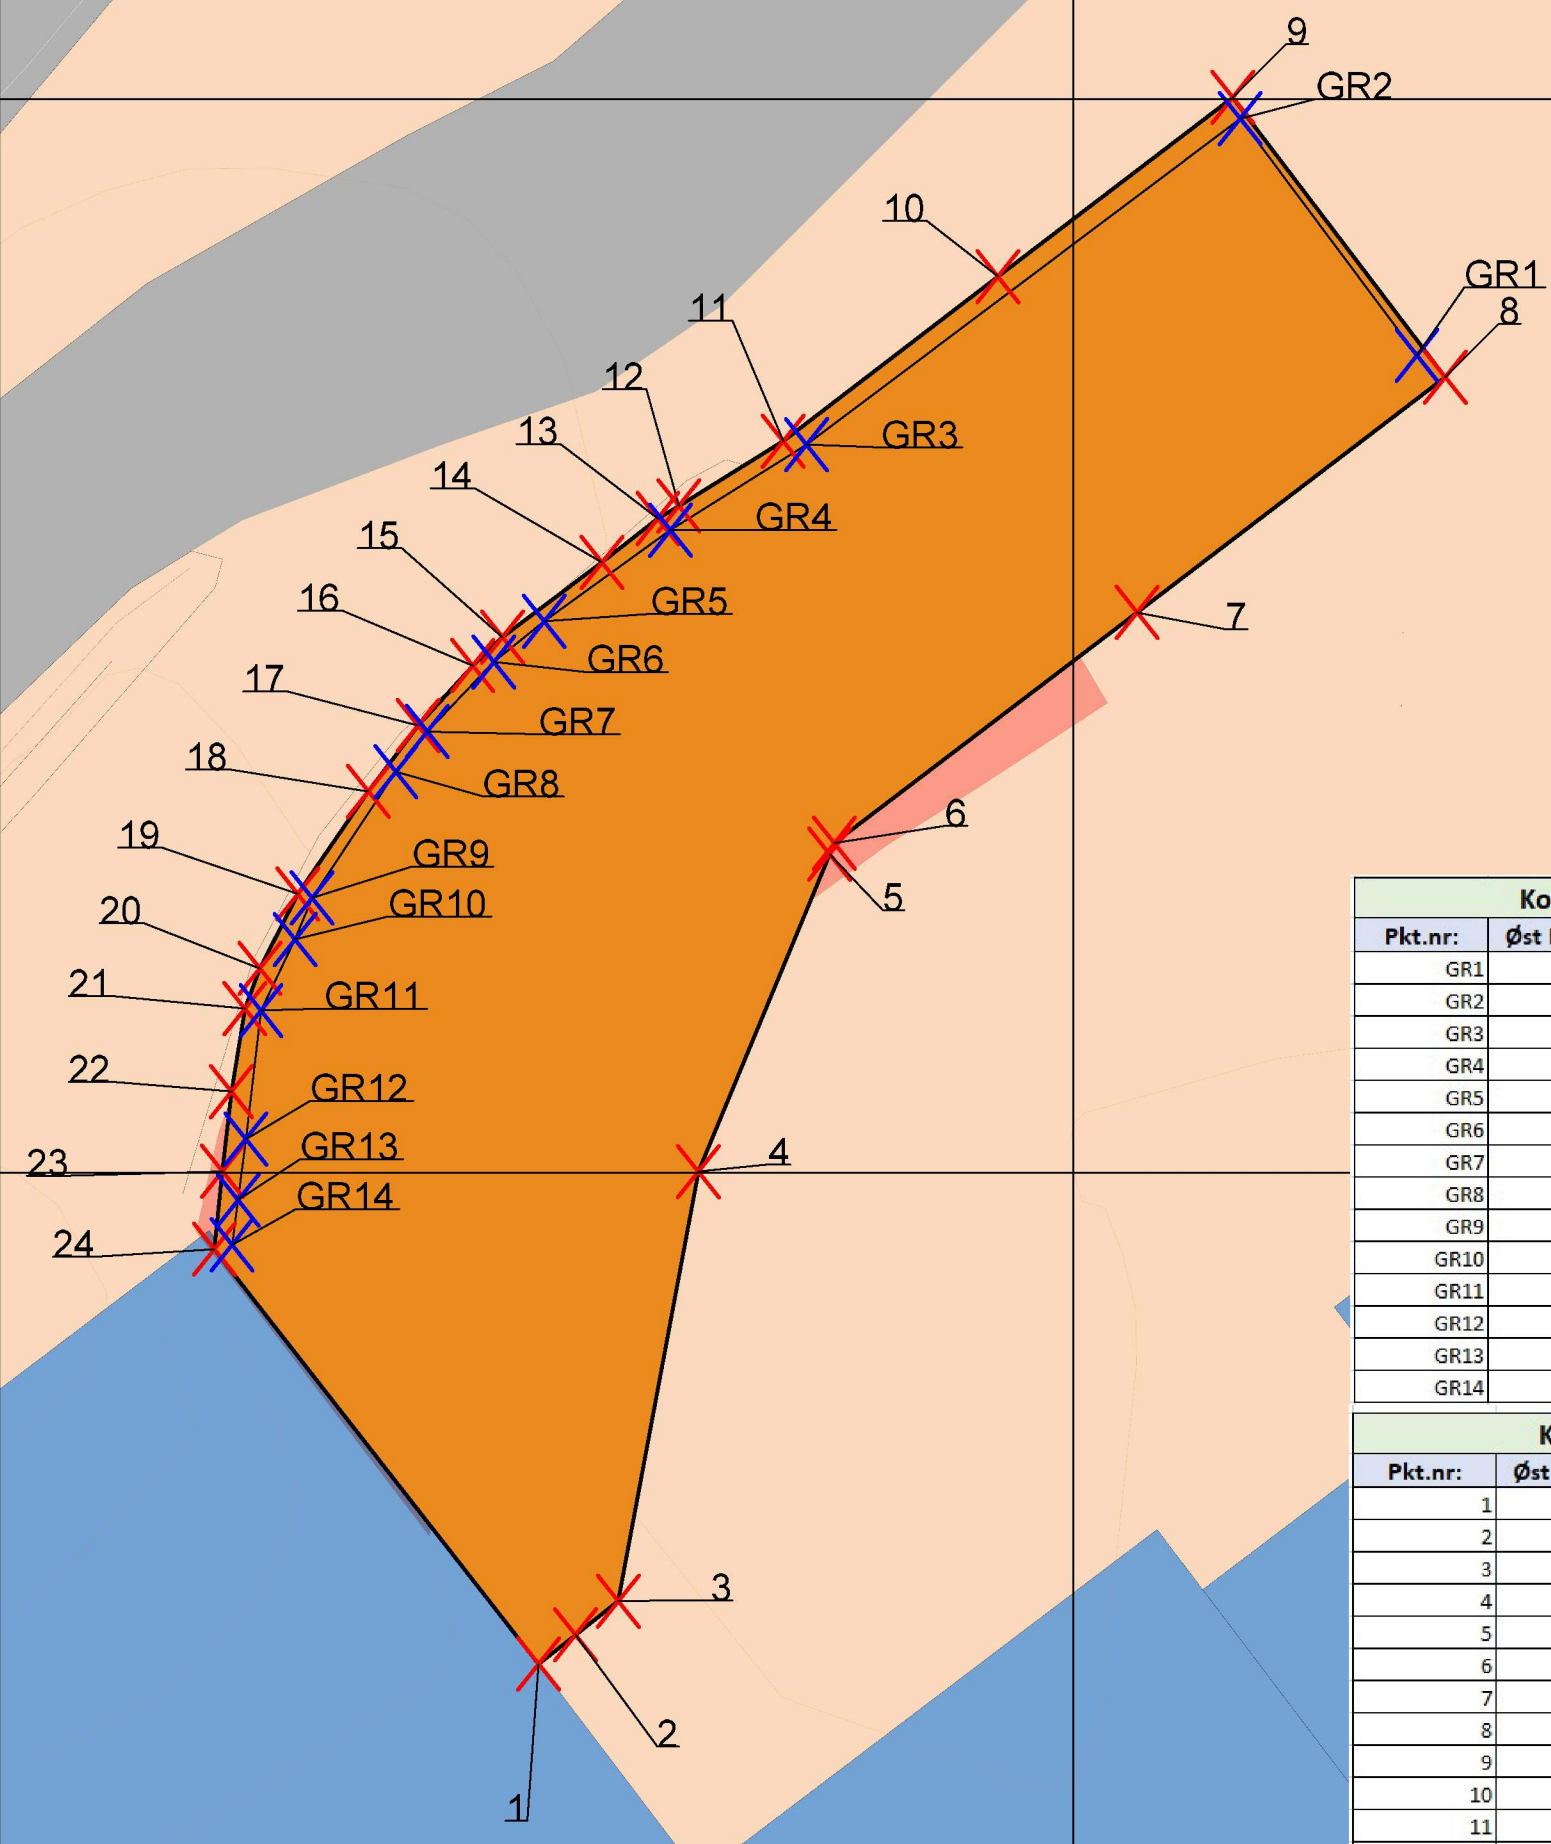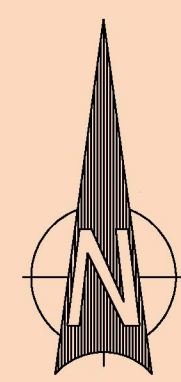


300860



Koordinatliste Grunnmur			
Pkt.nr:	Øst Koordinat:	Nord Koordinat:	Høyde:
GR1	300866.41	6721815.22	24.11
GR2	300863.12	6721819.63	24.02
GR3	300855.04	6721813.56	24.48
GR4	300852.50	6721811.97	24.48
GR5	300850.16	6721810.27	24.44
GR6	300849.22	6721809.51	24.41
GR7	300847.98	6721808.21	24.44
GR8	300847.39	6721807.47	24.40
GR9	300845.83	6721805.12	24.38
GR10	300845.51	6721804.34	24.34
GR11	300844.88	6721803.02	24.47
GR12	300844.60	6721800.63	24.46
GR13	300844.45	6721799.49	24.46
GR14	300844.34	6721798.66	24.46

Koordinatliste Takkant			
Pkt.nr:	Øst Koordinat:	Nord Koordinat:	Høyde:
1	300850.05	6721790.85	26.99
2	300850.74	6721791.39	26.99
3	300851.53	6721792.02	26.91
4	300853.03	6721800.02	27.14
5	300855.47	6721805.93	27.18
6	300855.56	6721806.14	27.14
7	300861.20	6721810.43	27.13
8	300866.94	6721814.81	27.27
9	300862.98	6721820.02	27.50
10	300858.61	6721816.69	27.50
11	300854.61	6721813.62	27.49
12	300852.66	6721812.42	27.51
13	300852.27	6721812.18	27.49
14	300851.23	6721811.37	27.50
15	300849.38	6721809.97	27.50
16	300848.82	6721809.44	27.50
17	300847.80	6721808.33	27.50
18	300846.88	6721807.10	27.50
19	300845.57	6721805.19	27.50
20	300844.86	6721803.80	27.50
21	300844.58	6721803.06	27.50
22	300844.33	6721801.51	27.50
23	300844.16	6721800.02	27.50
24	300844.01	6721798.58	27.50

Tegnforklaring

-  Innmålt bygning 07-04-2020
-  Innmålt topp grunnmur
-  Innmålt takkant

Helgesen Tekniske Bygg AS

Dato 14.04.2020	Konstr. tegnet KEG	Godkjent GOB	Målestokk 1:150	
EUREF89 - SONE 32 NN 2000 høyder				
Innmålt som bygget Eknes Karosseri Kmnr:1263, Gnr:19 Bnr:111				Erstattet av: 901
Henvisning:		Beregning:		