
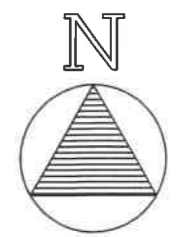


D1

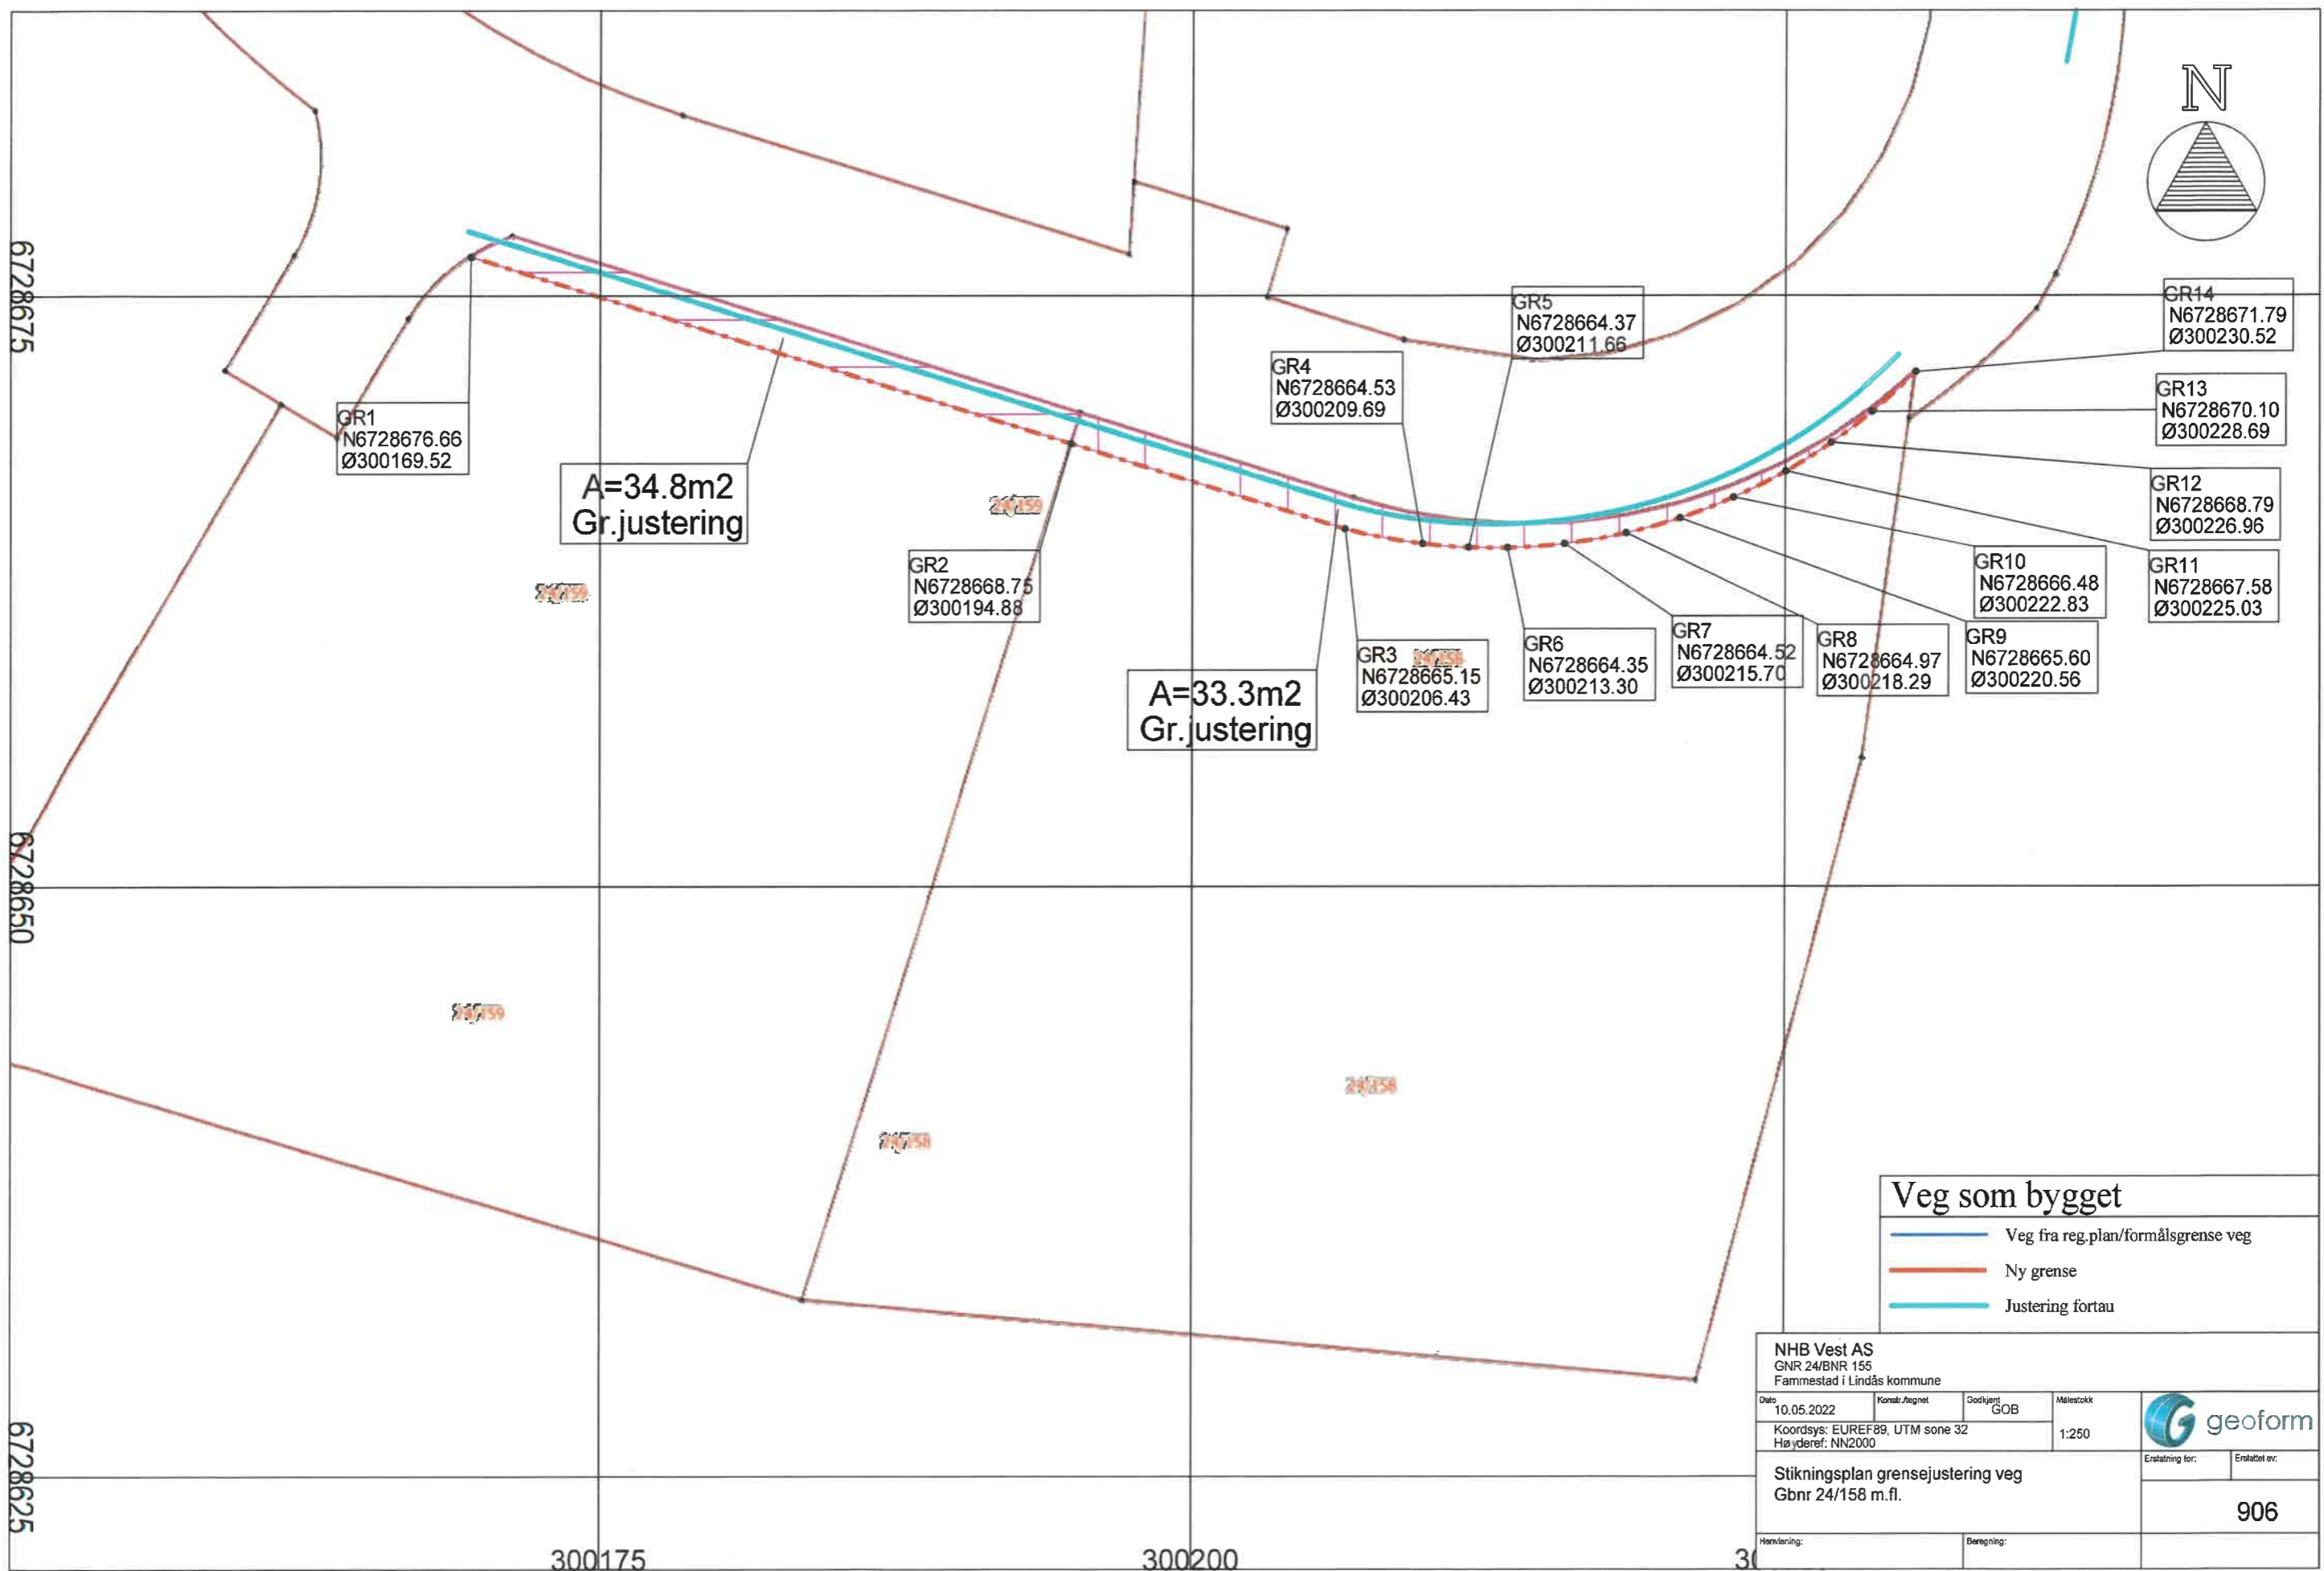

GR1
N6728676.66
Ø300169.52

A=34.8m²
Gr.justering

GR2
N6728668.75
Ø300194.88

A=33.3m²
Gr.justering

GR4
N6728664.53
Ø300209.69

GR5
N6728664.37
Ø300211.66

GR3
N6728665.15
Ø300206.43

GR6
N6728664.35
Ø300213.30

GR7
N6728664.52
Ø300215.70

GR8
N6728664.97
Ø300218.29

GR9
N6728665.60
Ø300220.56

GR10
N6728666.48
Ø300222.83

GR11
N6728667.58
Ø300225.03

GR12
N6728668.79
Ø300226.96

GR13
N6728670.10
Ø300228.69

GR14
N6728671.79
Ø300230.52

Veg som bygget	
	Veg fra reg.plan/formålsgrense veg
	Ny grense
	Justering fortau

NHB Vest AS			
GNR 24/BNR 155			
Fammestad i Lindås kommune			
Dato	Kontr./Aegnet	Godkjent	Målestokk
10.05.2022		GOB	1:250
Koordsys: EUREF89, UTM sone 32			
Høyderef: NN2000			
Stikningsplan grensejustering veg			Erstatning for: Erstatet av:
Gbnr 24/158 m.fl.			
Havføring:			906
Beregning:			