


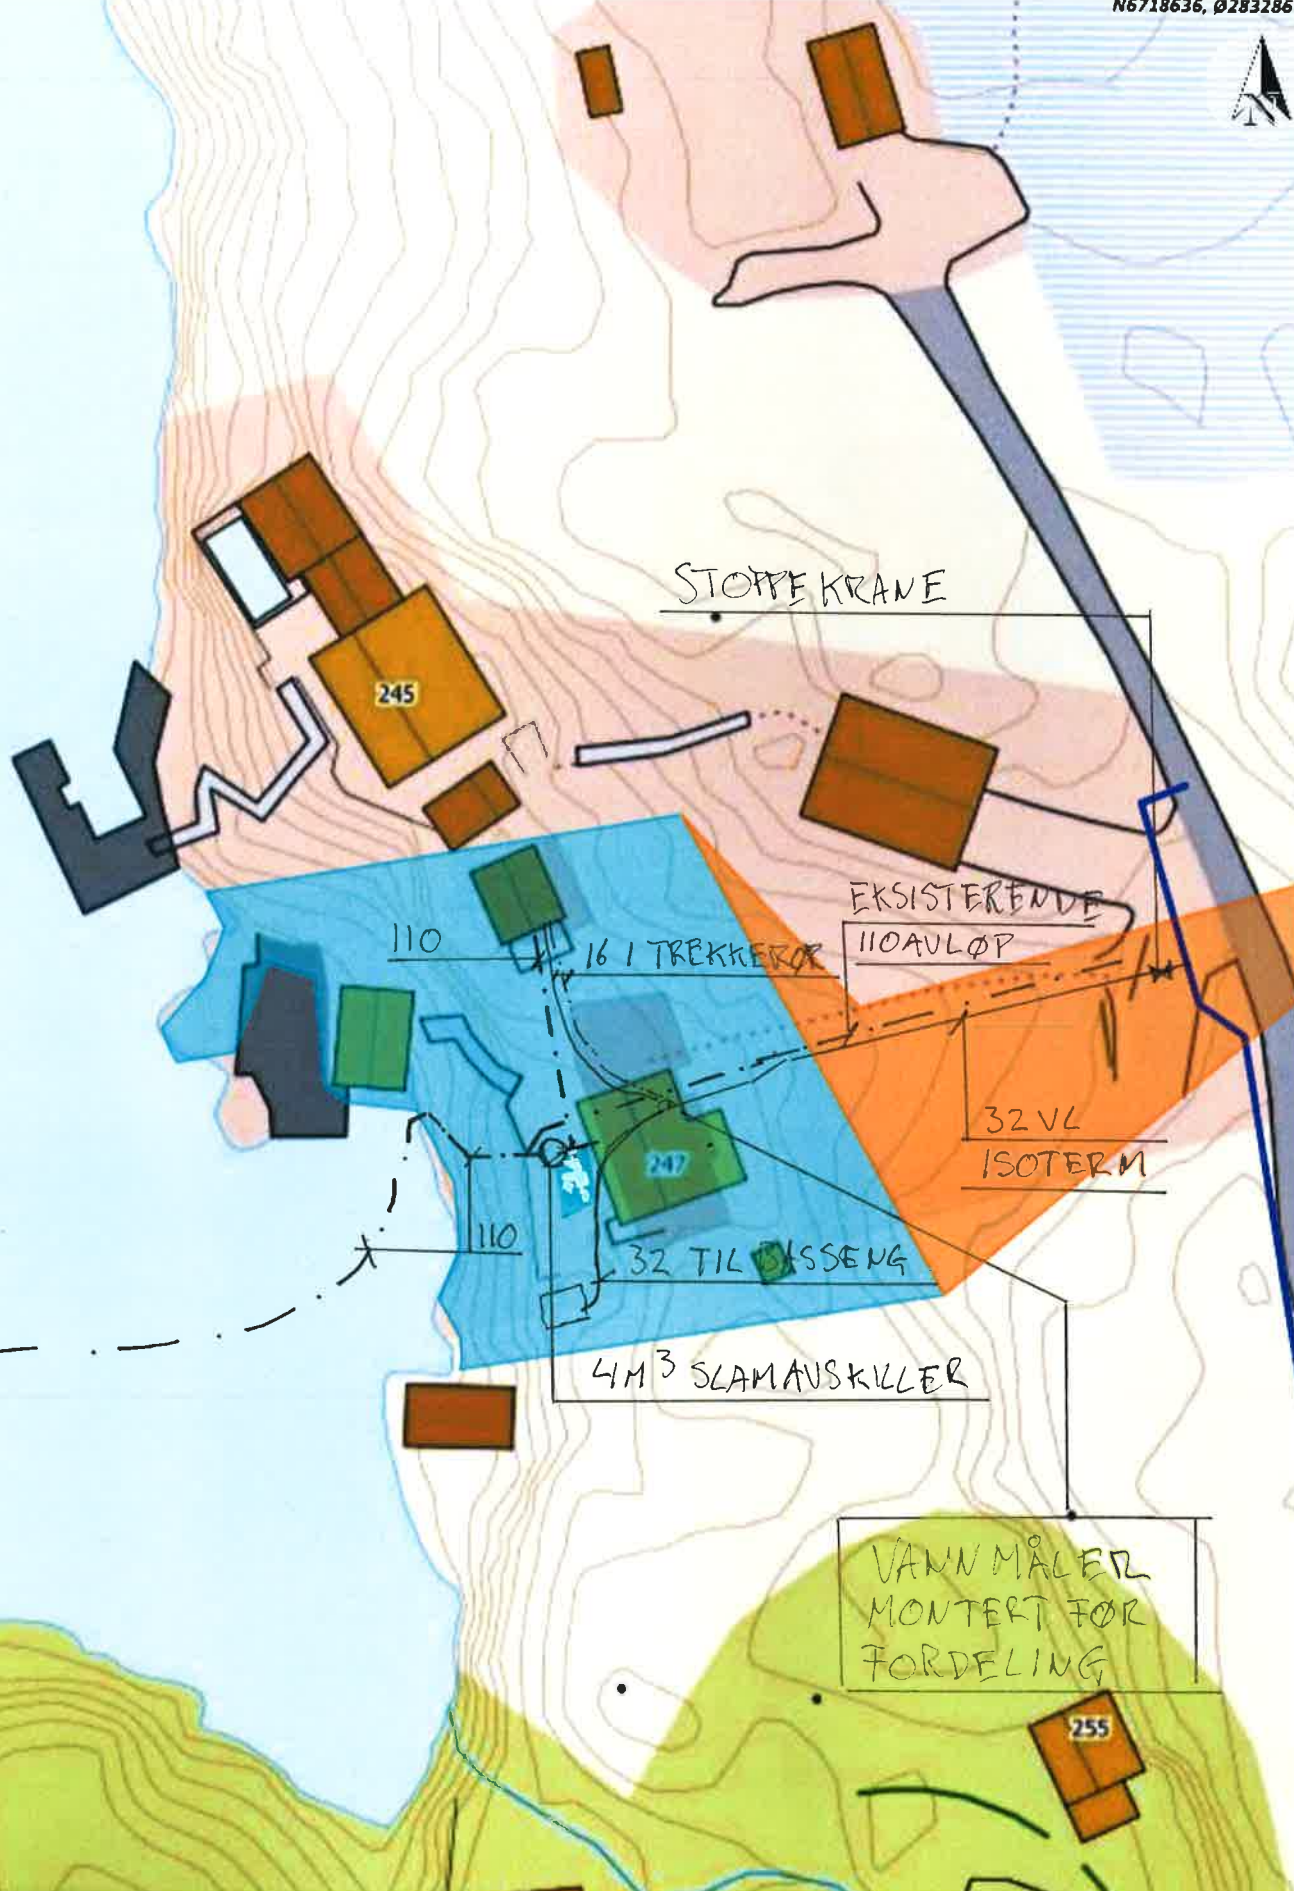

Situasjonskart - 342/24 342/79

VA kart 1/500

TK RØR AS

14.04.21

SOM BYGGET T.K.

NHdigi.no

Dato: 08-04-2021

Målestokk: 1:500

15m