




Plan loft Garasje
Åge Nilzen 06.04-16 R.K
Mål 1:50

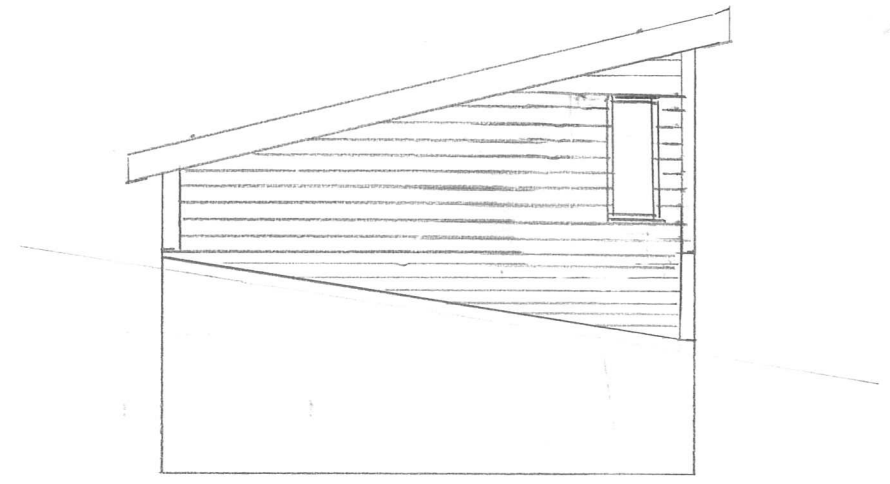


Fasade Øst

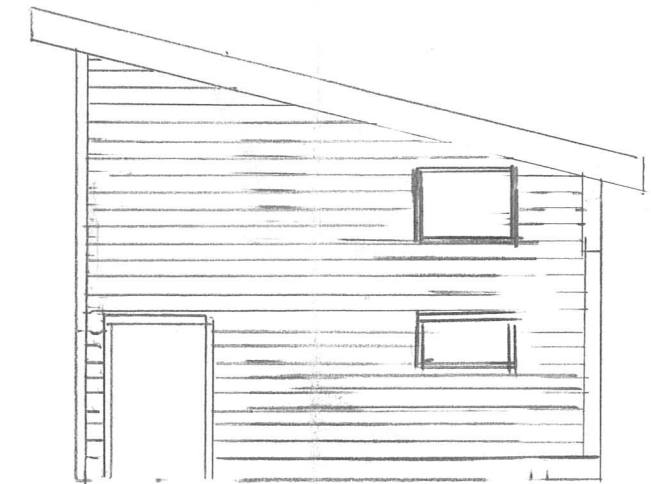

Fasade Vest

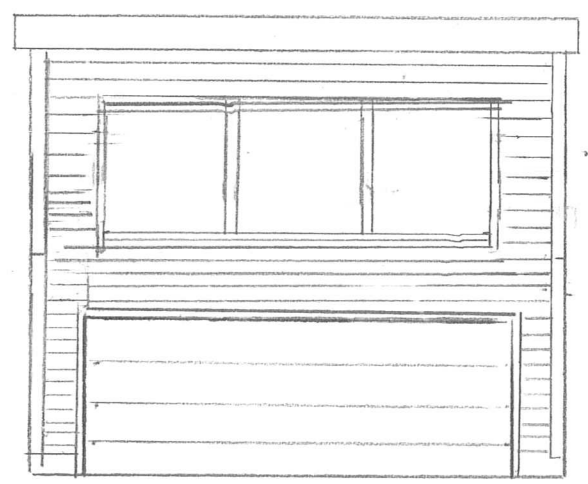



Fasade Nord

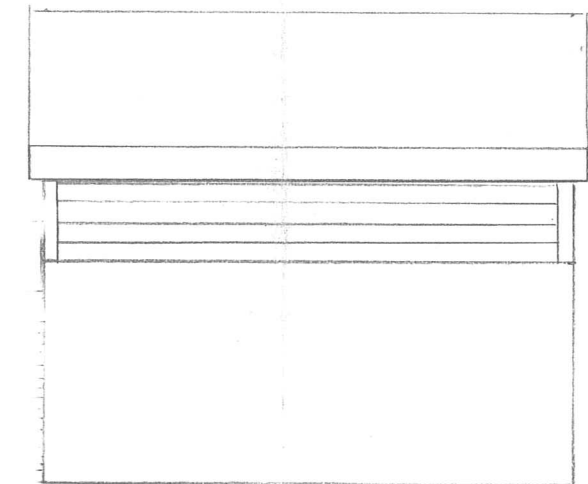

Fasade Sør

rev 8.8.16 flyttet dør 2.etg
rev 17.06.16 fasade Nord
Fasade garage 1:100
Åge Nilsen 06.08.16
Nedre Mangerbua 10
G/Bnr 137/748

as built

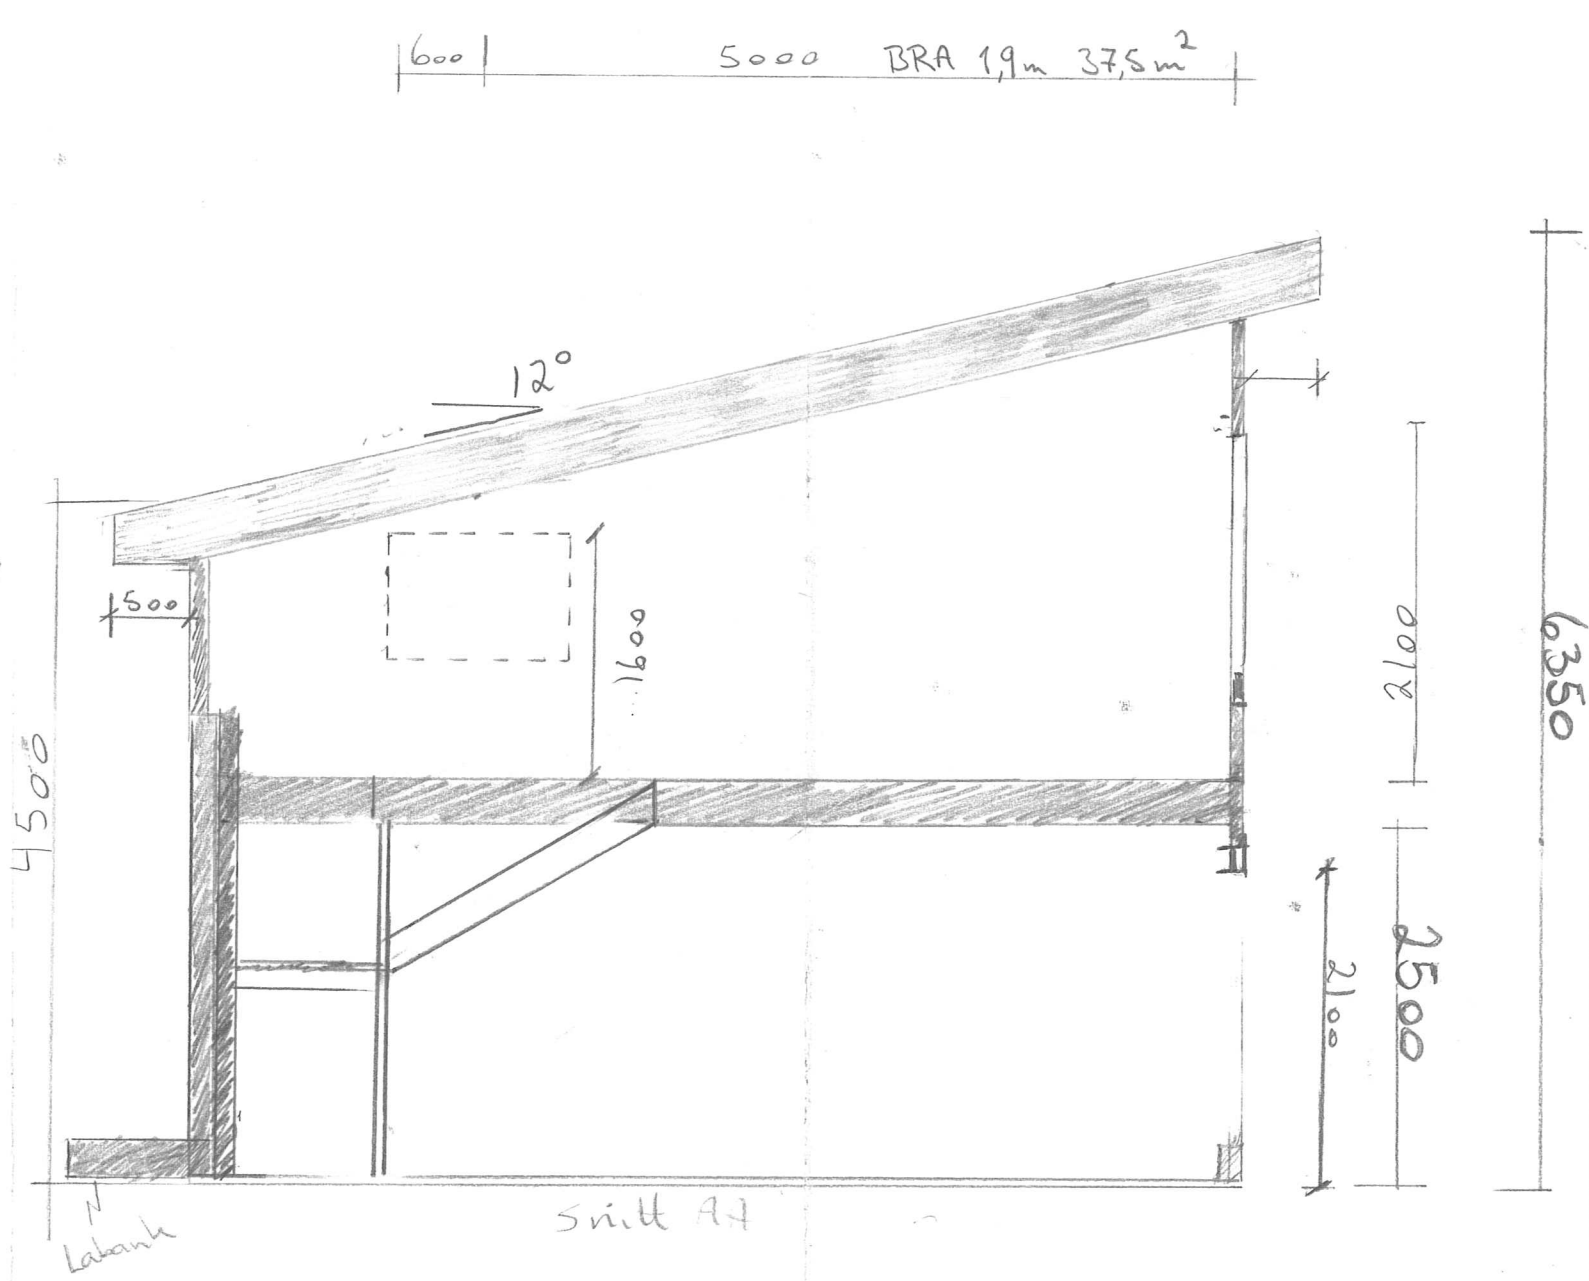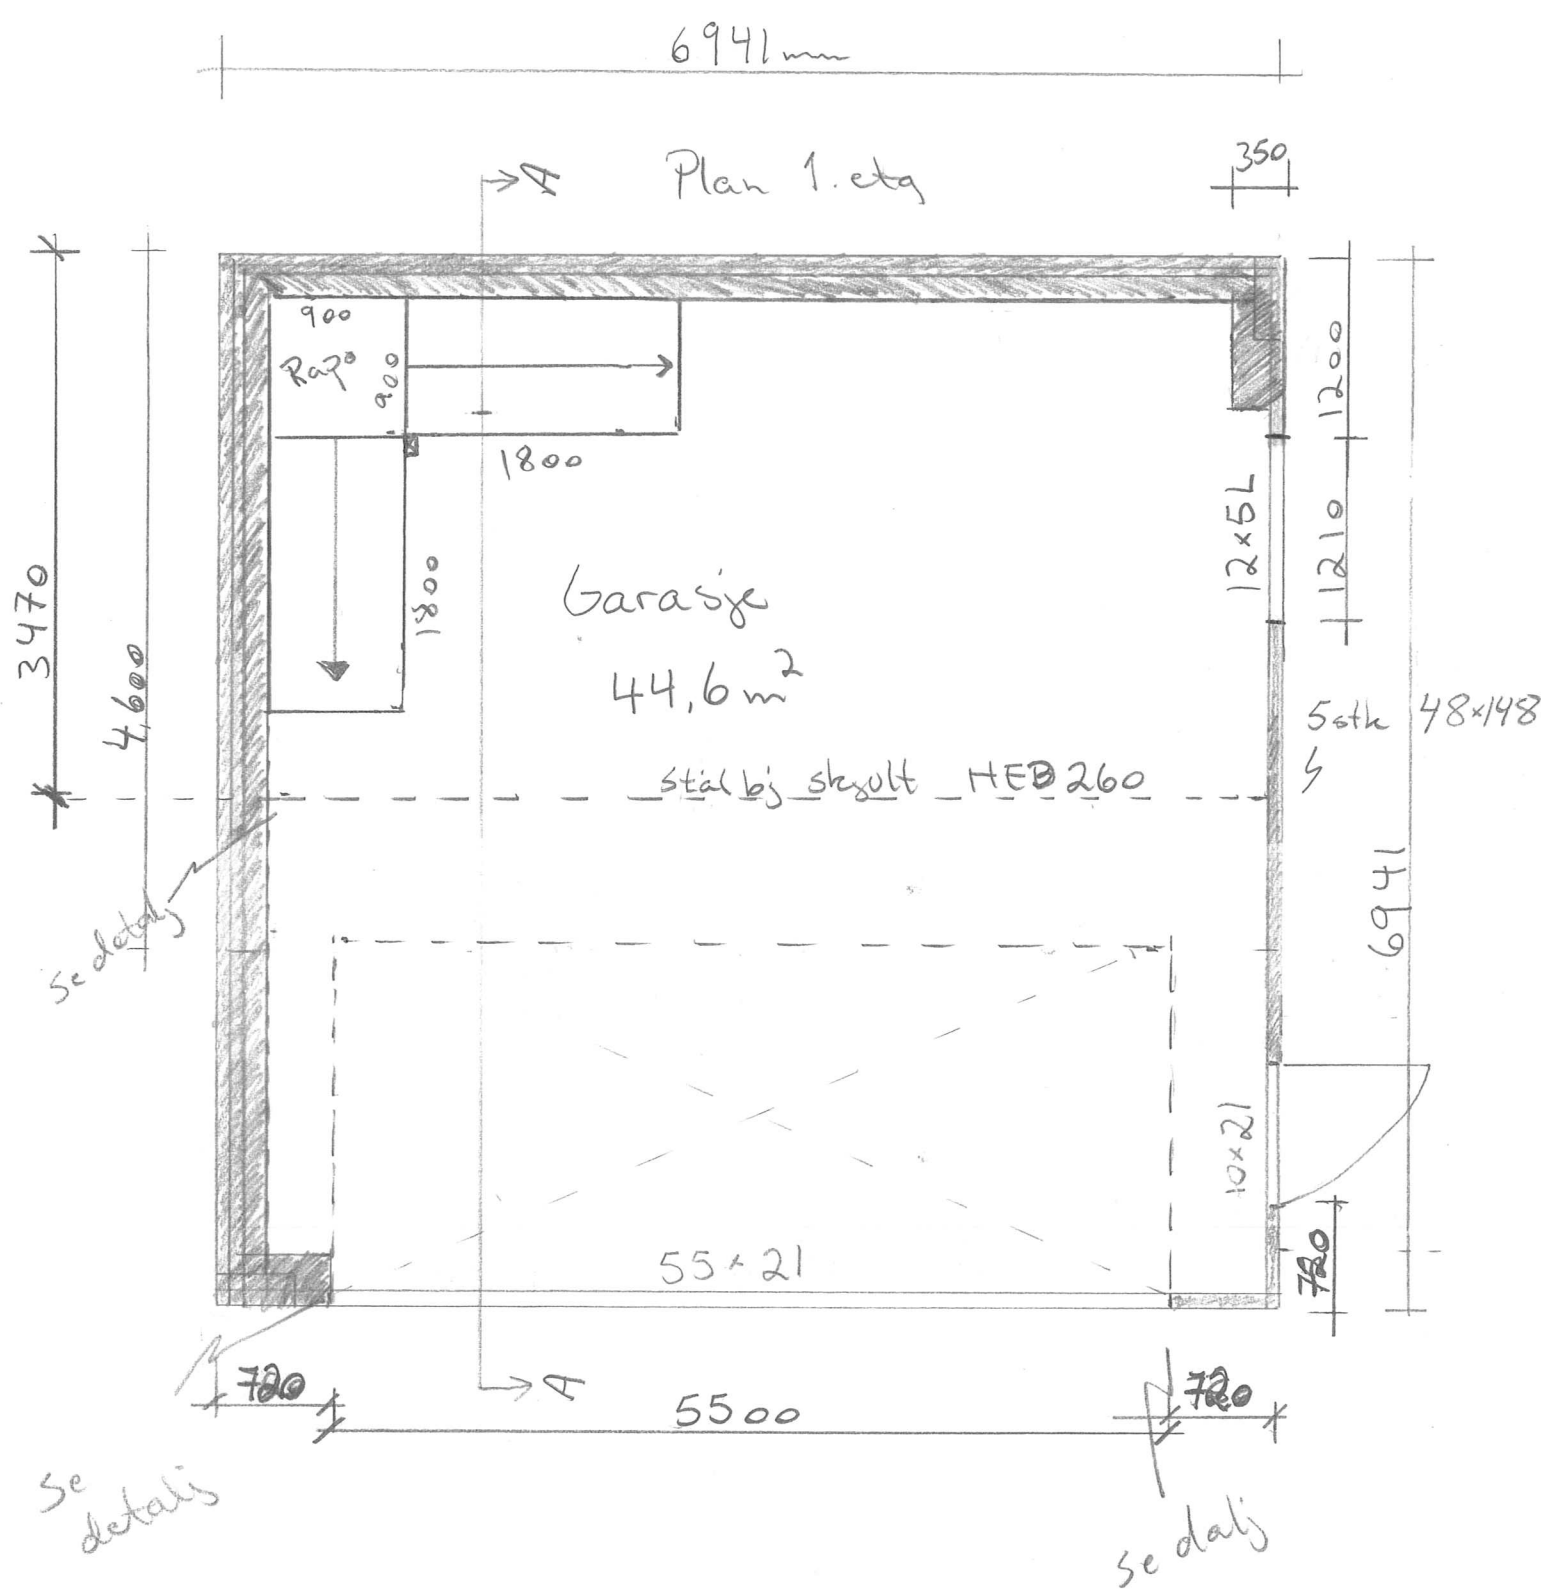

Plan, snitt garasje 1:50
 Åge Nilsen
 06.07.16 P.K
 Rev 21.04.16 senket takvinkel