



6728700

6728600

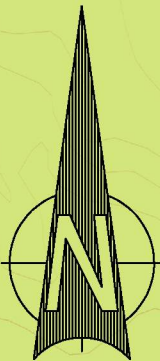

300100

300200

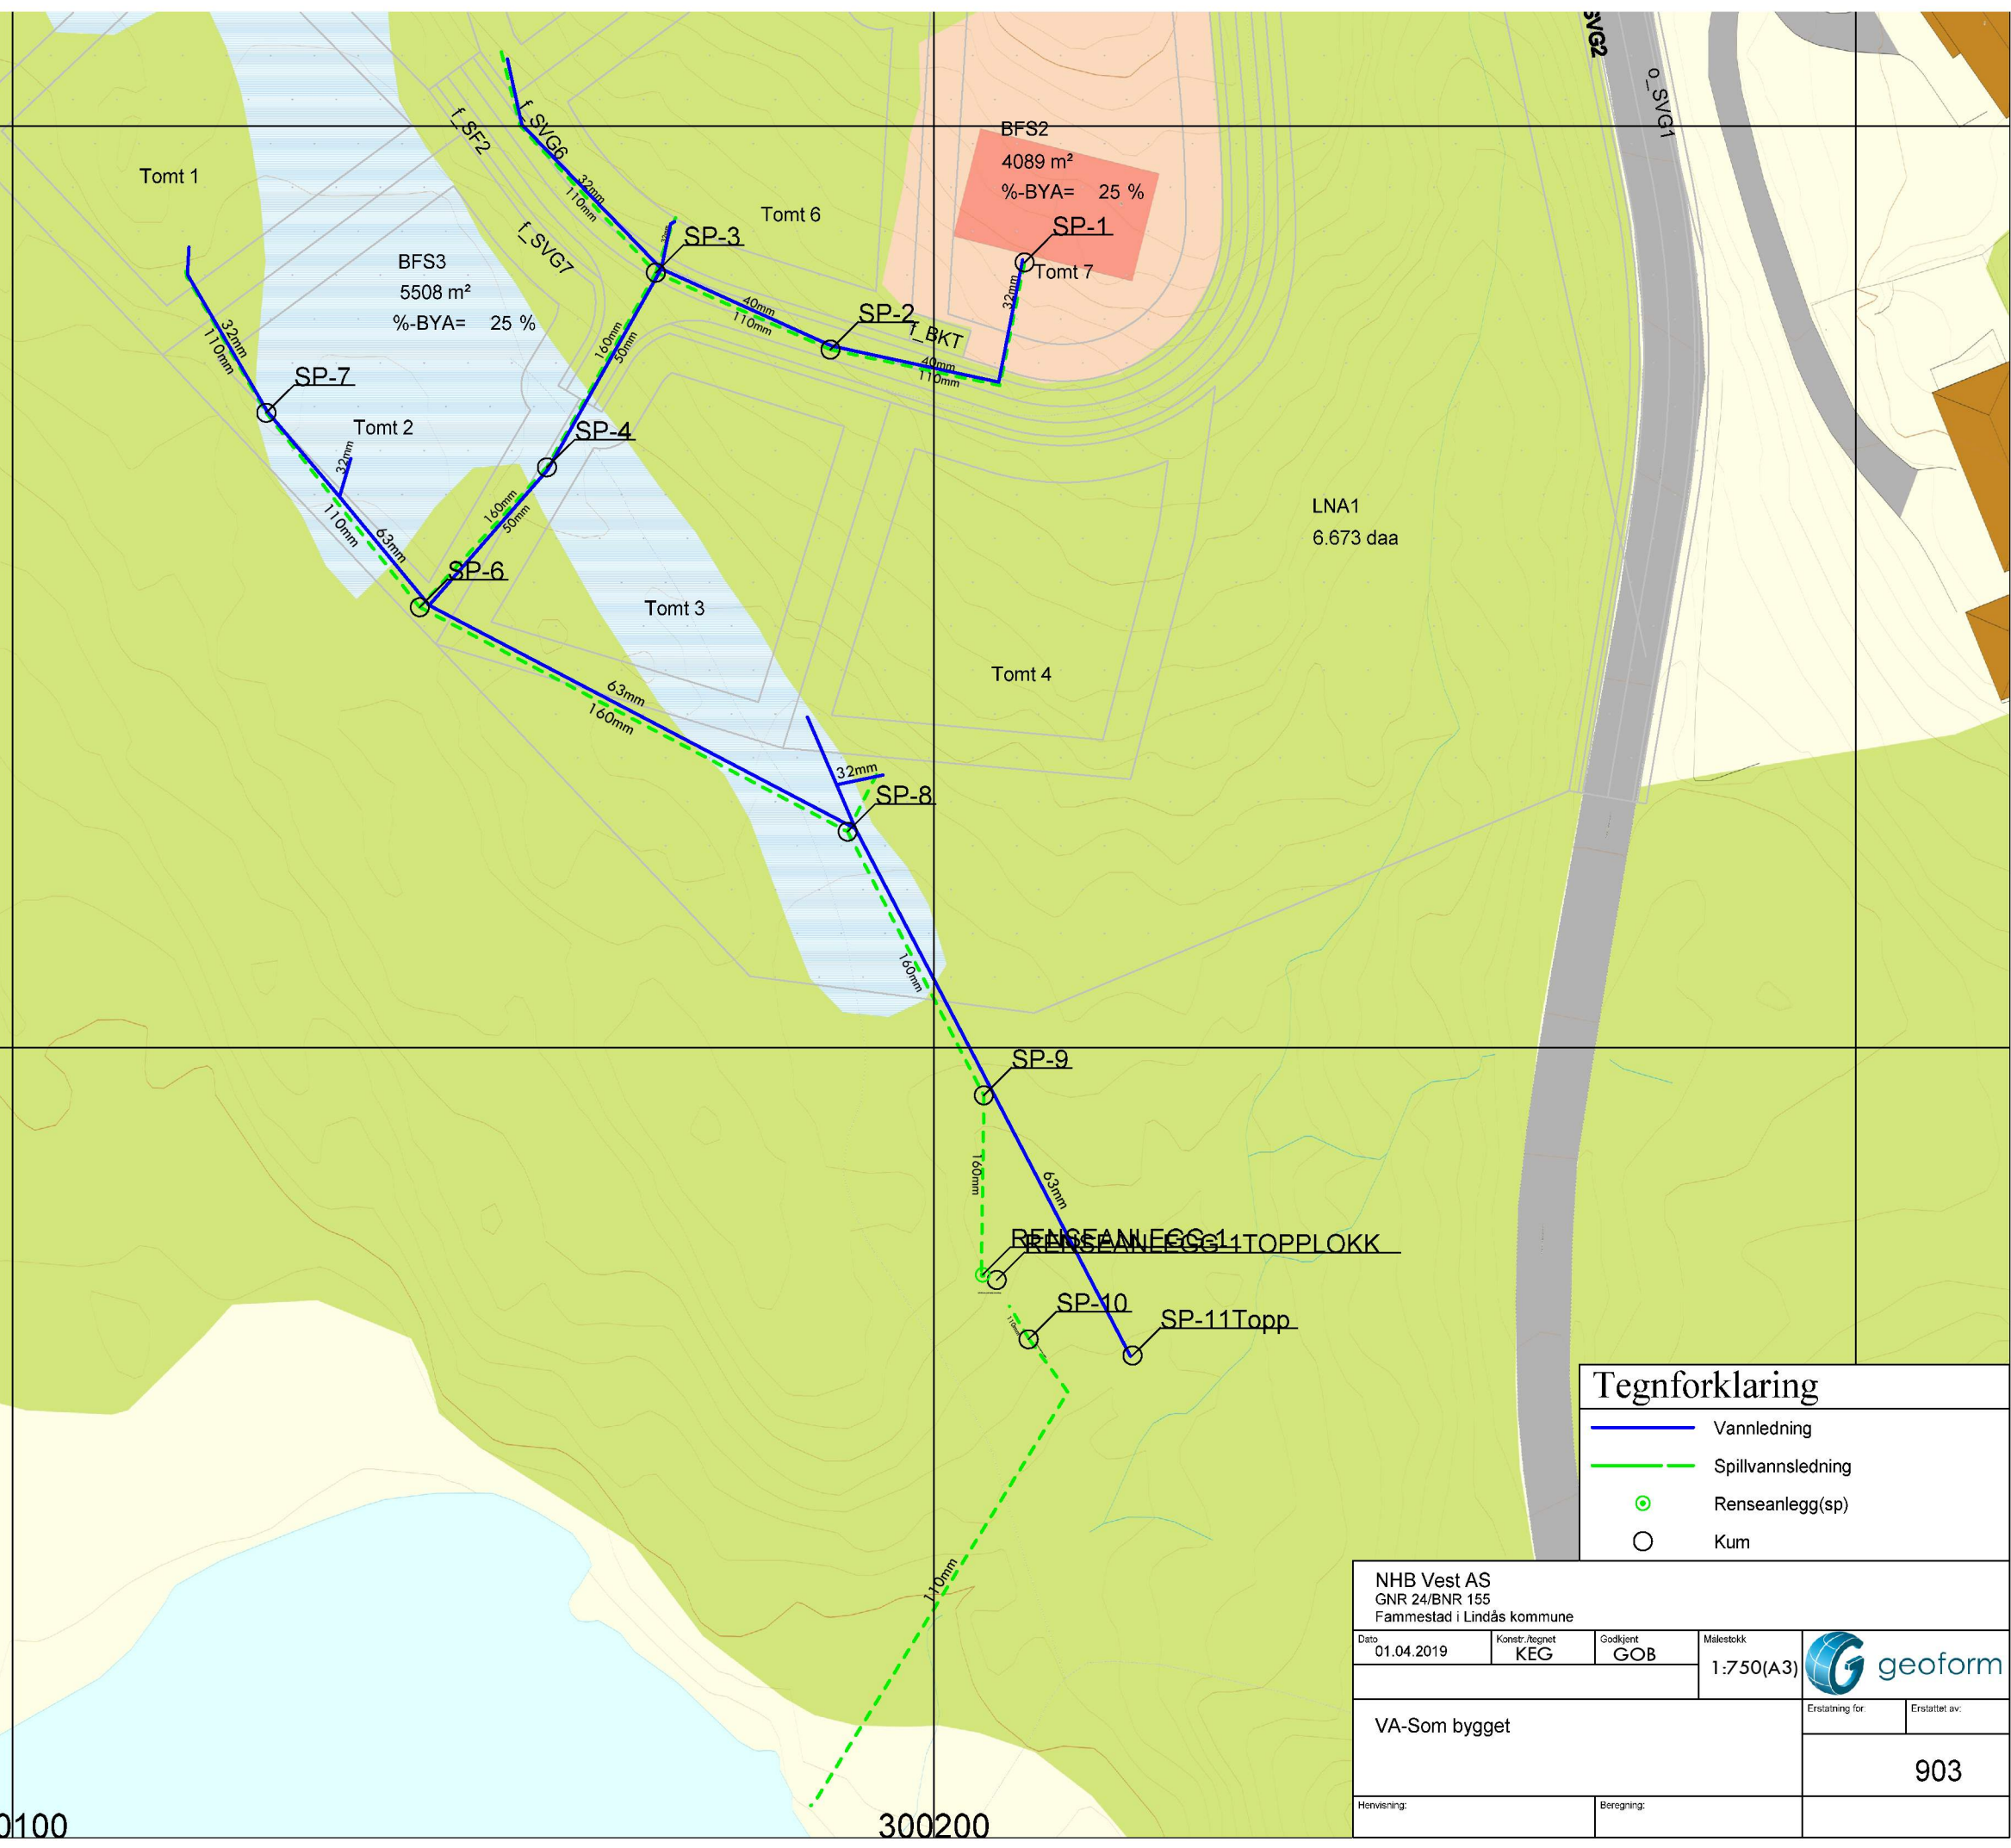

Tegnforklaring

- Vannledning
- - - Spillvannsledning
- Renseanlegg(sp)
- Kum

NHB Vest AS GNR 24/BNR 155 Fammestad i Lindås kommune			
Dato 01.04.2019	Konstr./Aegnet KEG	Godkjent GOB	Målestokk 1:750(A3)
VA-Som bygget			Erstattet av: 903
Henvening:	Beregning:		

