


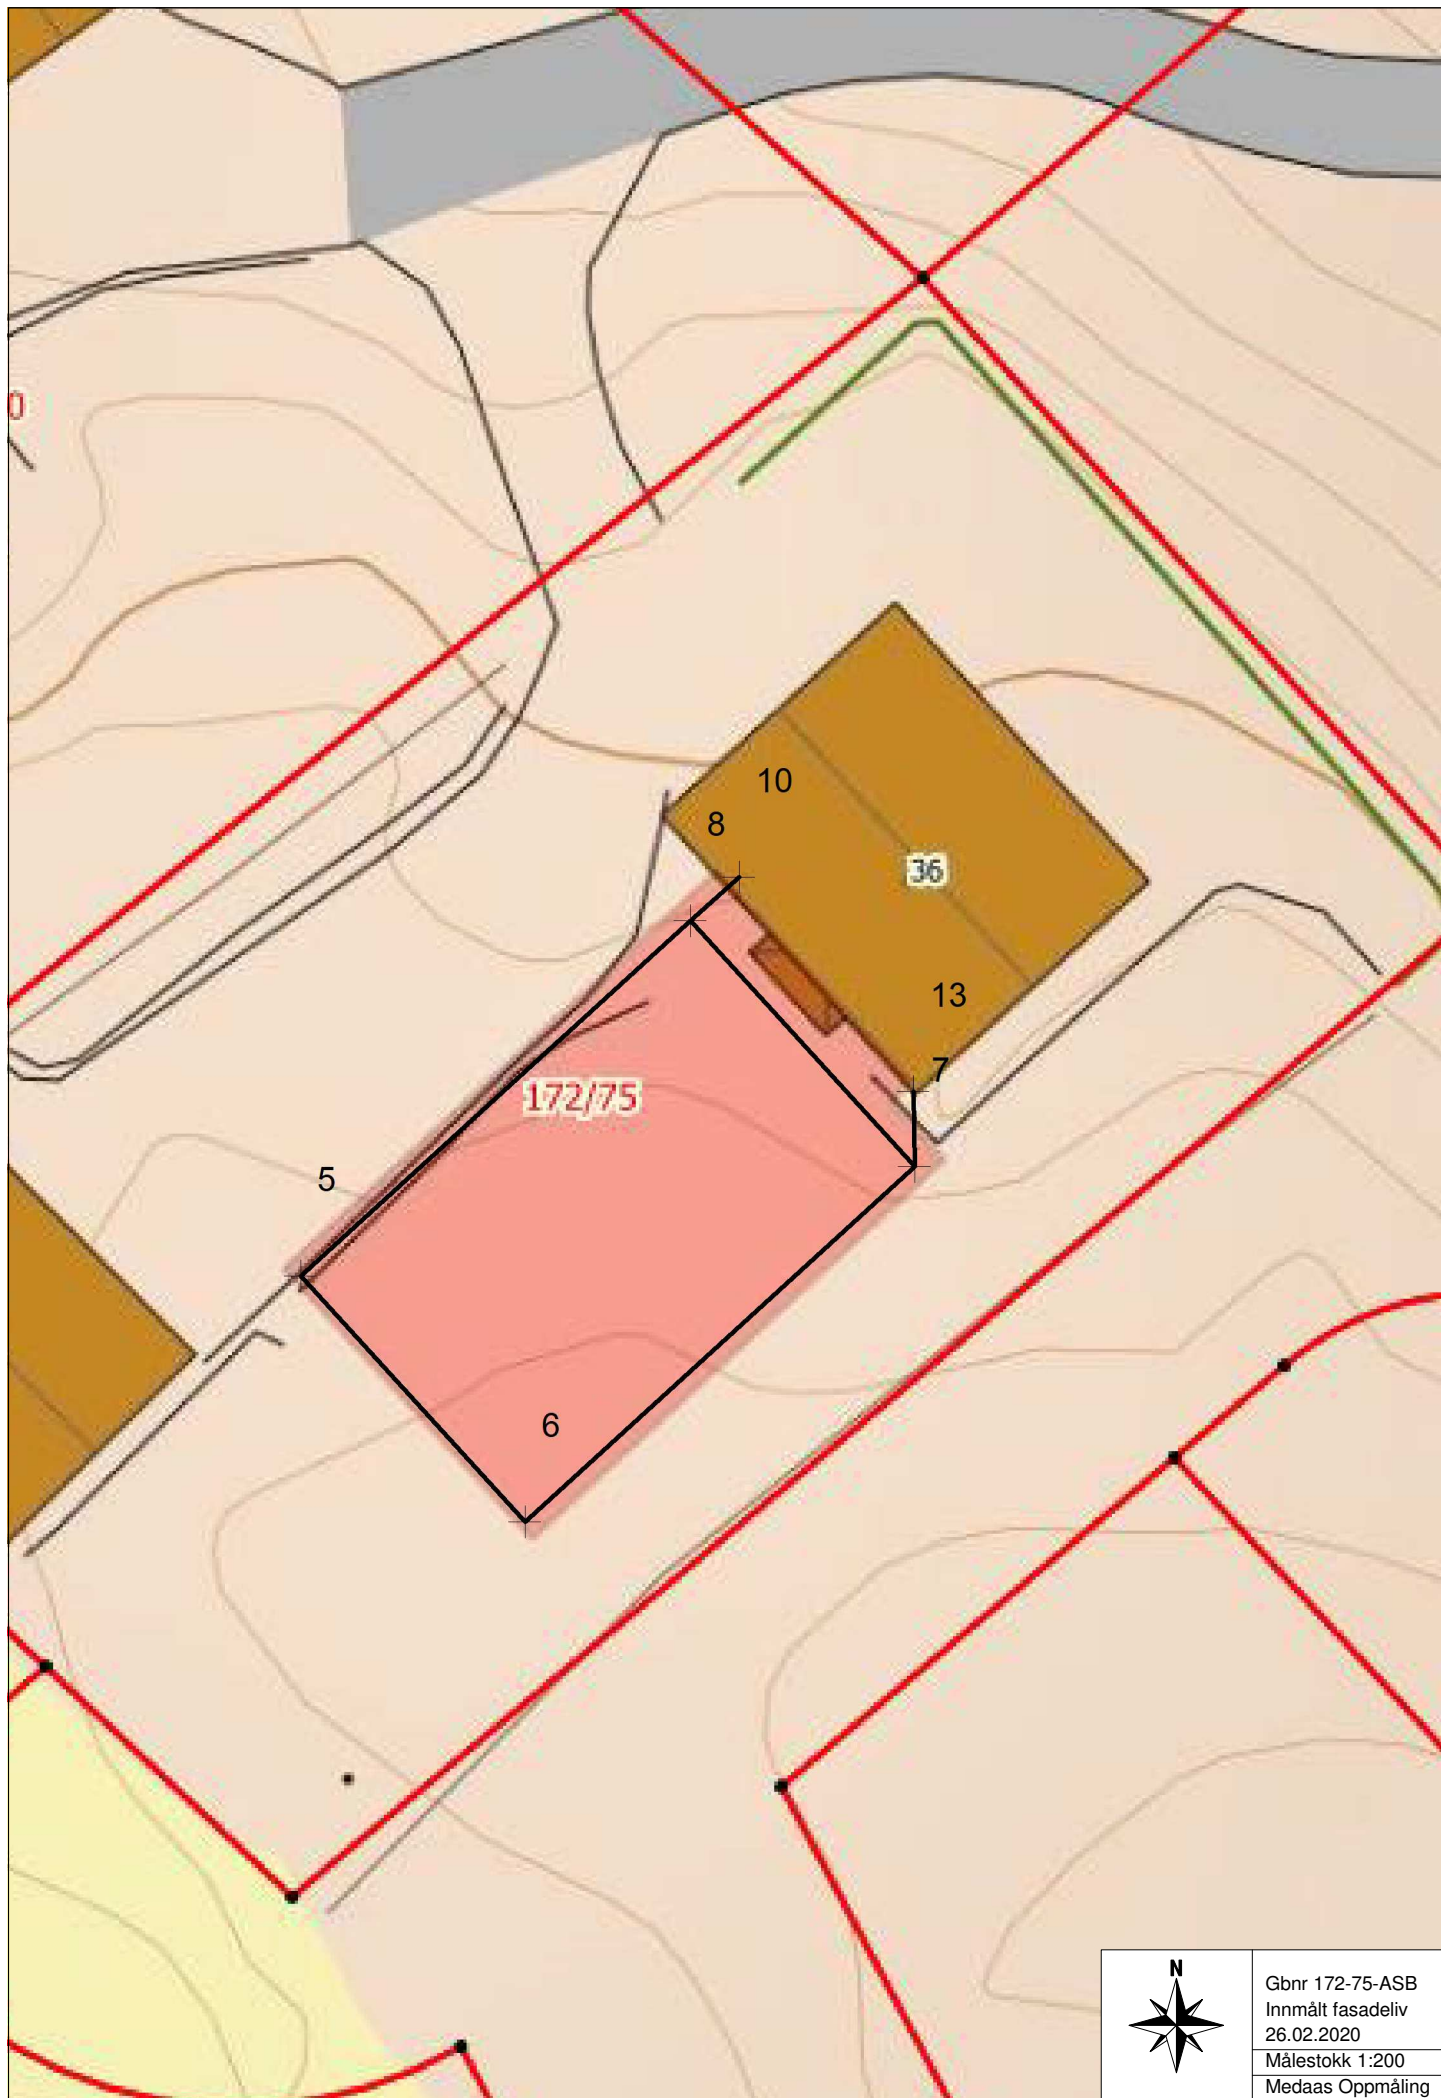

Gbnr 172-75-ASB
Innmålt fasadeliv
26.02.2020
Målestokk 1:200
Medaas Oppmåling