
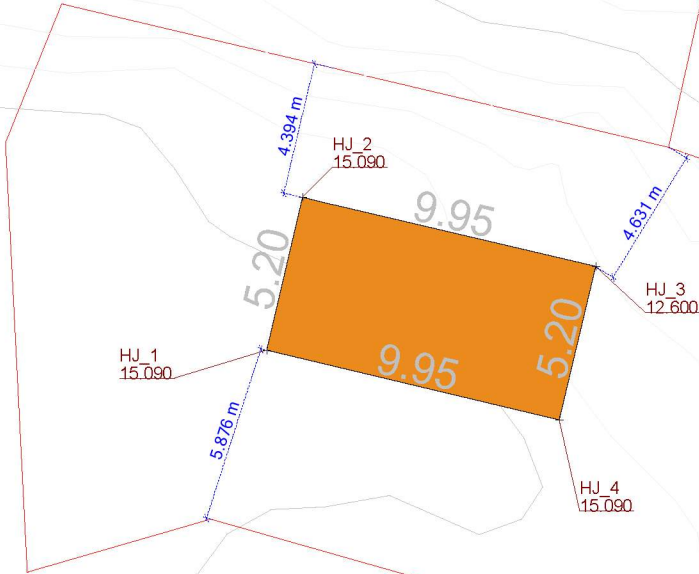


6723350

289200

289

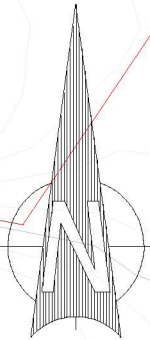

Mjåtveit Terrasse				
Dato	Konstr./tegnet	Godkjent	Målestokk	 Epost: post@sh-oppmaling.no Tlf 472 99 092
10.07.2019	sh		1:250	
Innmålt grunnmur ny hytte Gnr 38, bnr 89 Refskar 20, 5919 FREKHAUG				Erstatning for:
				Erstattet av: 911
Henvisning:		Beregning:		Meland kommune