


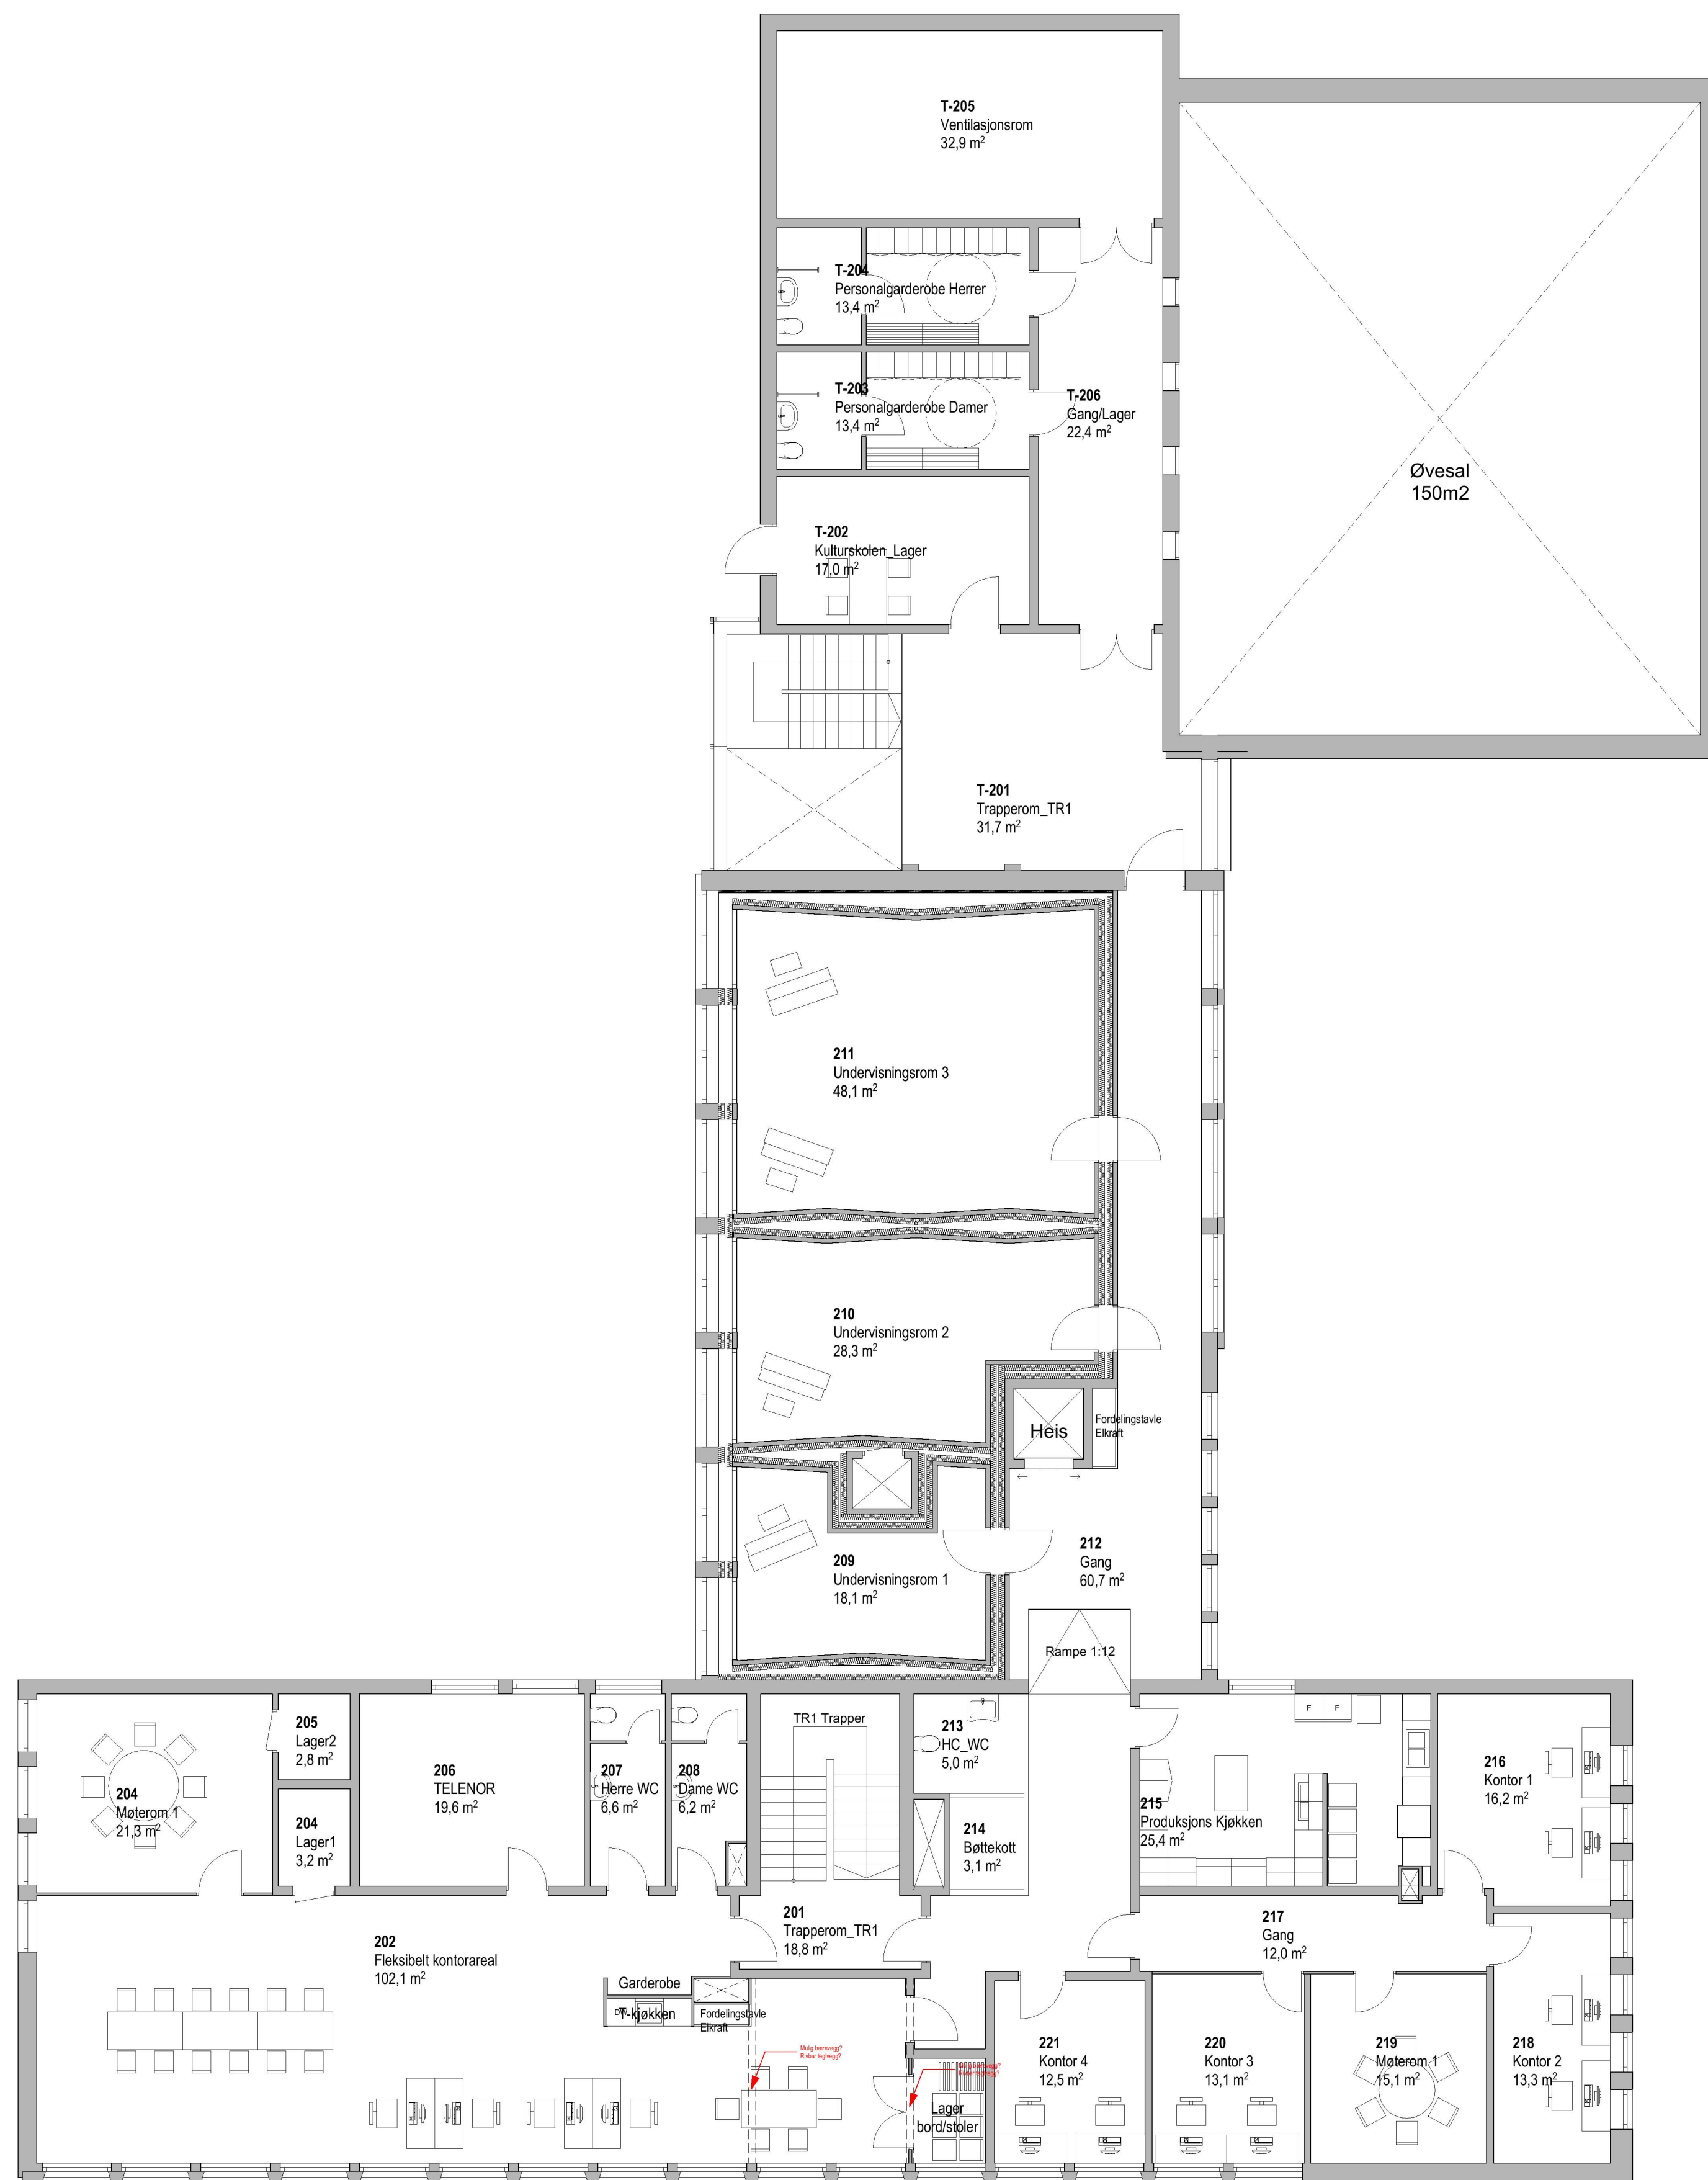

A22-103