




2,90
Fasade mot SØ

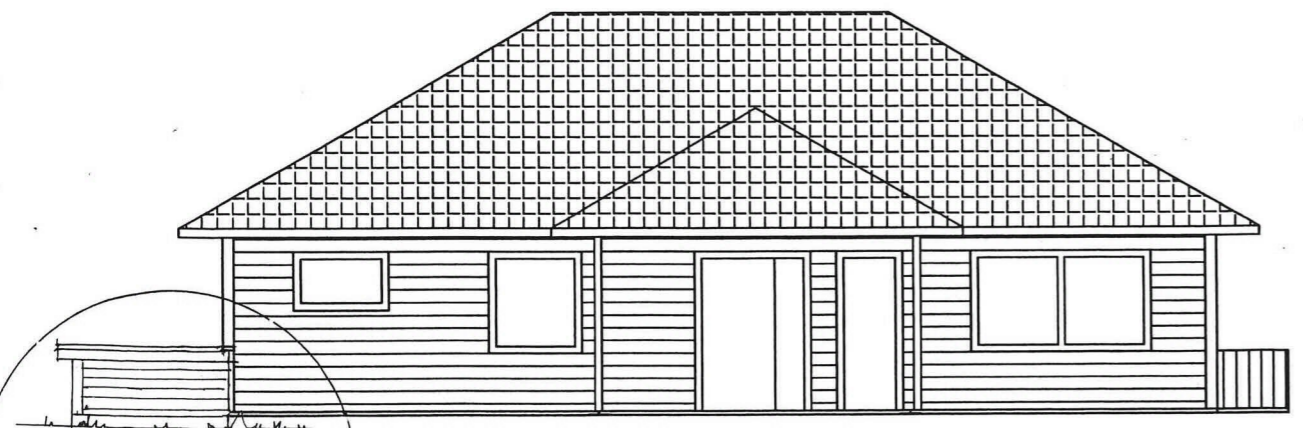

1,90
Fasade mot SV





1,90
Fasade mot NØ

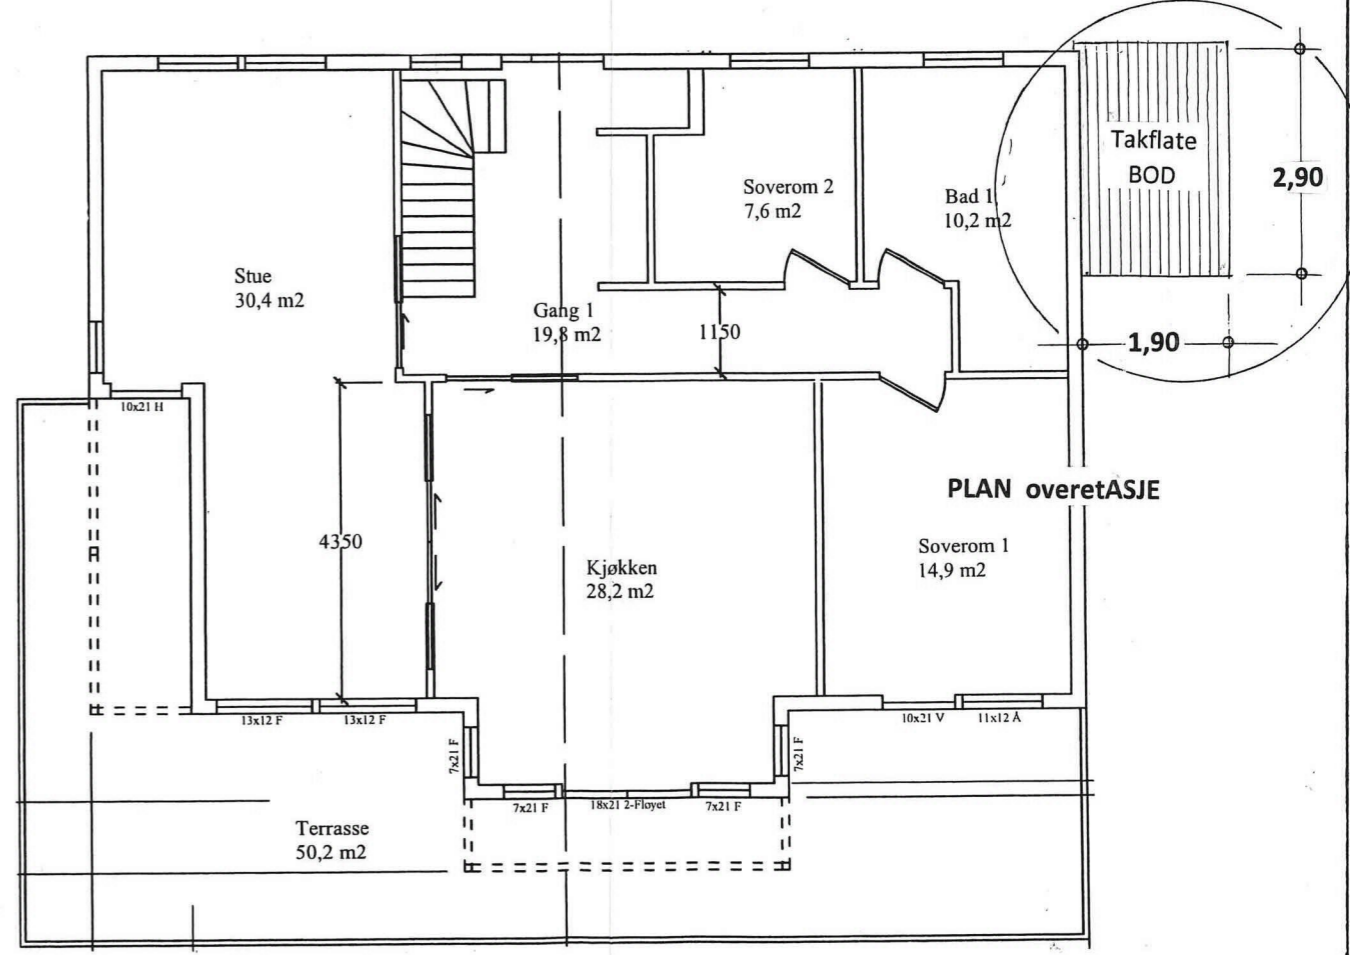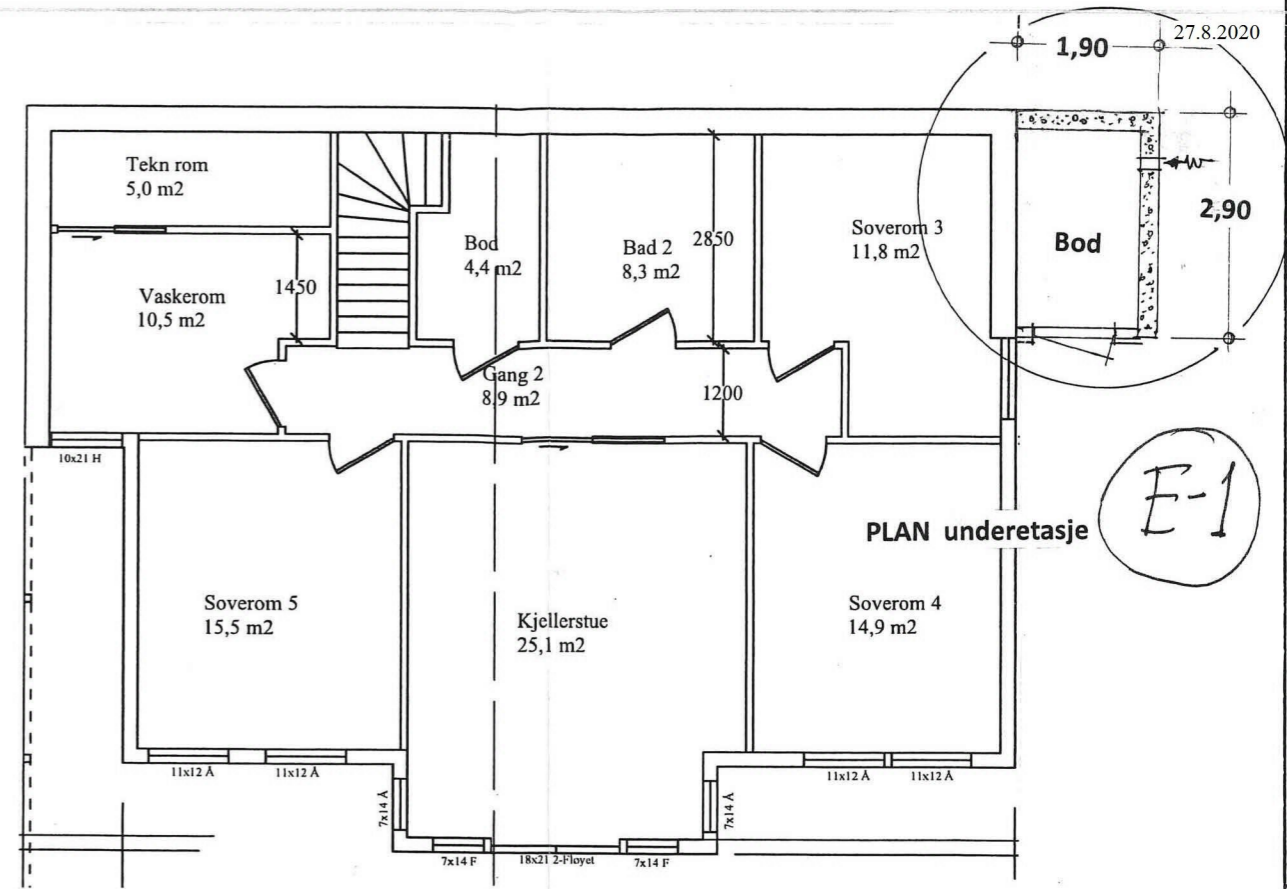

Prosj. BODTILBYGG - 5,5 m², Helleåsen 24, 5915 Hjelmås, gnr. 202, bnr. 160 i Alver kommune
Planer – og fasader i Mål = 1 : 100, Snitt i Mål = 1 : 50

Hjelmås, 11. 06. 2020, Daniel Reknes

E-2

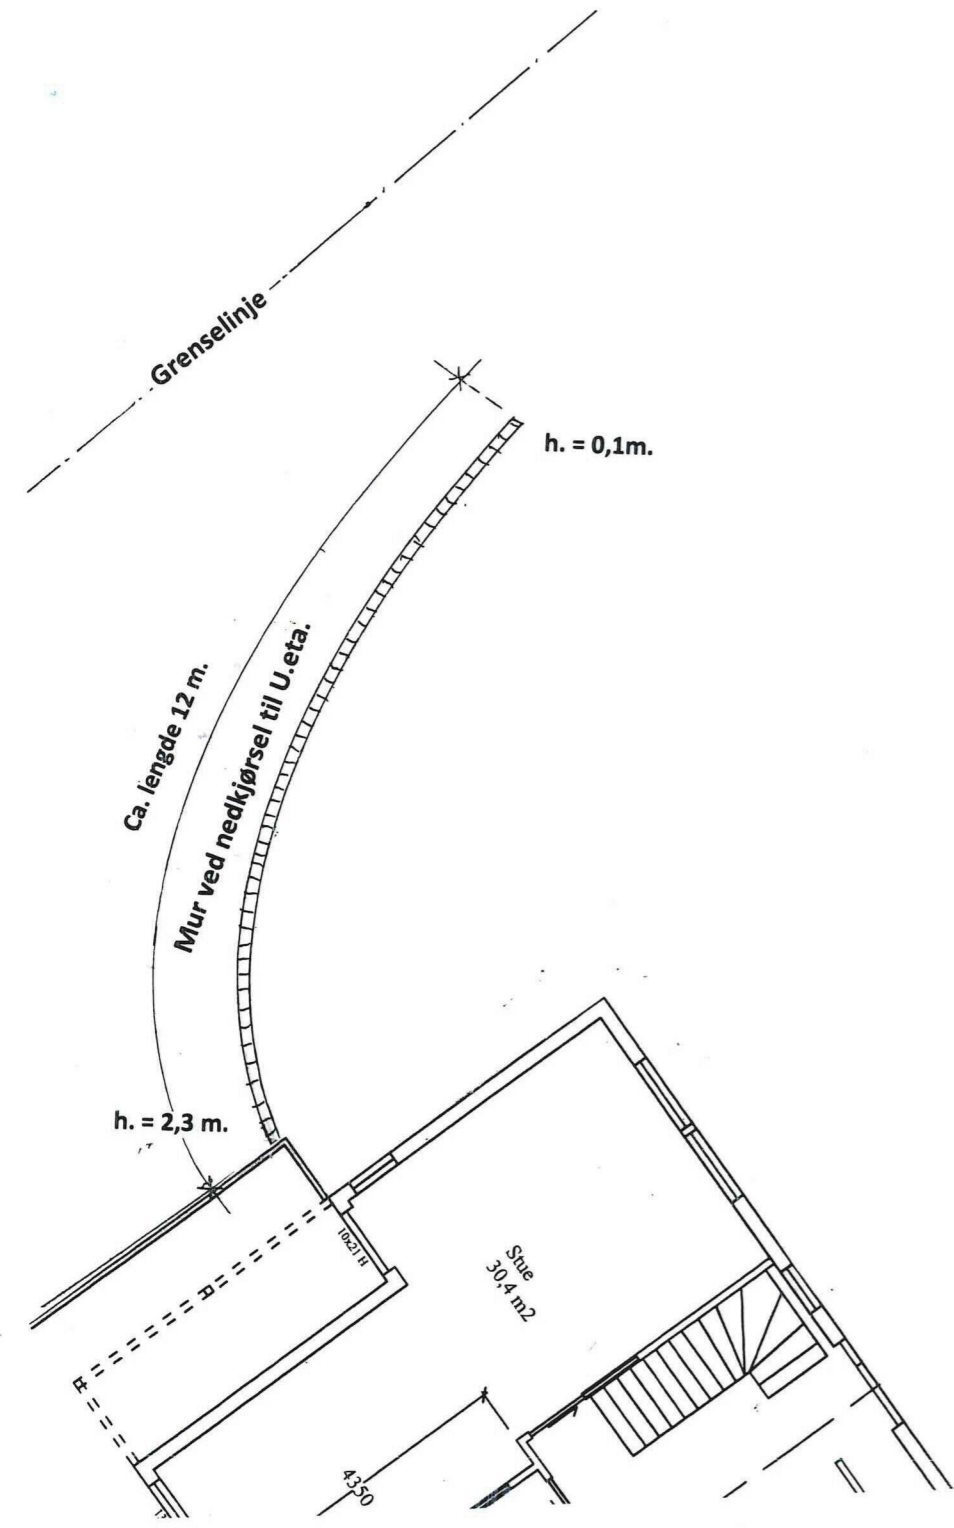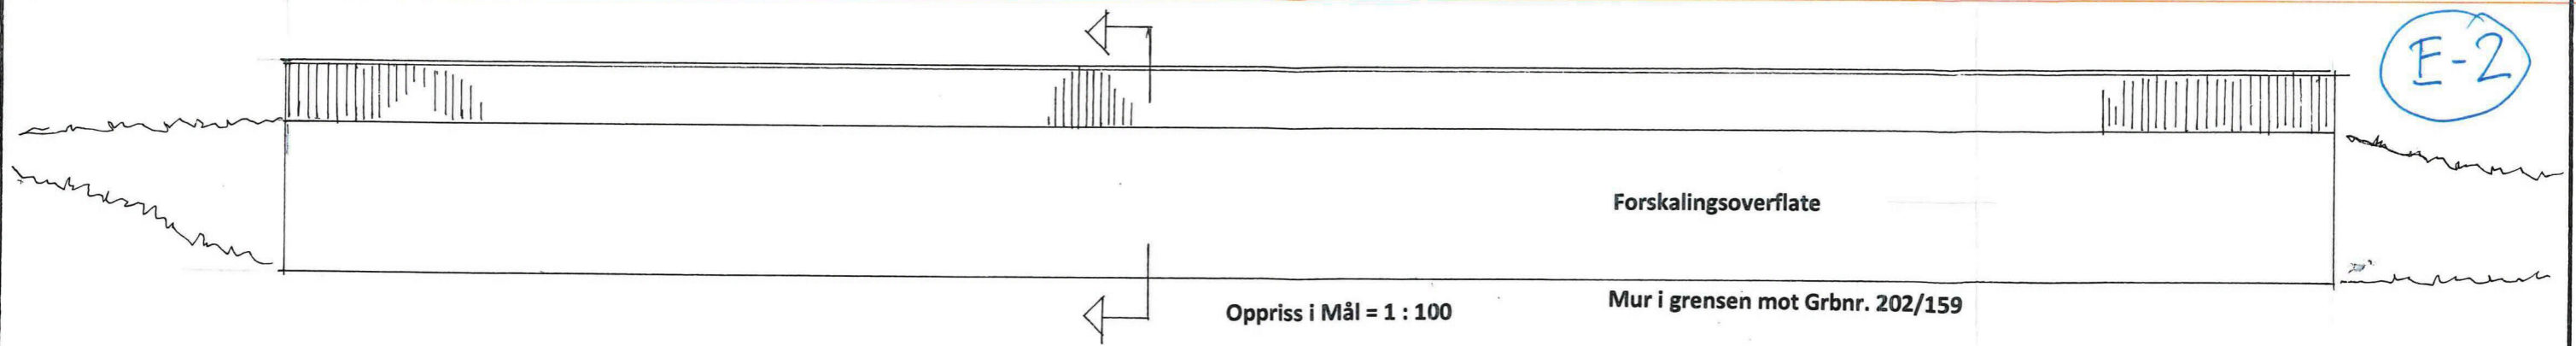

Prosj. Forstøtningsmurer på Helleåsen 24, Hjelmås, gnbr. 202, bnr. 160 i Alver kommune

Mål = 1:100, 1:50

Hjelmås, 11. 06.2020, Daniel Reknes