


Fasade mot sørvest  
1 : 100

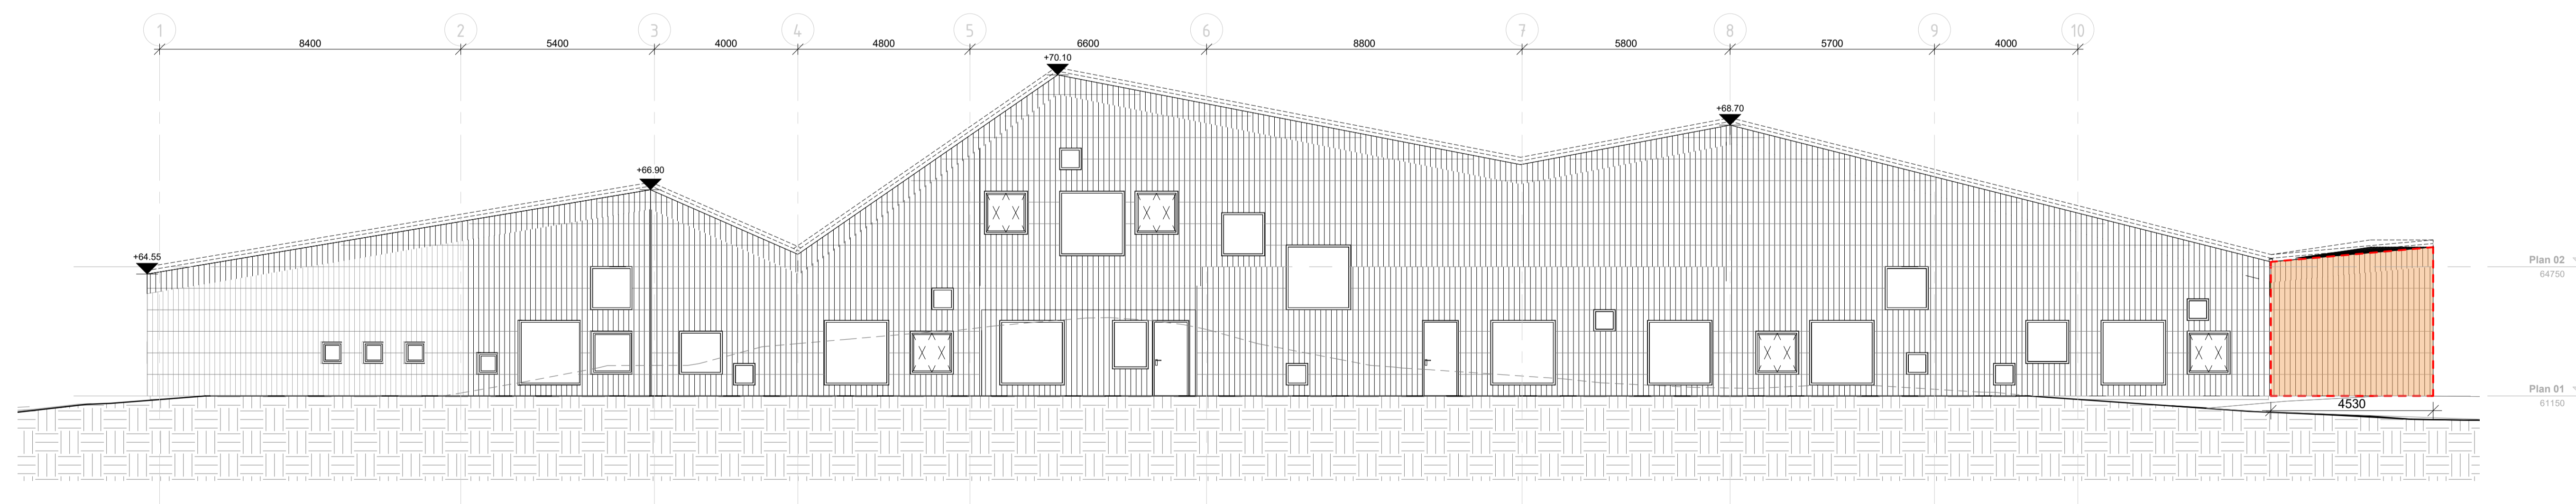

Fasade mot nordvest  
1 : 100