


Norbert Tjore - gbnr 79/21- Mulig gangveg 24.06.2015

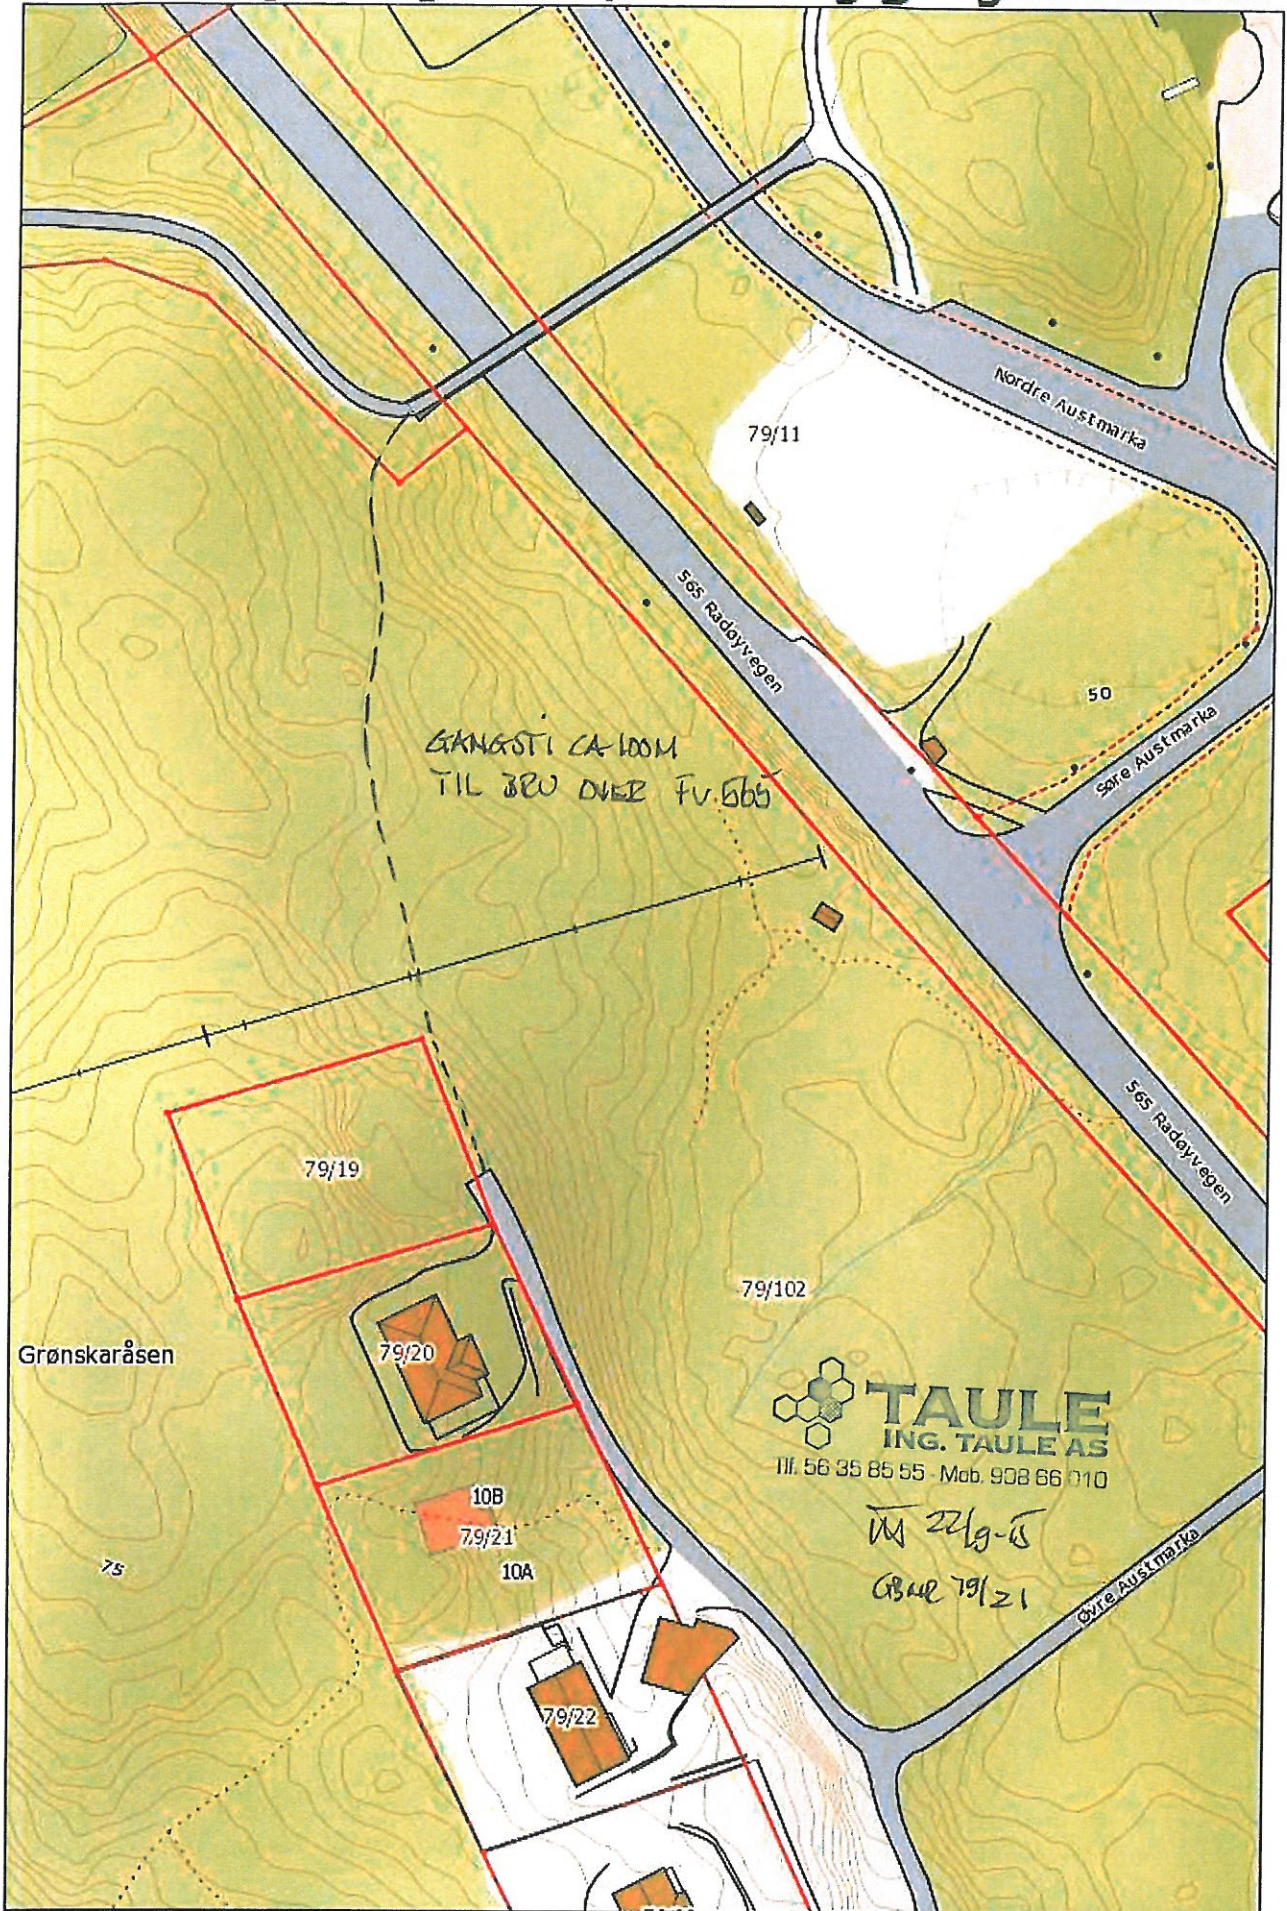

Målestokk: 1:1 000