
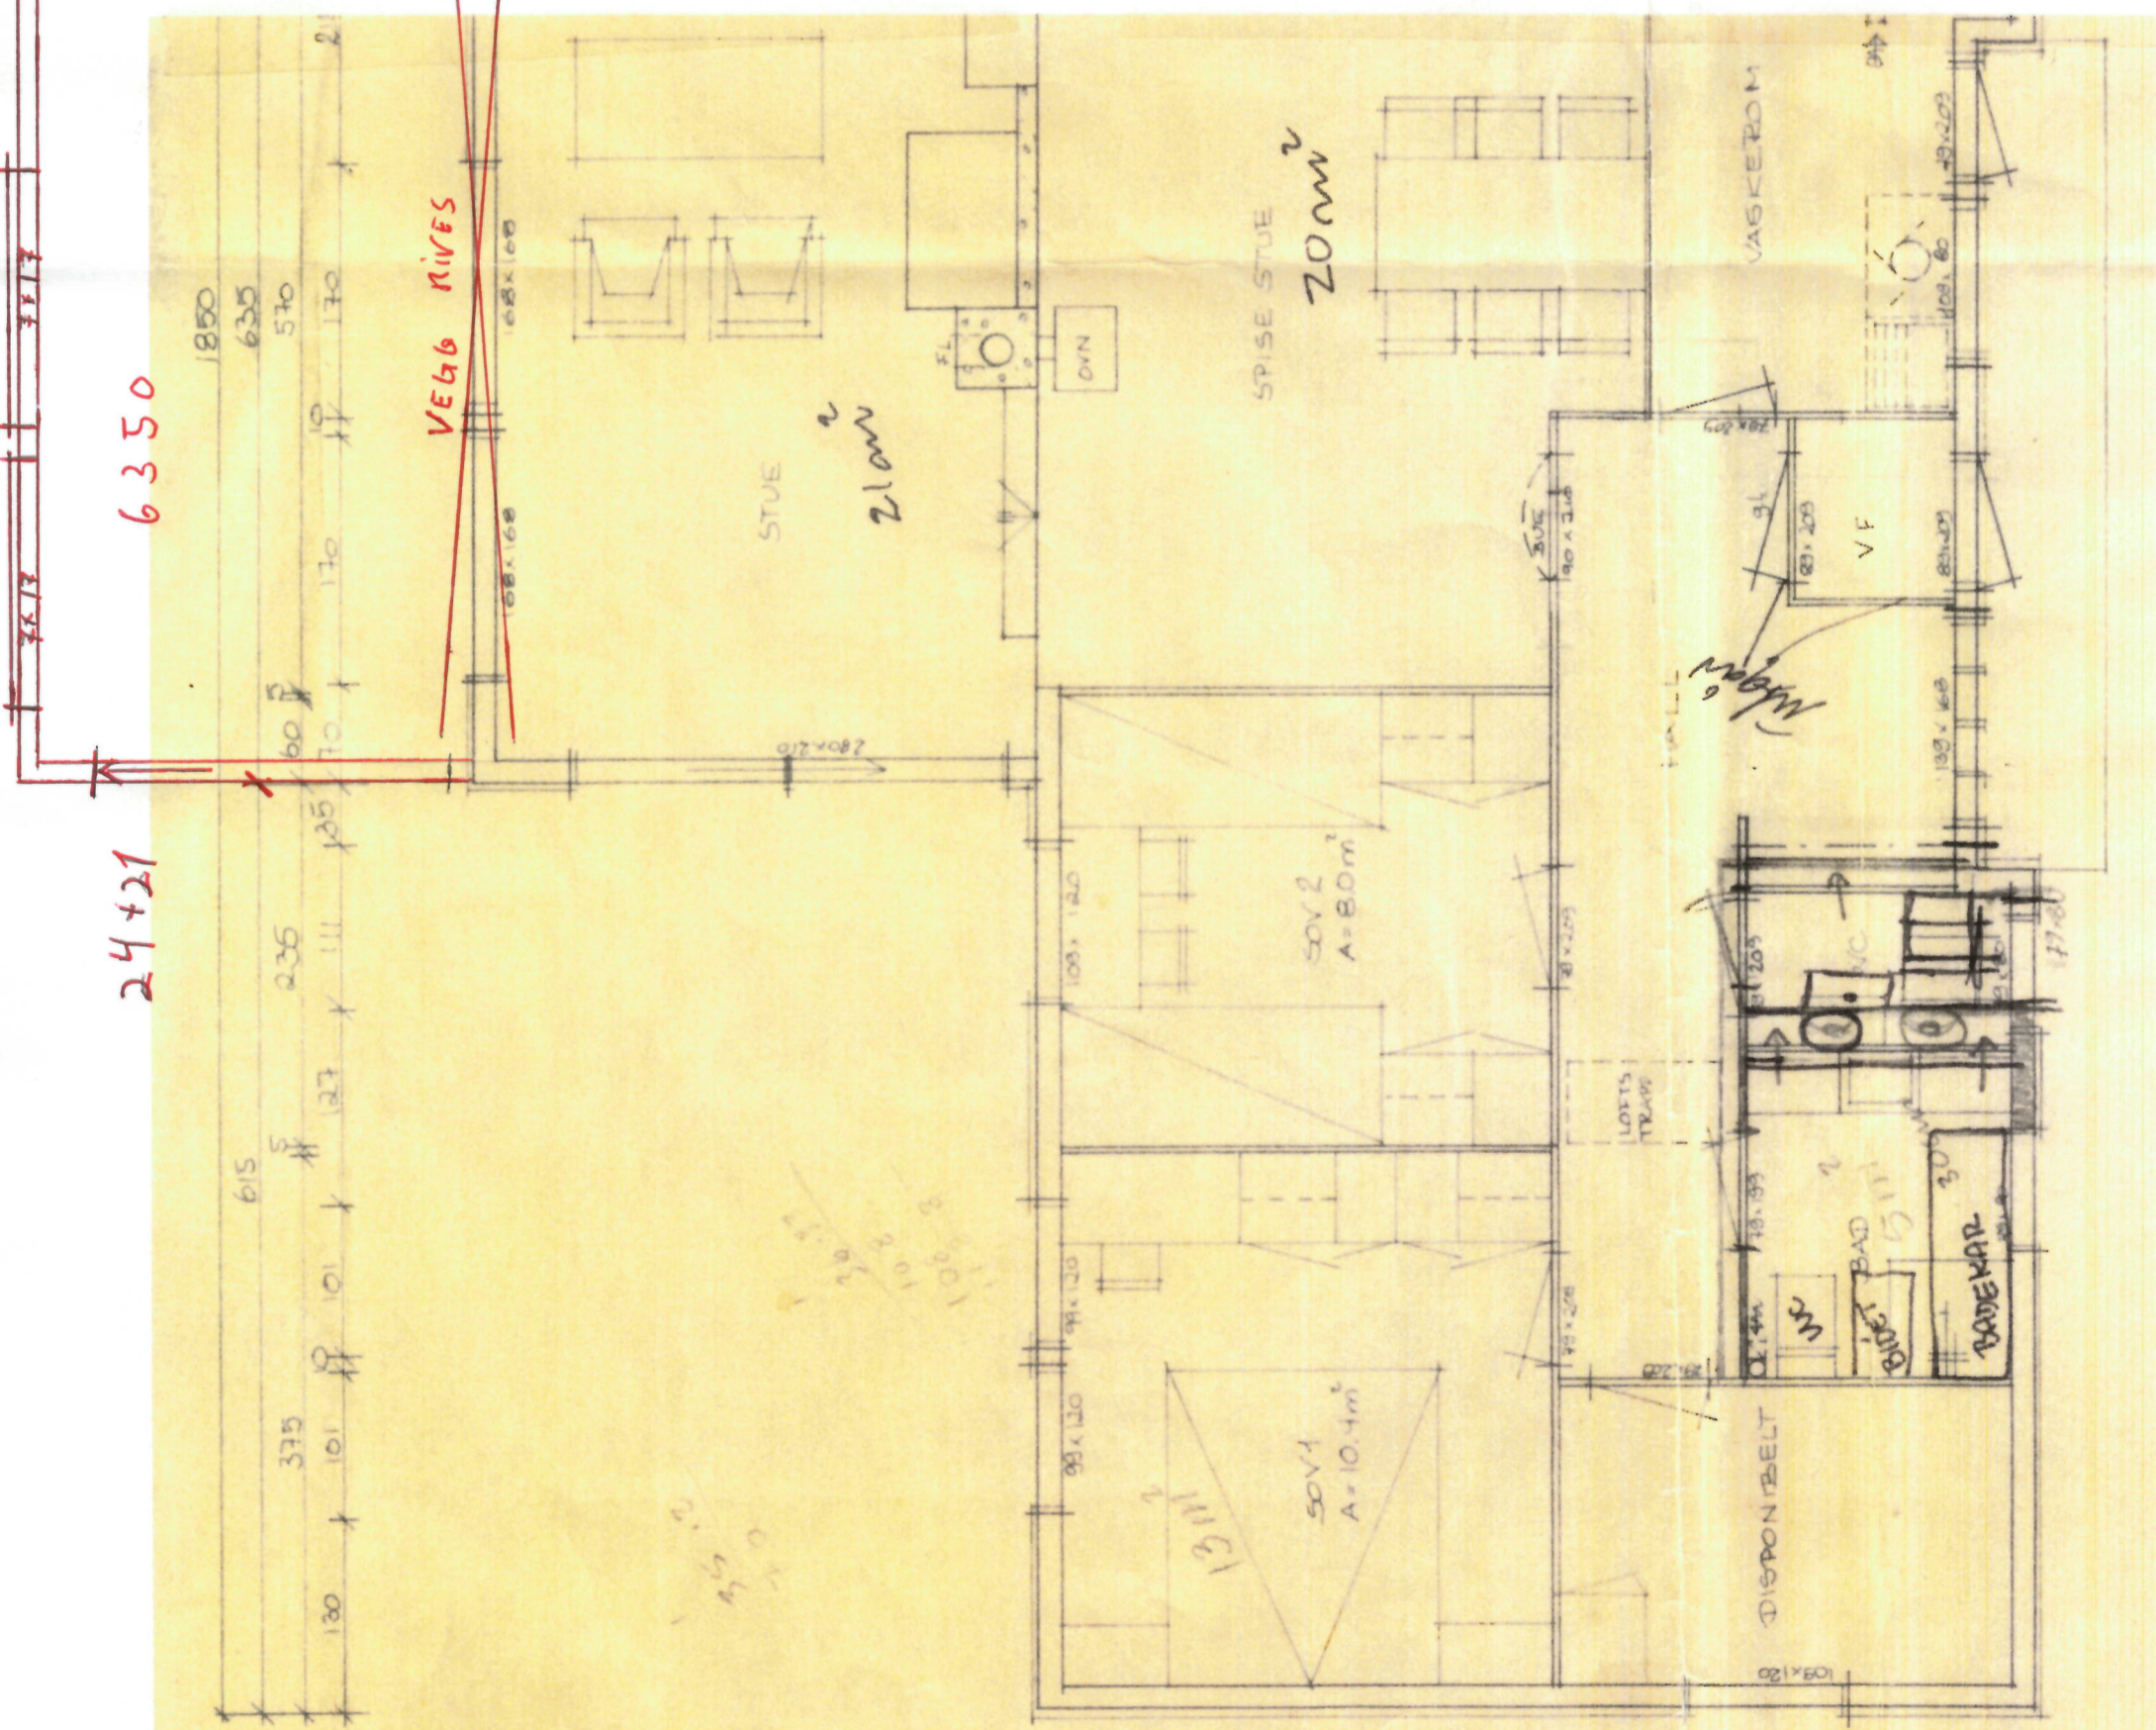


+ 3000 +


1:50

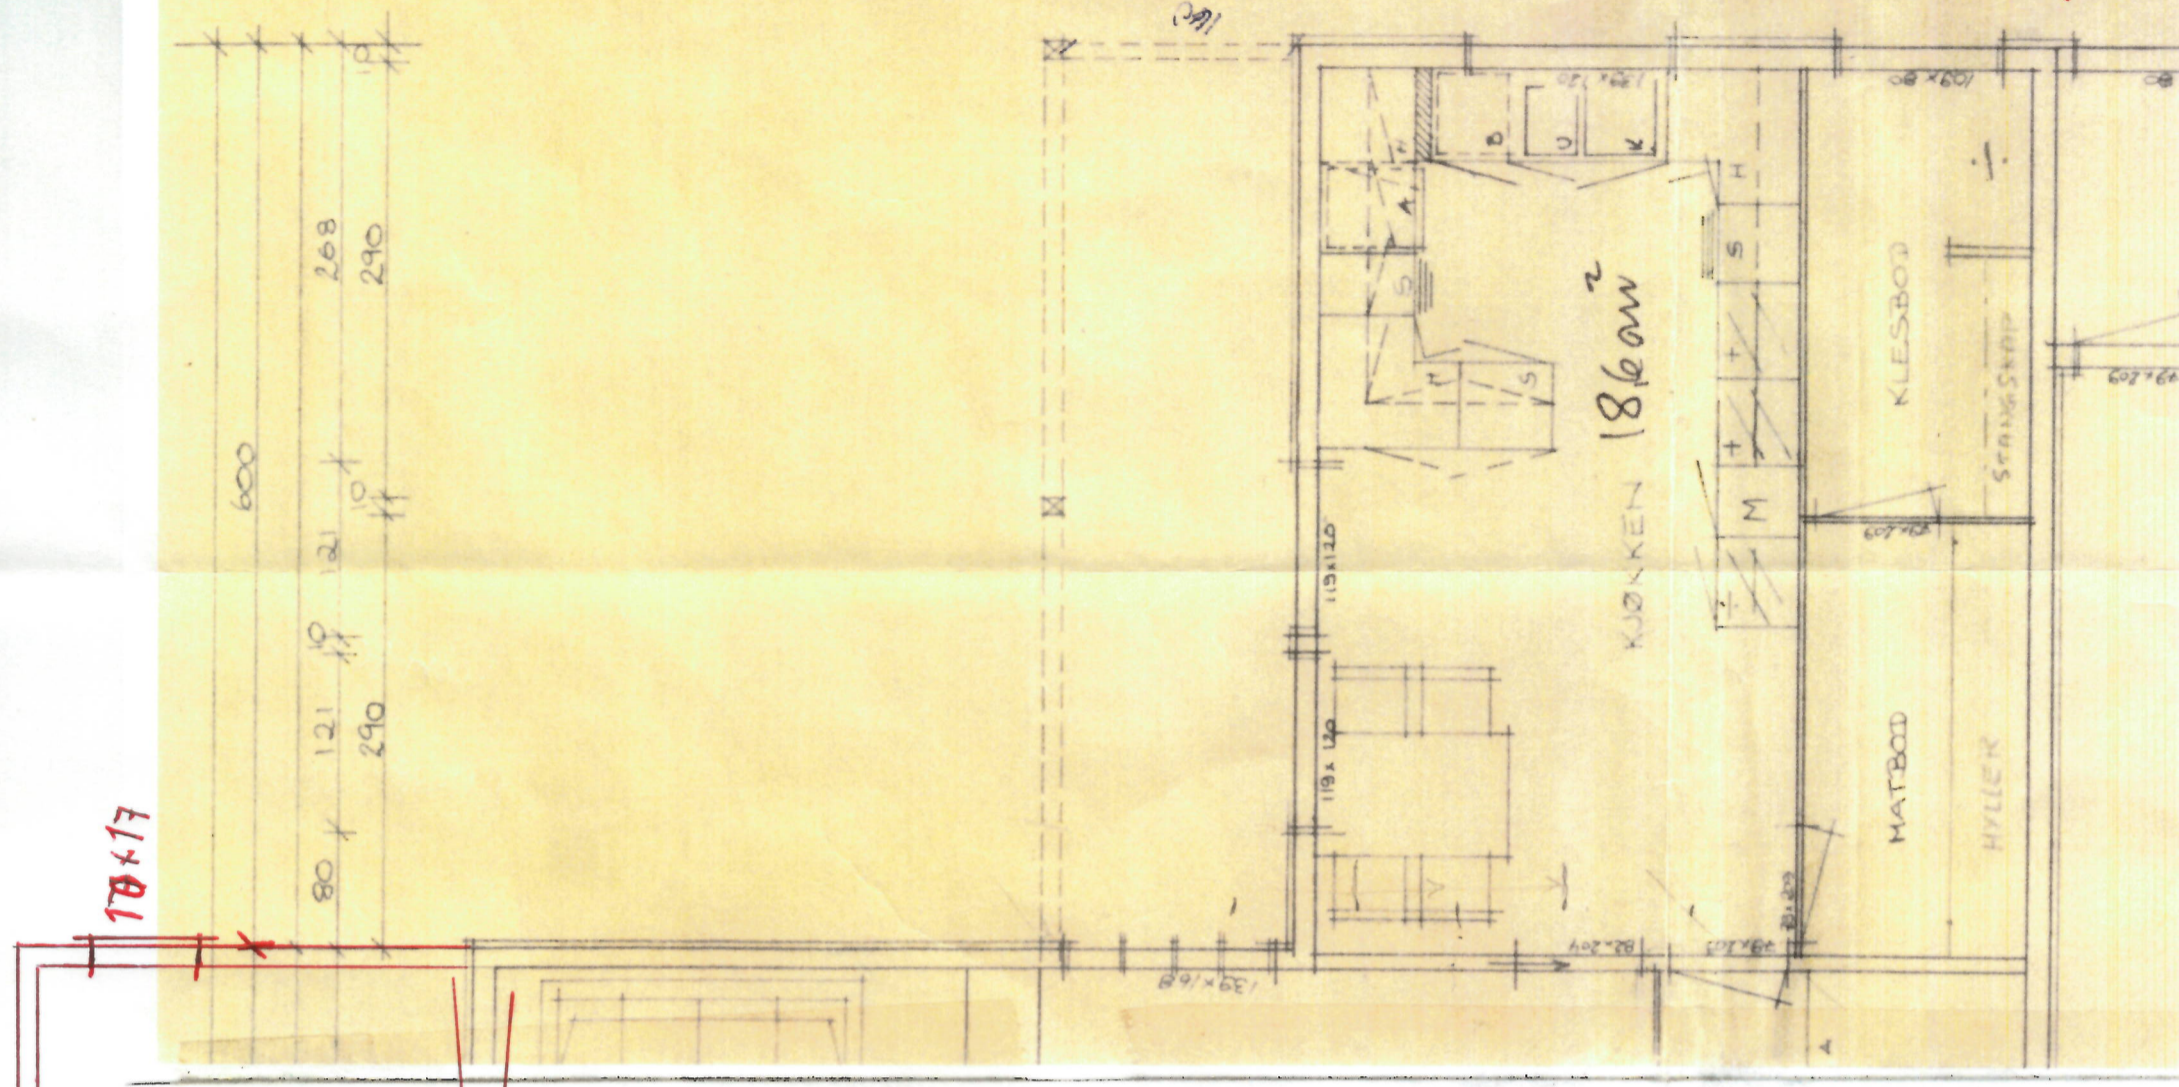

170x17

6350

24+21

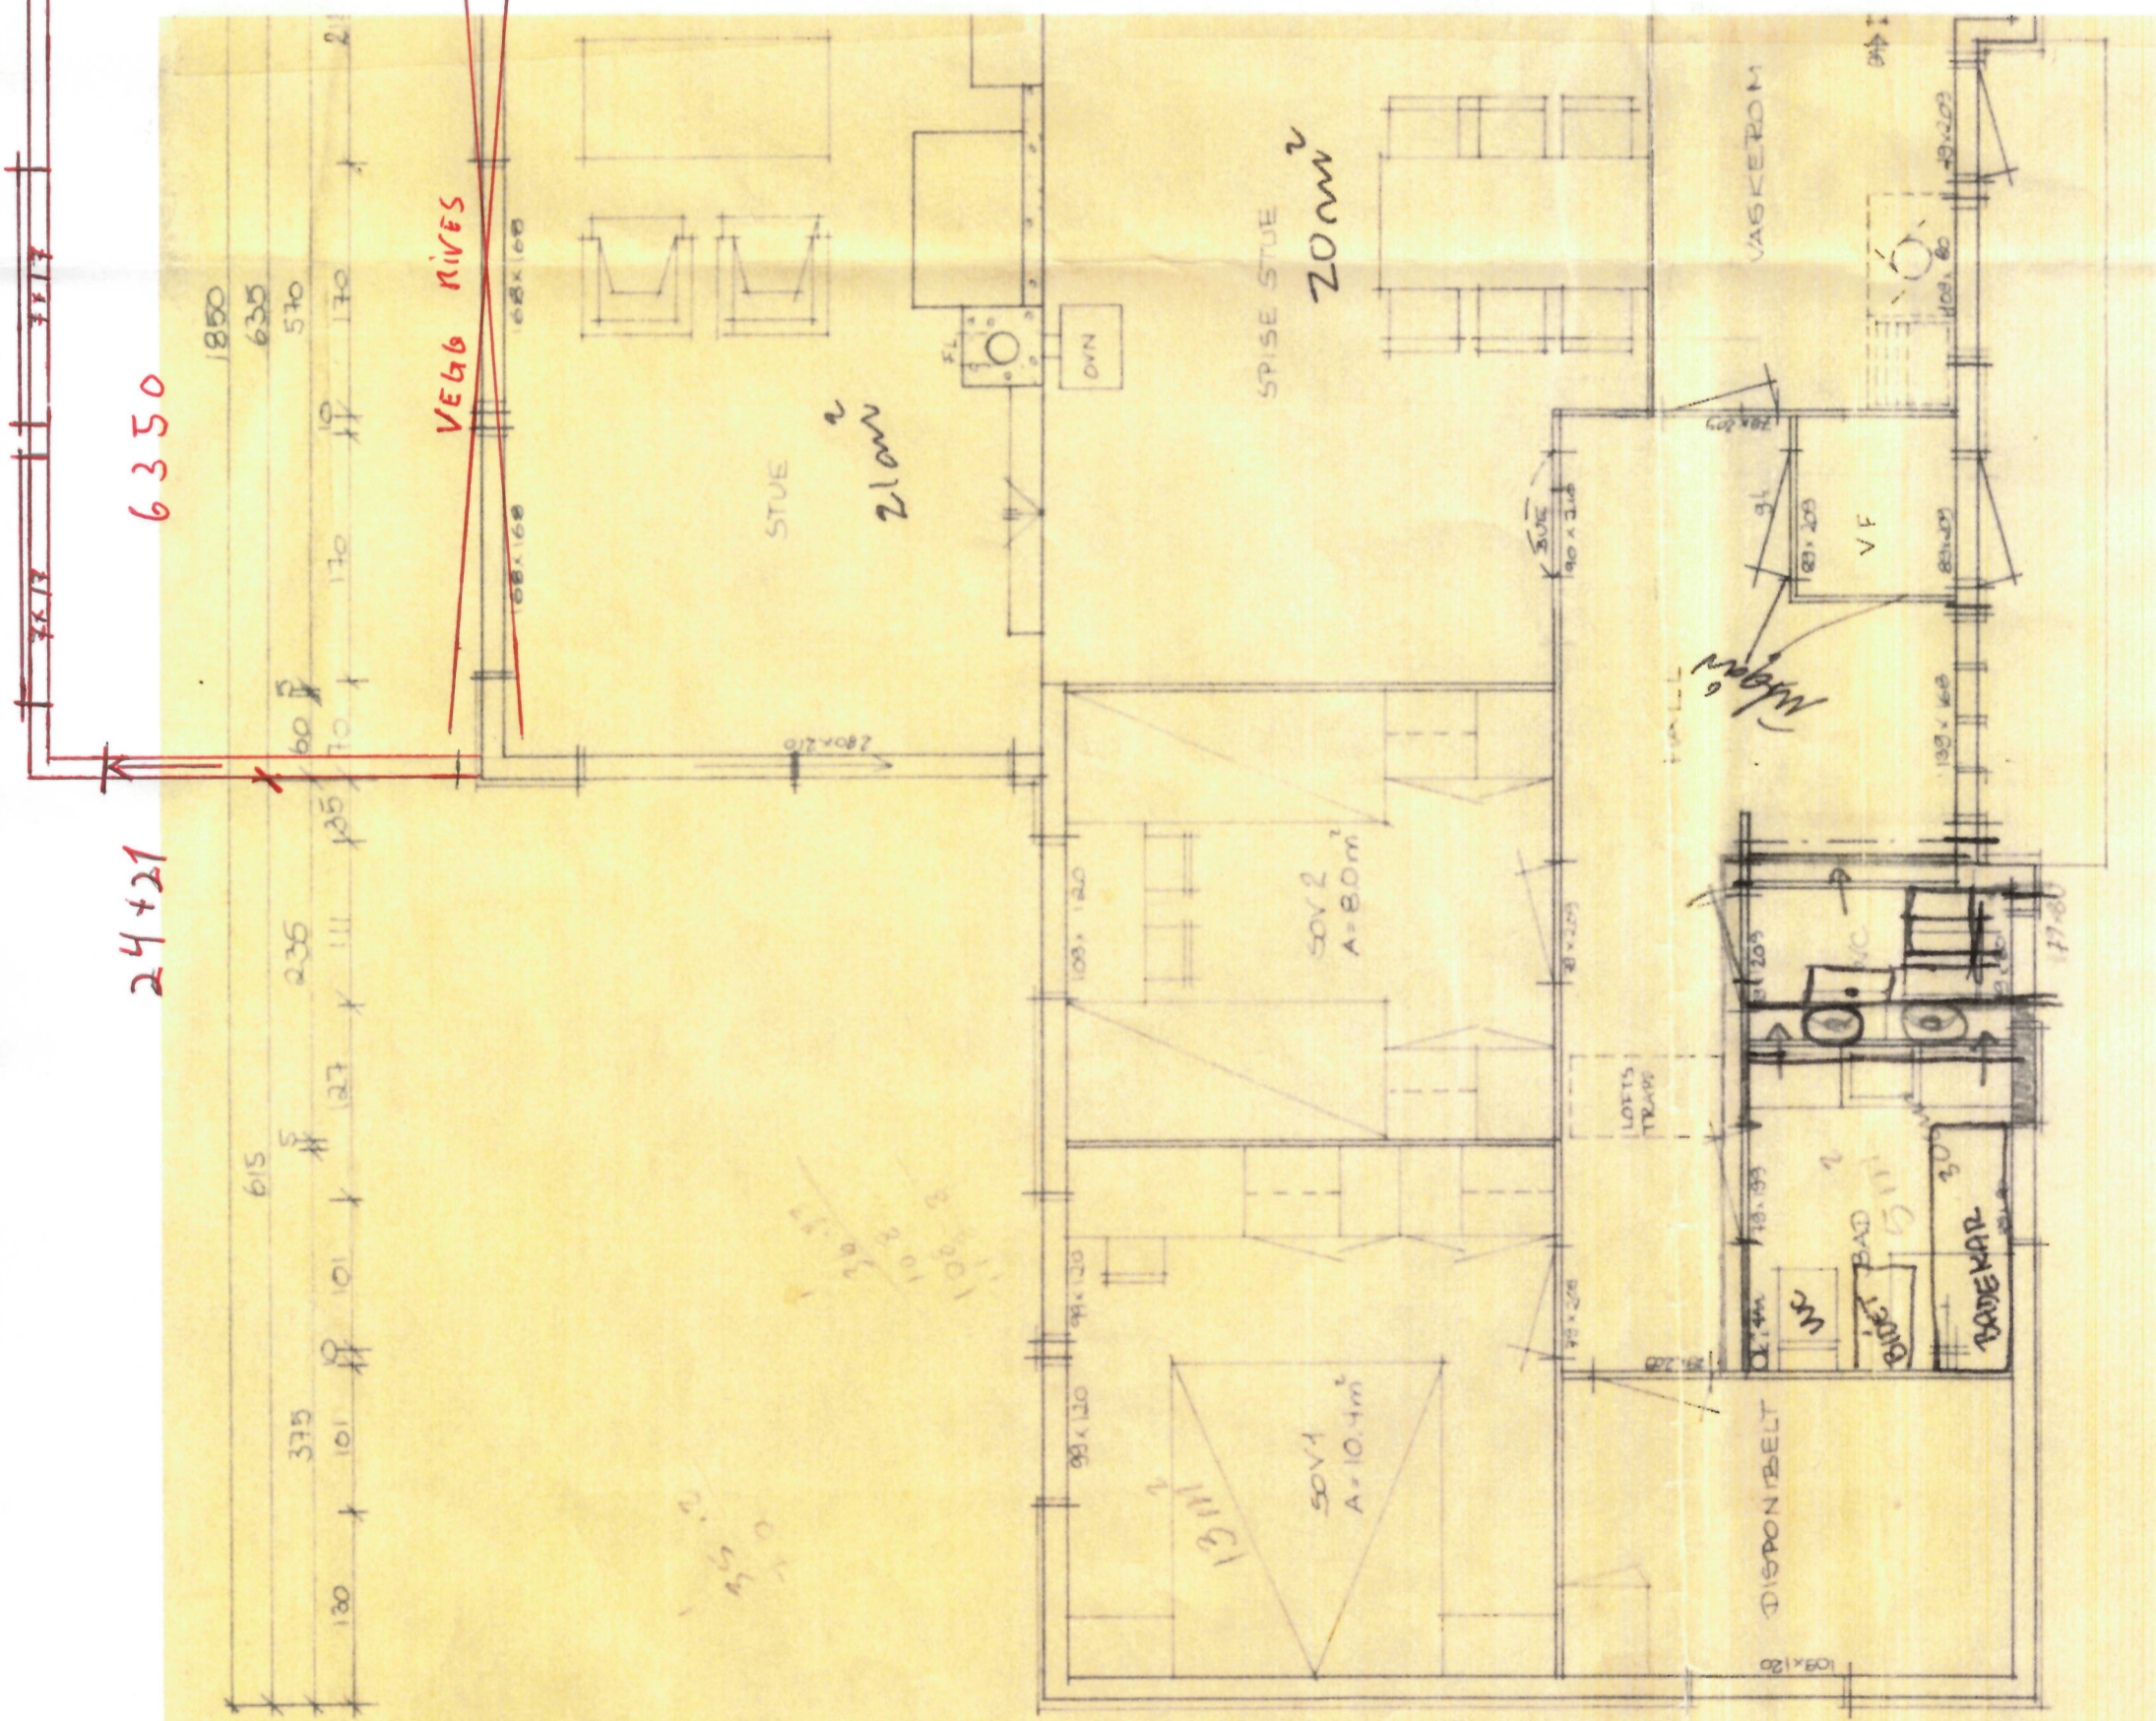

180 + 101 + 127 + 111 + 135 + 70 + 170 + 170 + 21

1850
635
570

~~VEG6 RIVES~~

STUE
210m²

SPISE STUE
20m²

Ally

DISPONIBELT

BAD 5.11m²

BAD 2.5m²

DISPONIBELT

VF

VASKEROM

SOV 2
A=8.0m²

SOV 1
A=10.4m²

STUE
210m²

SPISE STUE
20m²

KJÖKKEN
186m²

MATBOD

HYLLER


KLESBOD


600

80 + 121 + 19

268
290

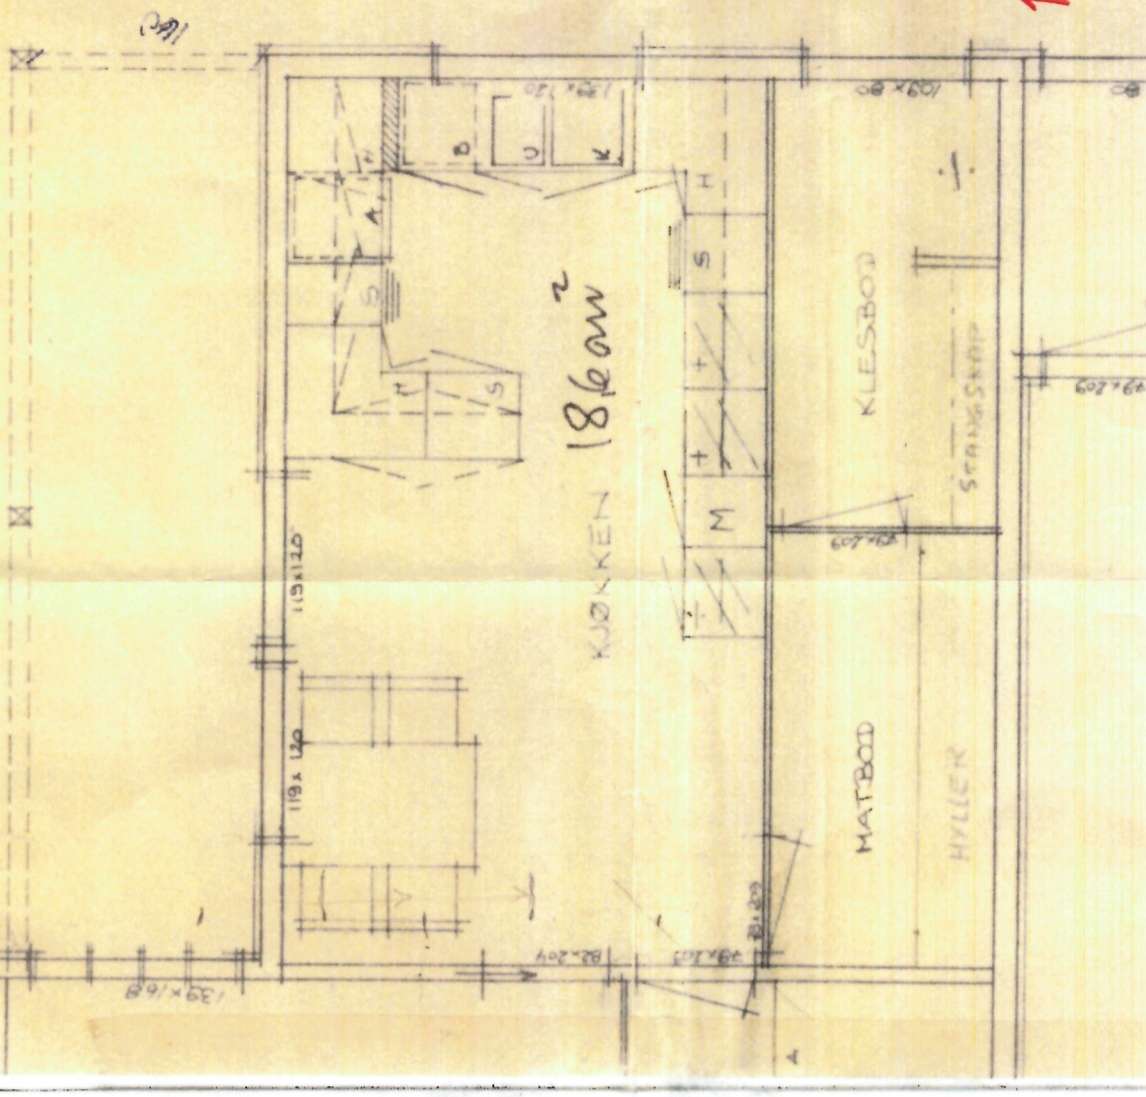

1:50