



F-1

121/6

121/26

121/24

121/16

121/34

121/25

121/1

121/42

Parsell

121/5

121/27

Knarvikgarden

121/36

121/41

121/1

Knarvikgarden

121/35

121/32


Situasjonskart -

Dato: 28-04-2021



Målestokk: 1:1 000



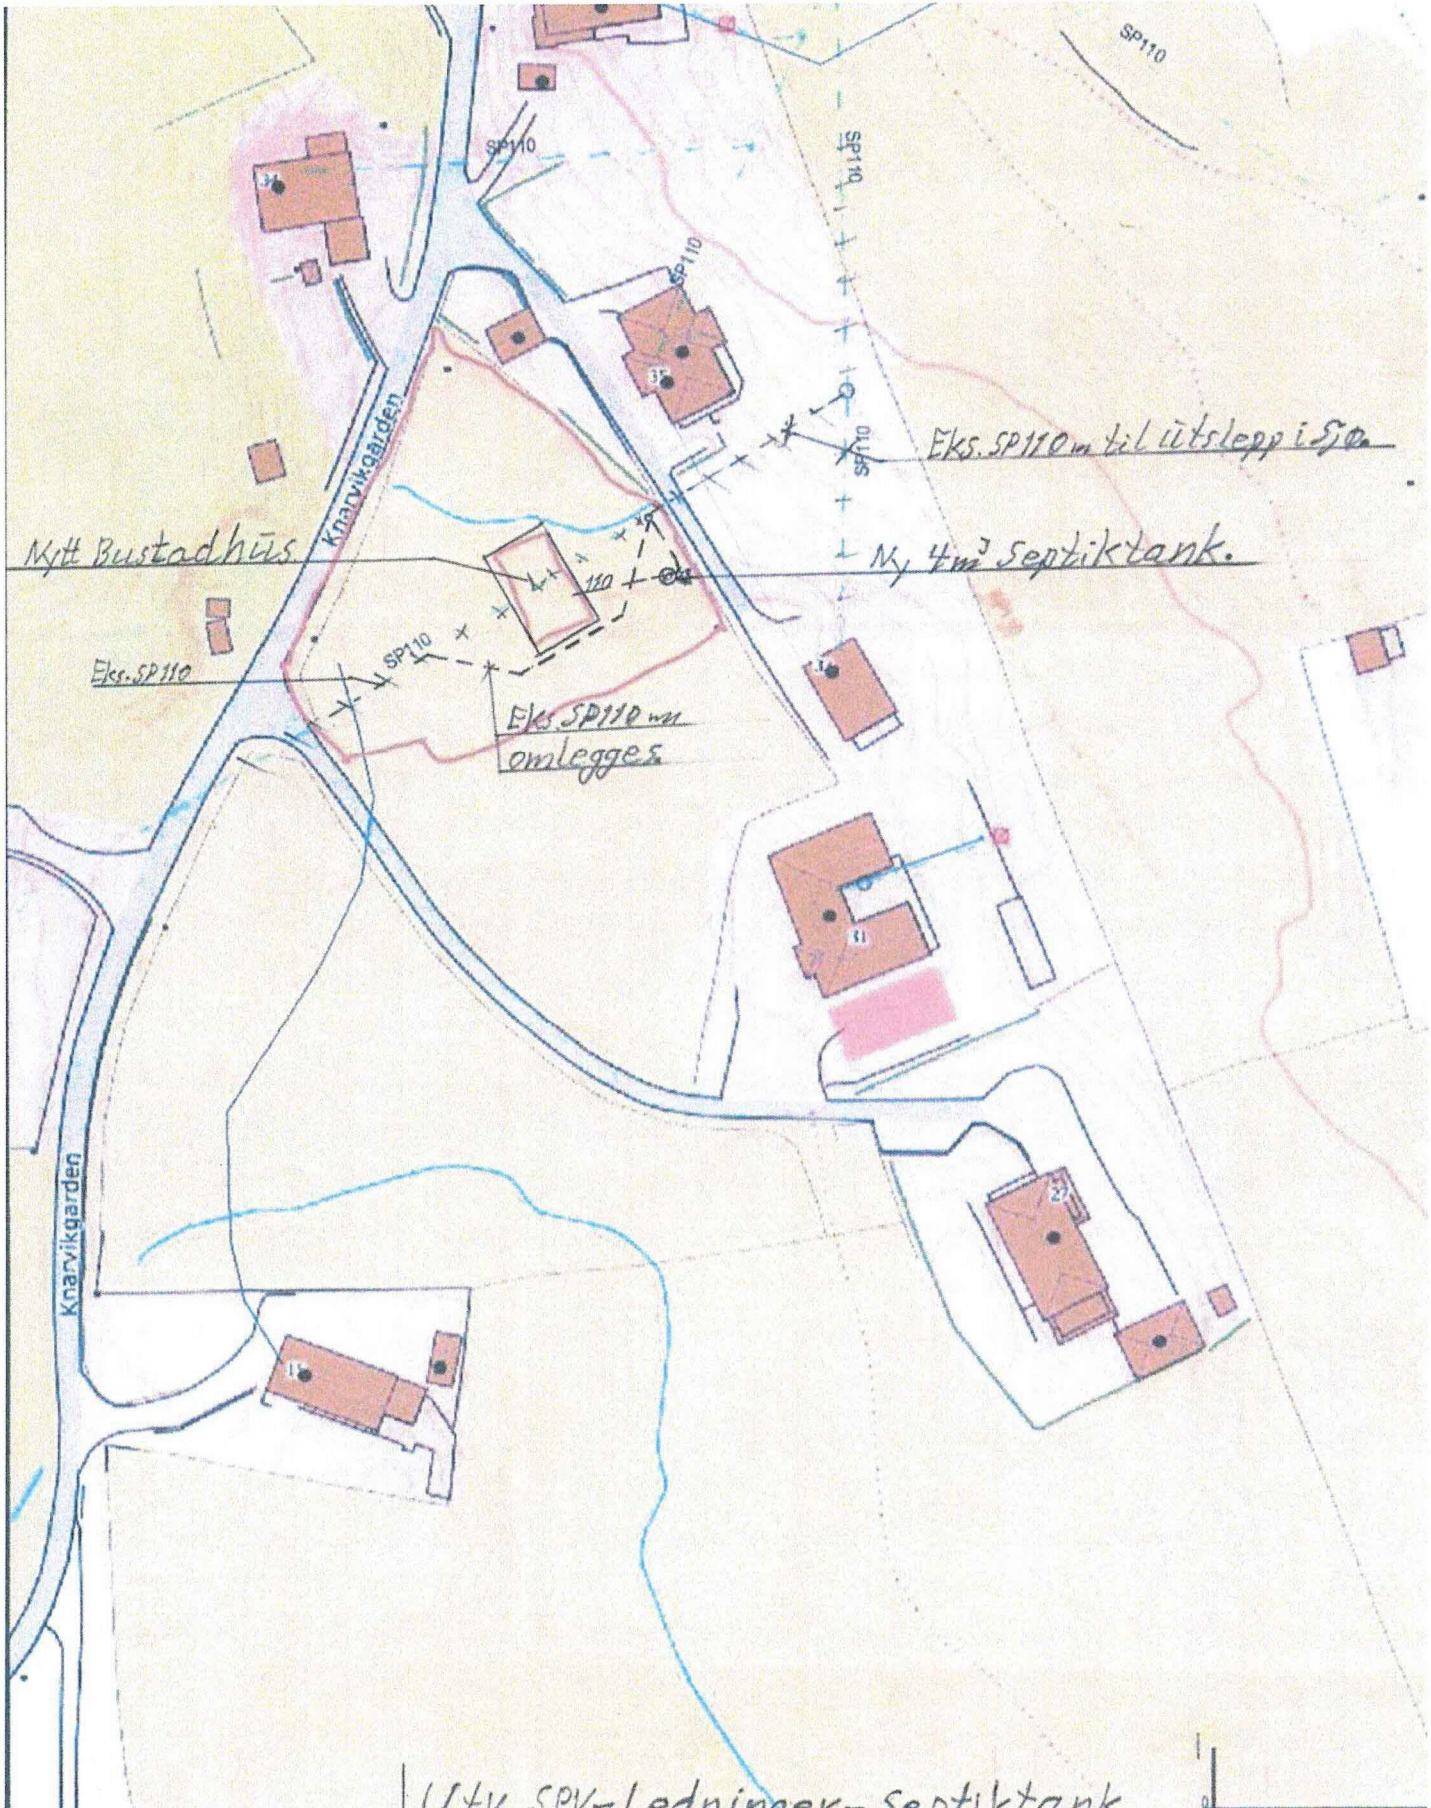

Utv. SPV-Ledninger-septiktank.

Morten Knarvik, Knarvik Nord Gbnr. 121/1

14.04.21

- Måte Grenser
- Regulerende Grenser
- Utefni Grenser
- T Temengmäte grense
- Konstruert grensepunkt
- Boig
- Bustad mængdet
- Våninghus
- Storre bustader
- Hytte/feriehüs
- Garasje uthus
- Innværtauger
- Andre bygg



dat: 2021.02.04
sup: 21

Handwritten signature

Q-1