




PROFIL 1

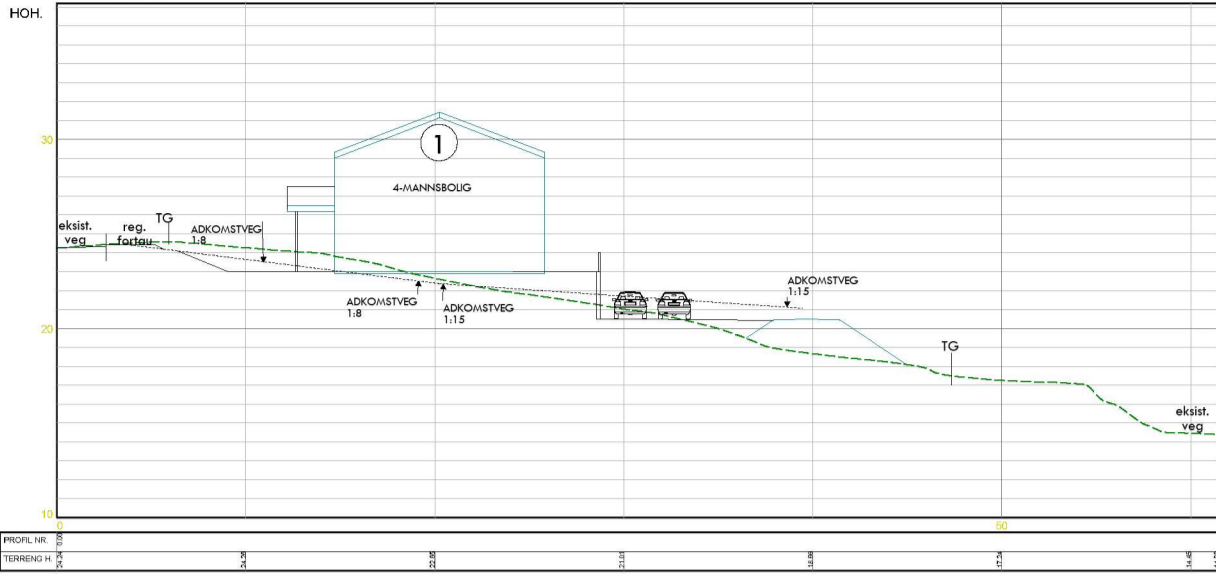


PROFIL 2

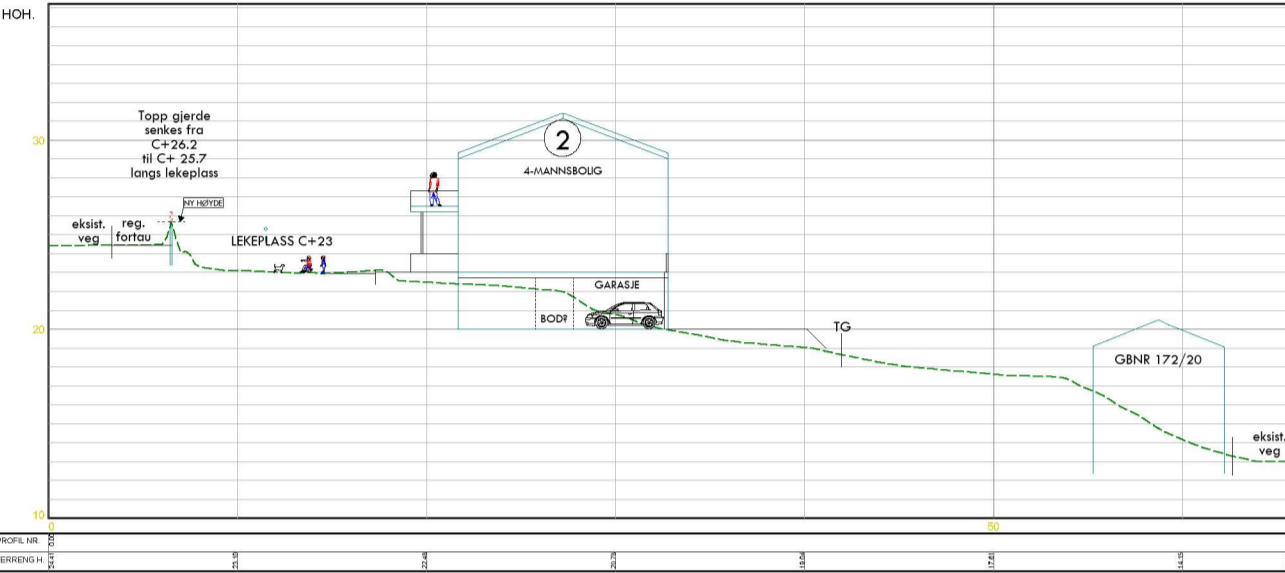

PROFIL 3

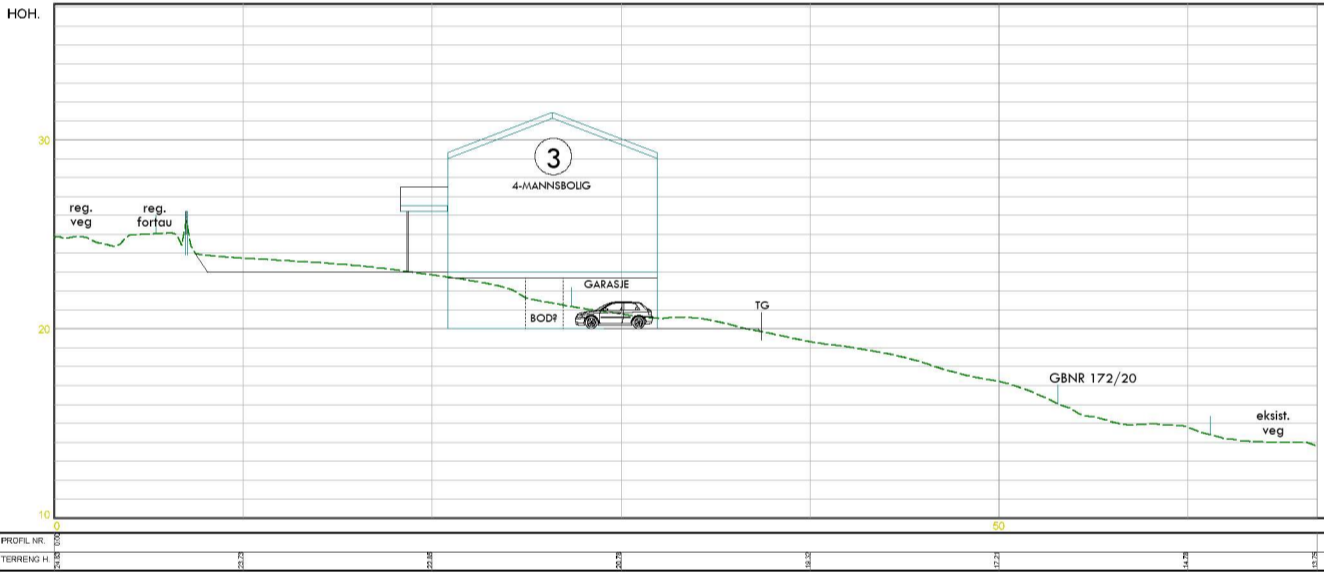

BIRKELUNDSTUNET VEGPROFIL - PLANLAGT INTERNVEG

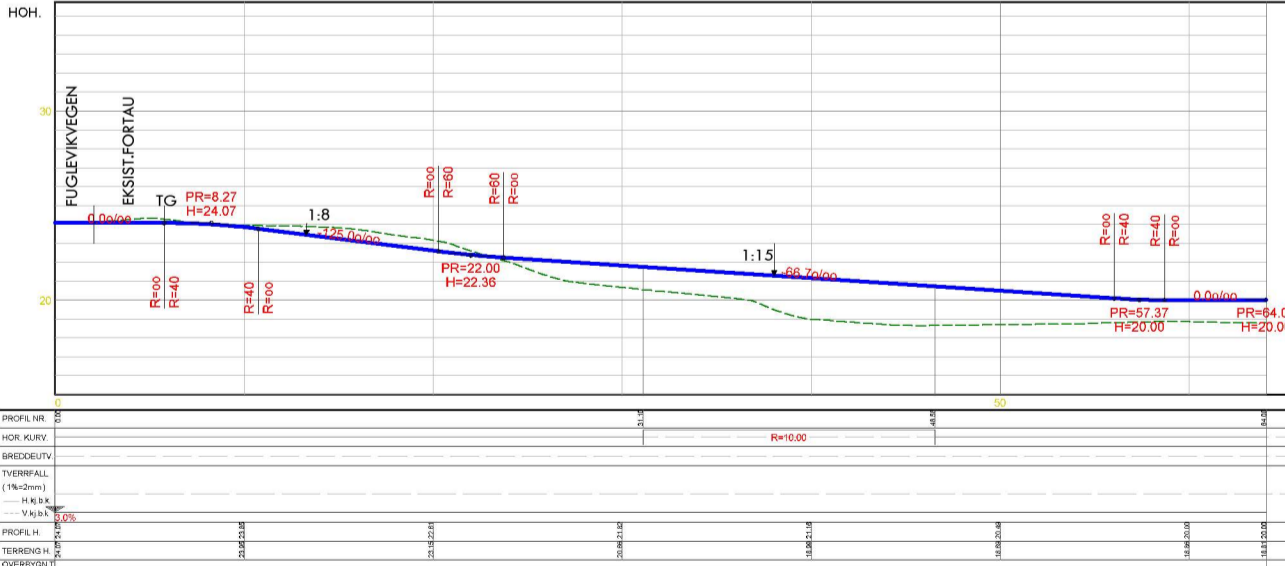

04.03.2021 Justeringer mhs

<b>BIRKELUNDSTUNET</b>			
SEIM ALVER			
Dato 02/10/19	Konst./Årgnet	Godkjert	Målestokk 1:400
EUREF89 - SONE 32			
Profil 1-2-3			
Henvisning:		Beregning:	9004