


3000
H: 2100

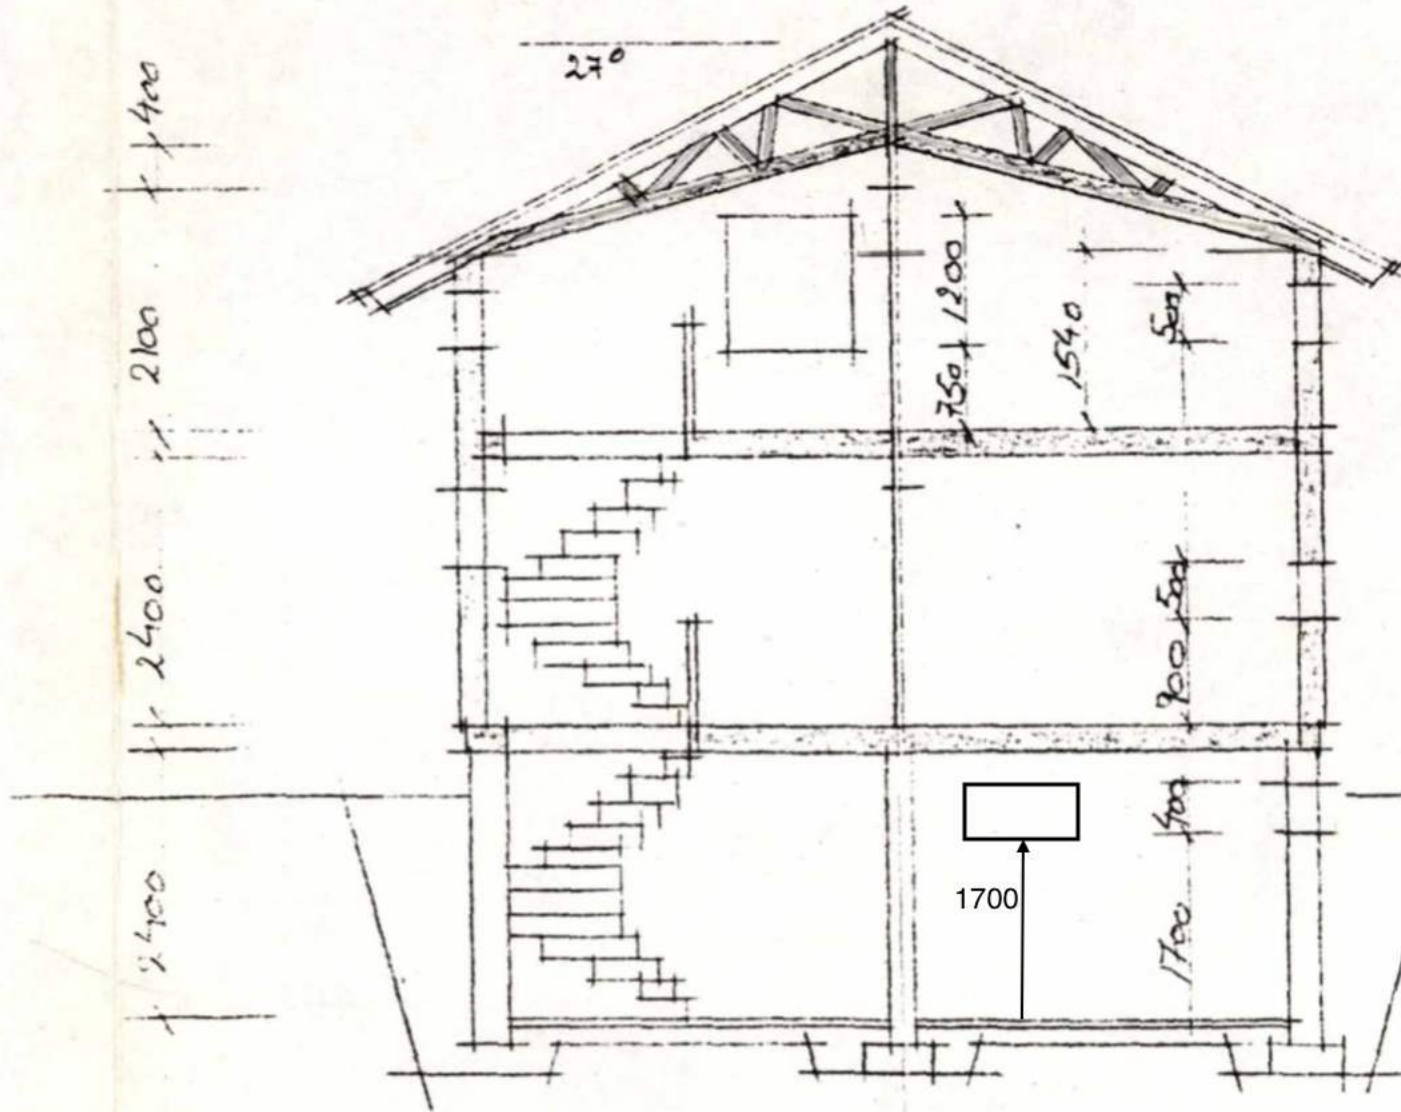

Skizze 1/100

Gov. 23. B. Nr. 358-

A		
REV	ANT	REV. G. IELDER