
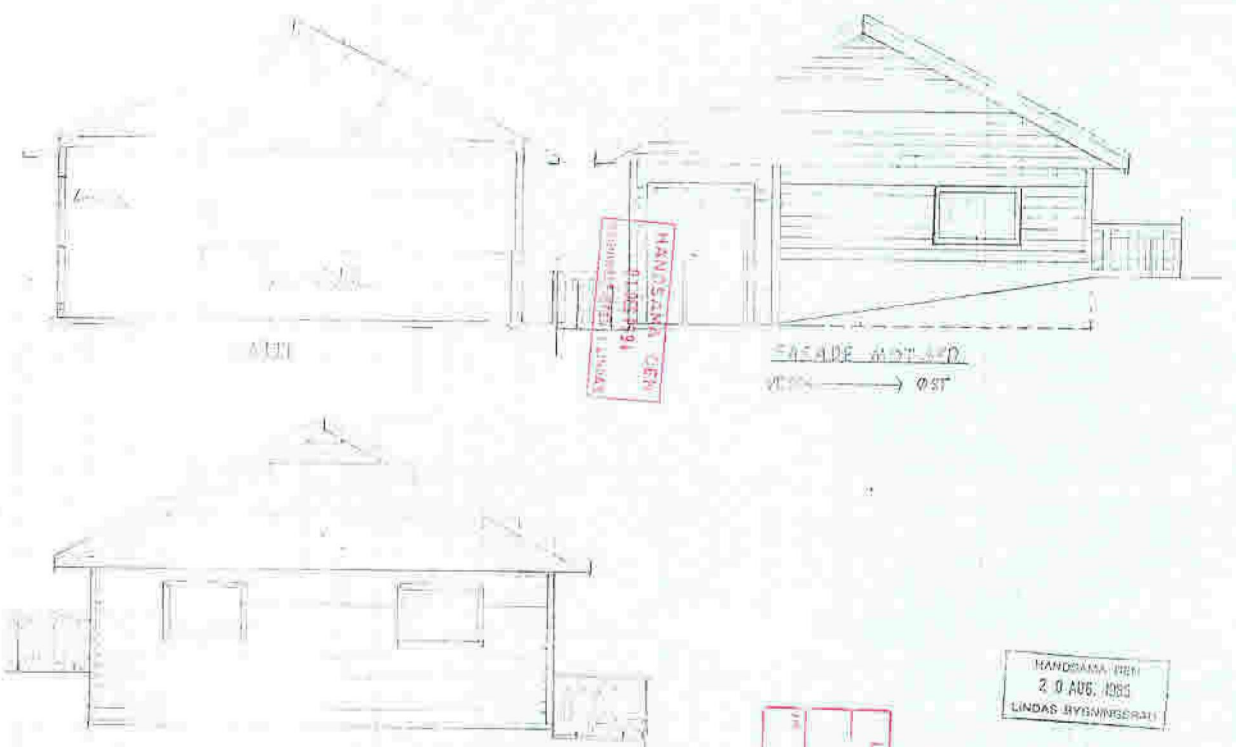


7.70

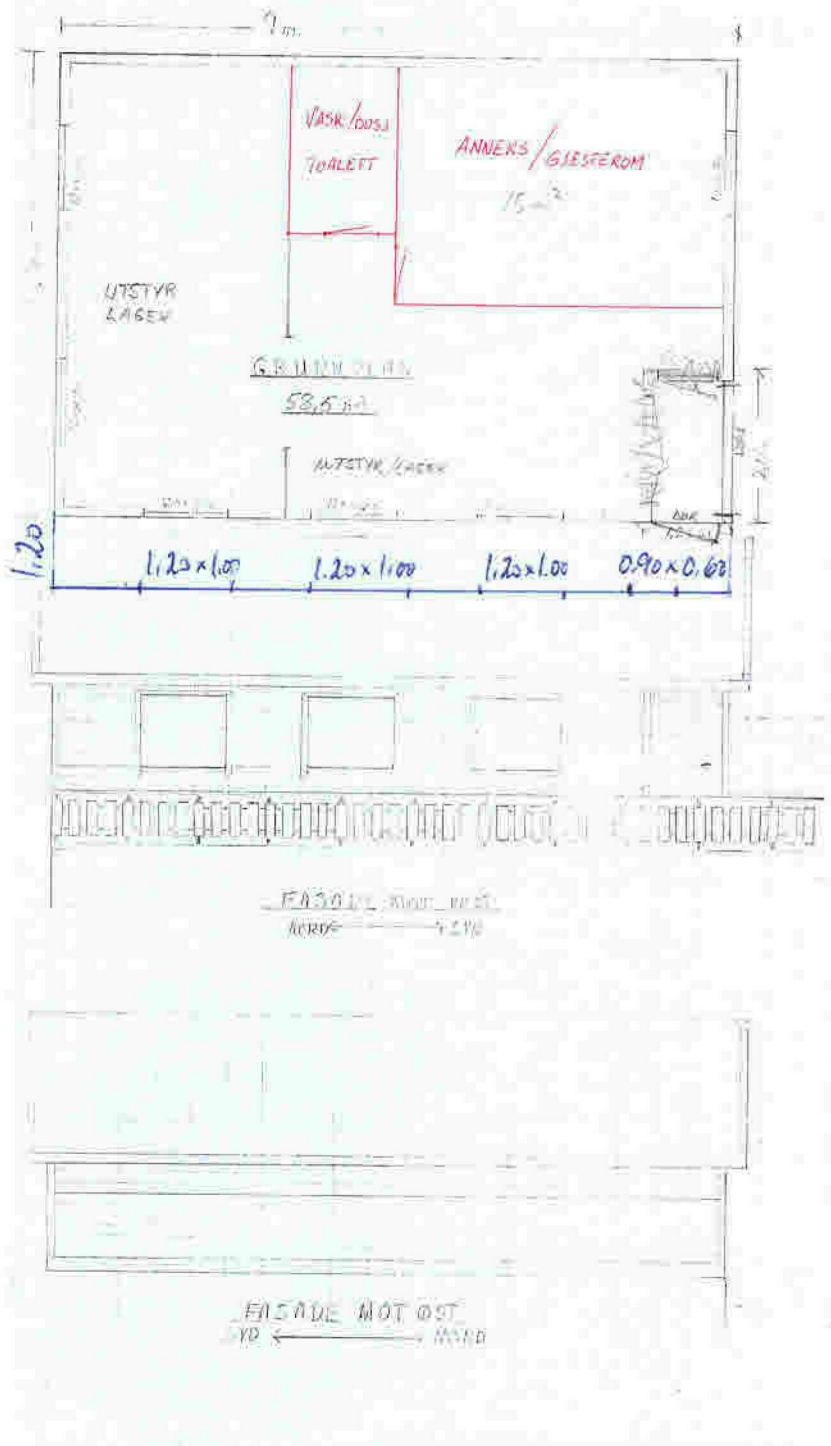


HANDESKA PÅR
 21.08.1991
 LINDAS BYGNINGSRÅD

HANDESKA PÅR
 2.0 AUG. 1986
 LINDAS BYGNINGSRÅD

LINDAS NORGEMNE
 TEGNERE ETABL.
 2.8. SEP. 1984


ARKIV

00000 00000
 514-66

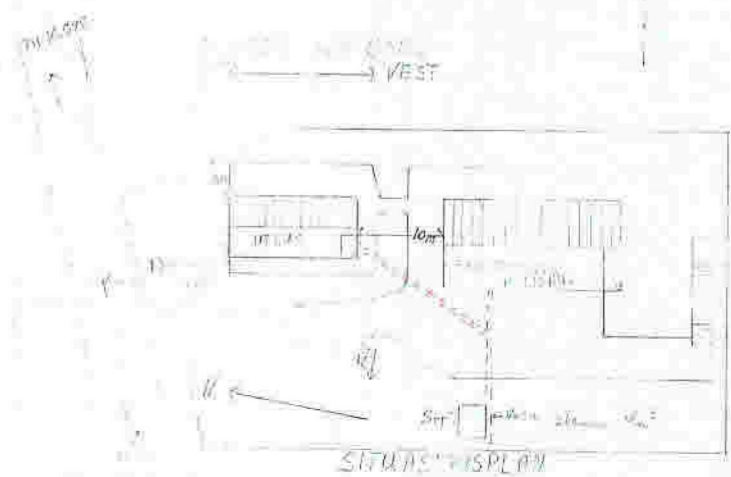

PLAN, SNITT OG FASADE-TEGNINGER AV UTHUS 1:50
 TEGNET AV JOSTEIN HJELMVEIT
 5146 DALSGREND

9,00

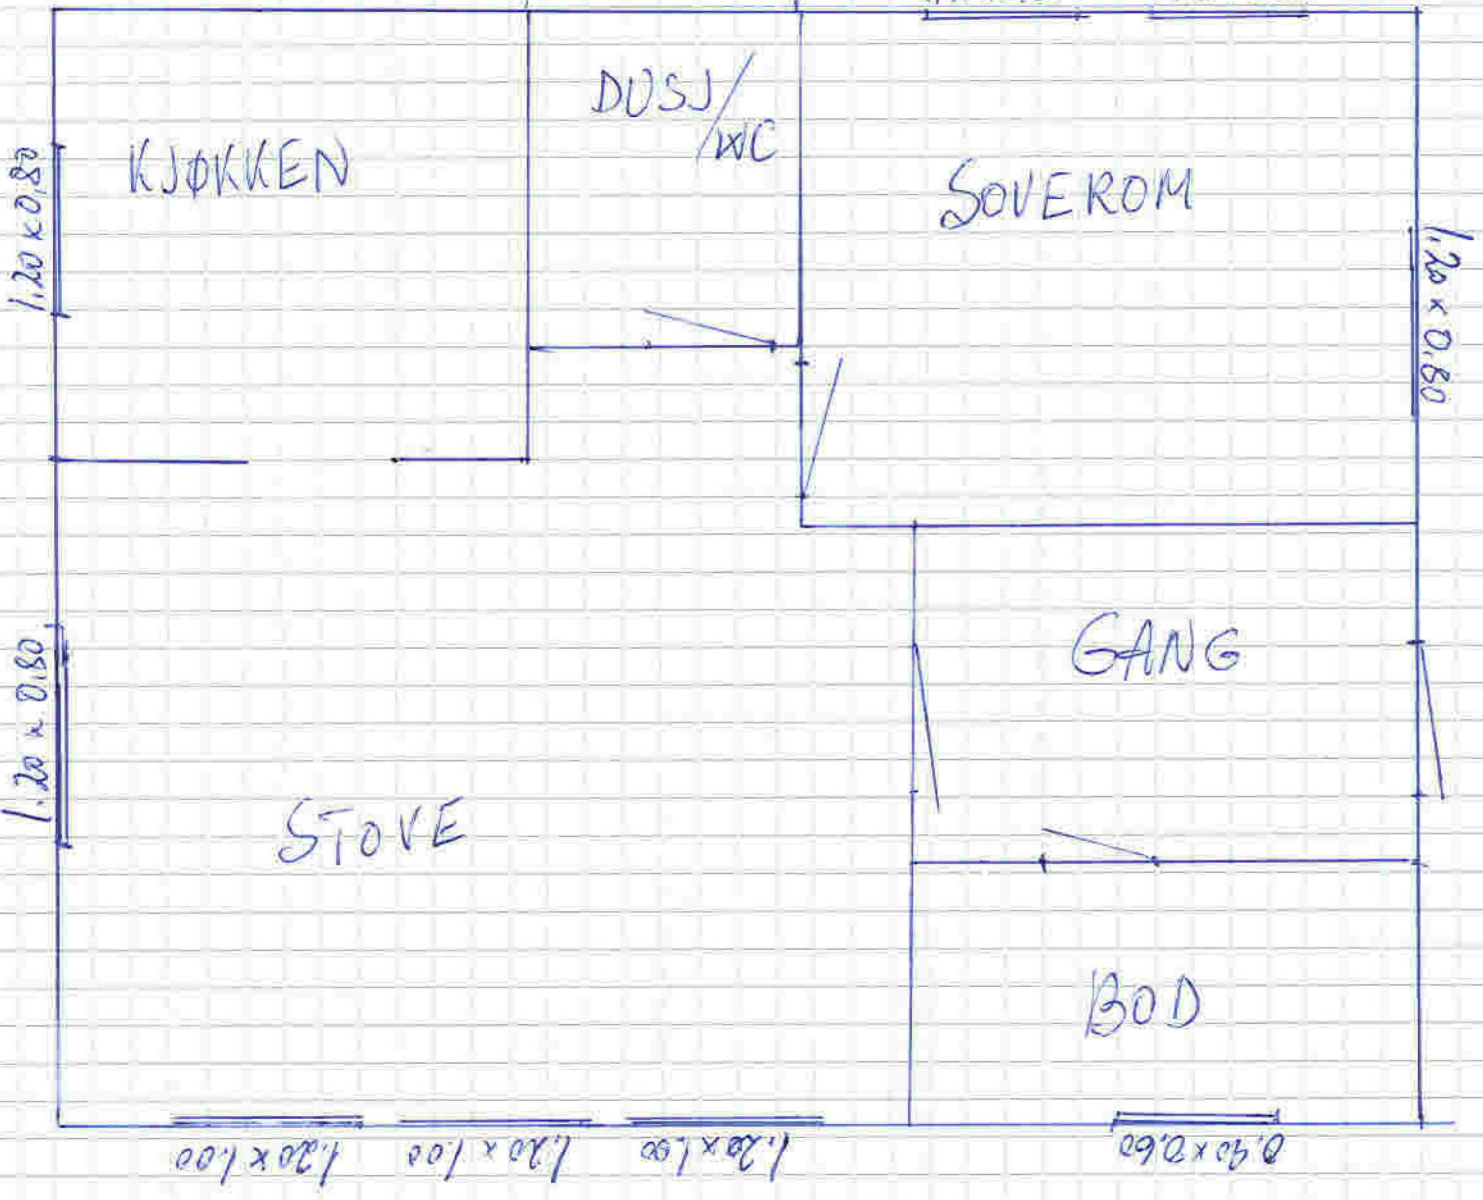

7,70

1,20 x 0,80

1,20 x 0,80

1,10 x 0,50

1,10 x 0,50

1,20 x 0,80

1,20 x 1,00 1,20 x 1,00 1,20 x 1,00

0,90 x 0,60