


Search for content in selected sources

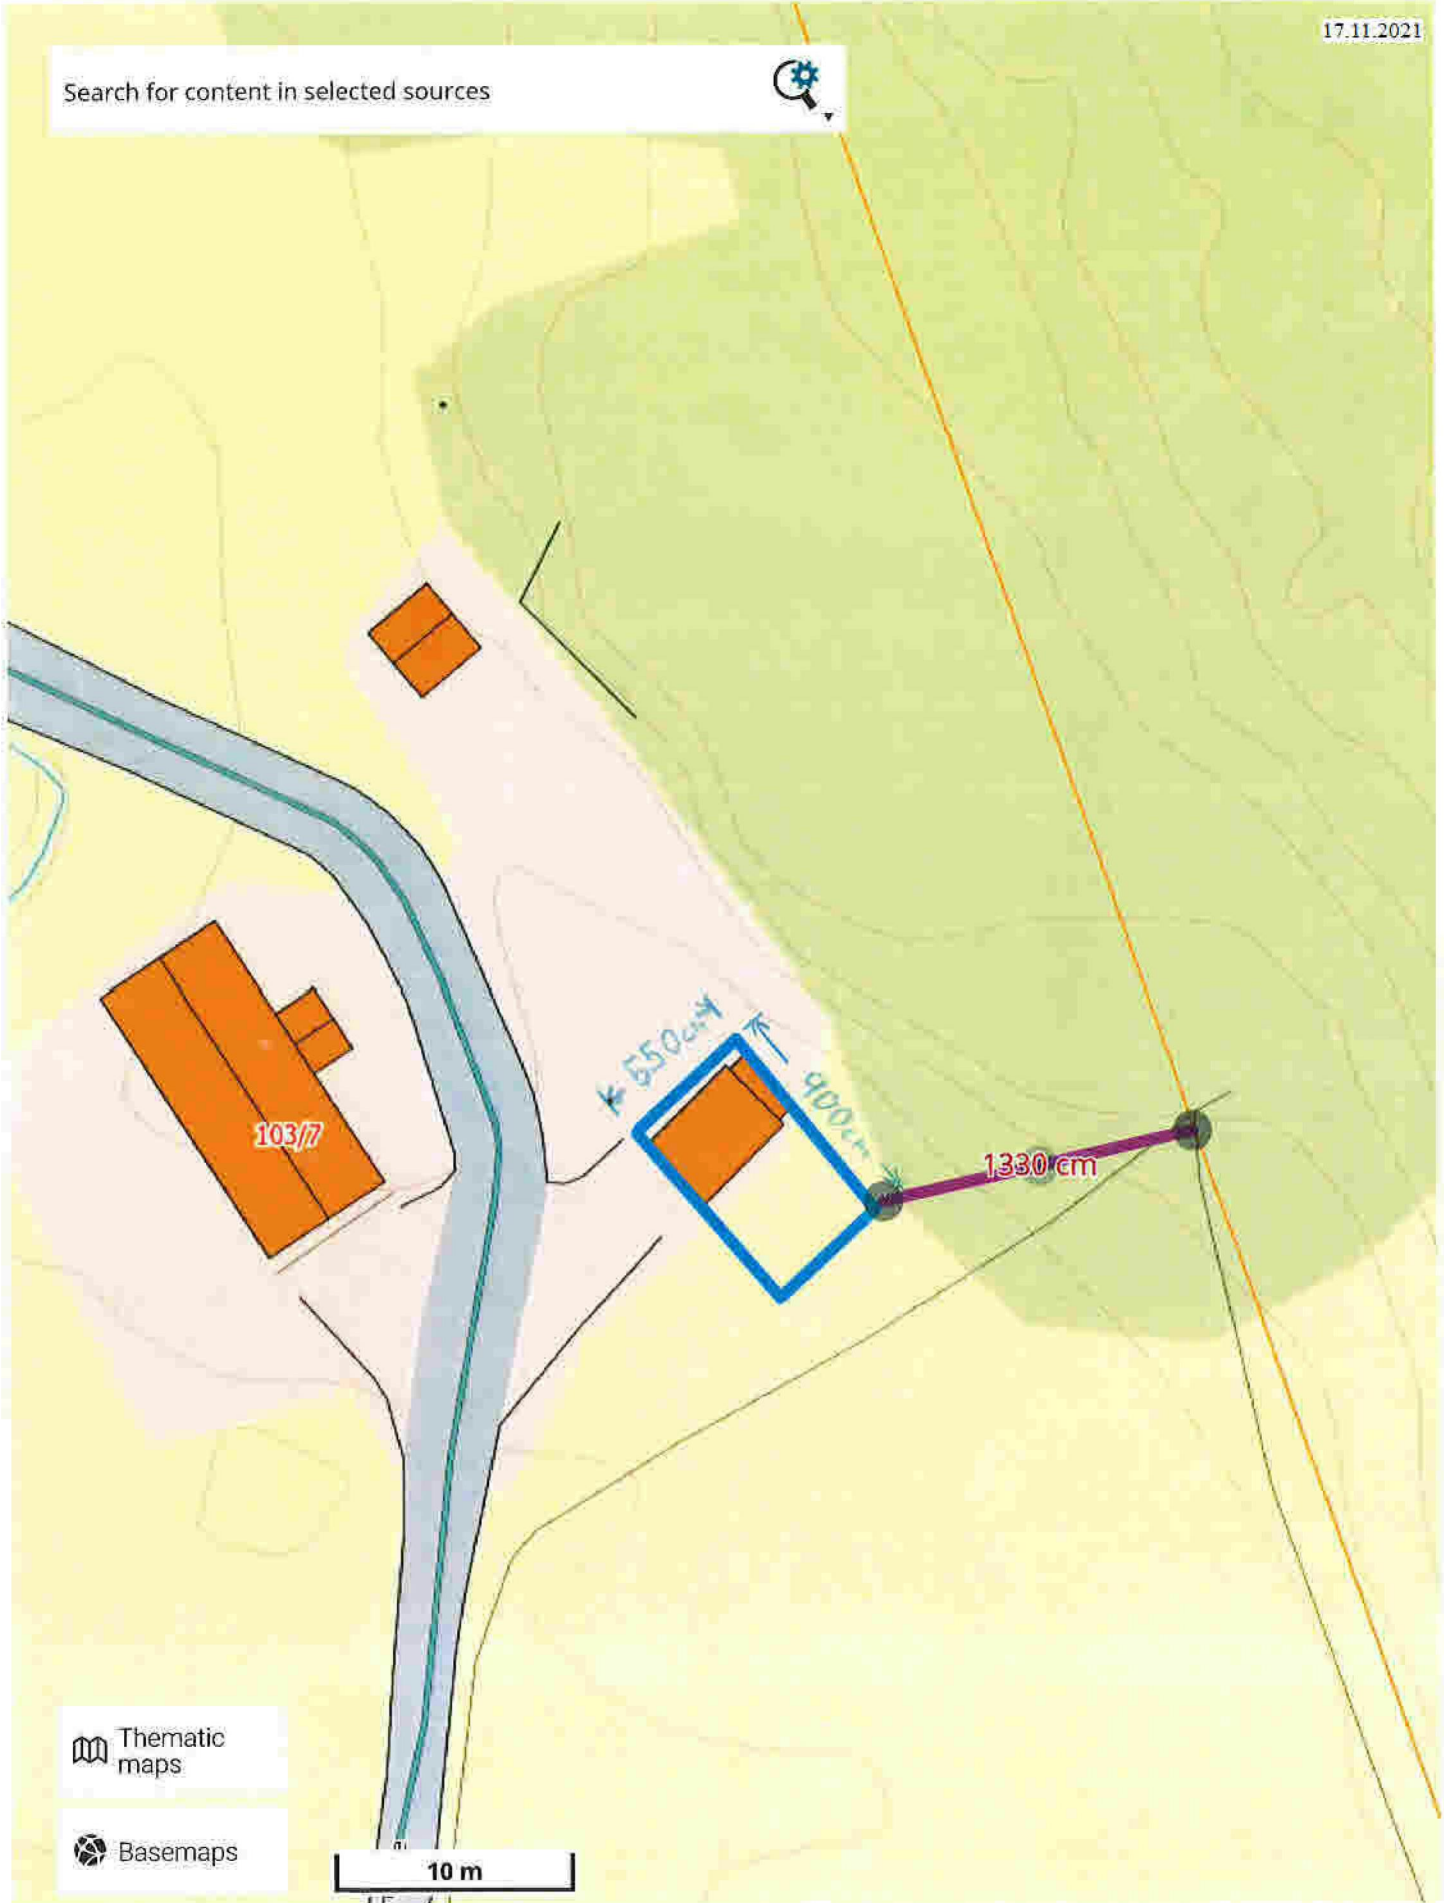

Thematic maps

Basemaps

10 m

EPSG:32632 N: 6738293 E: 292743

Scale 1 : 312