


Forenklet situasjonskart: 4631-458/4/0/0

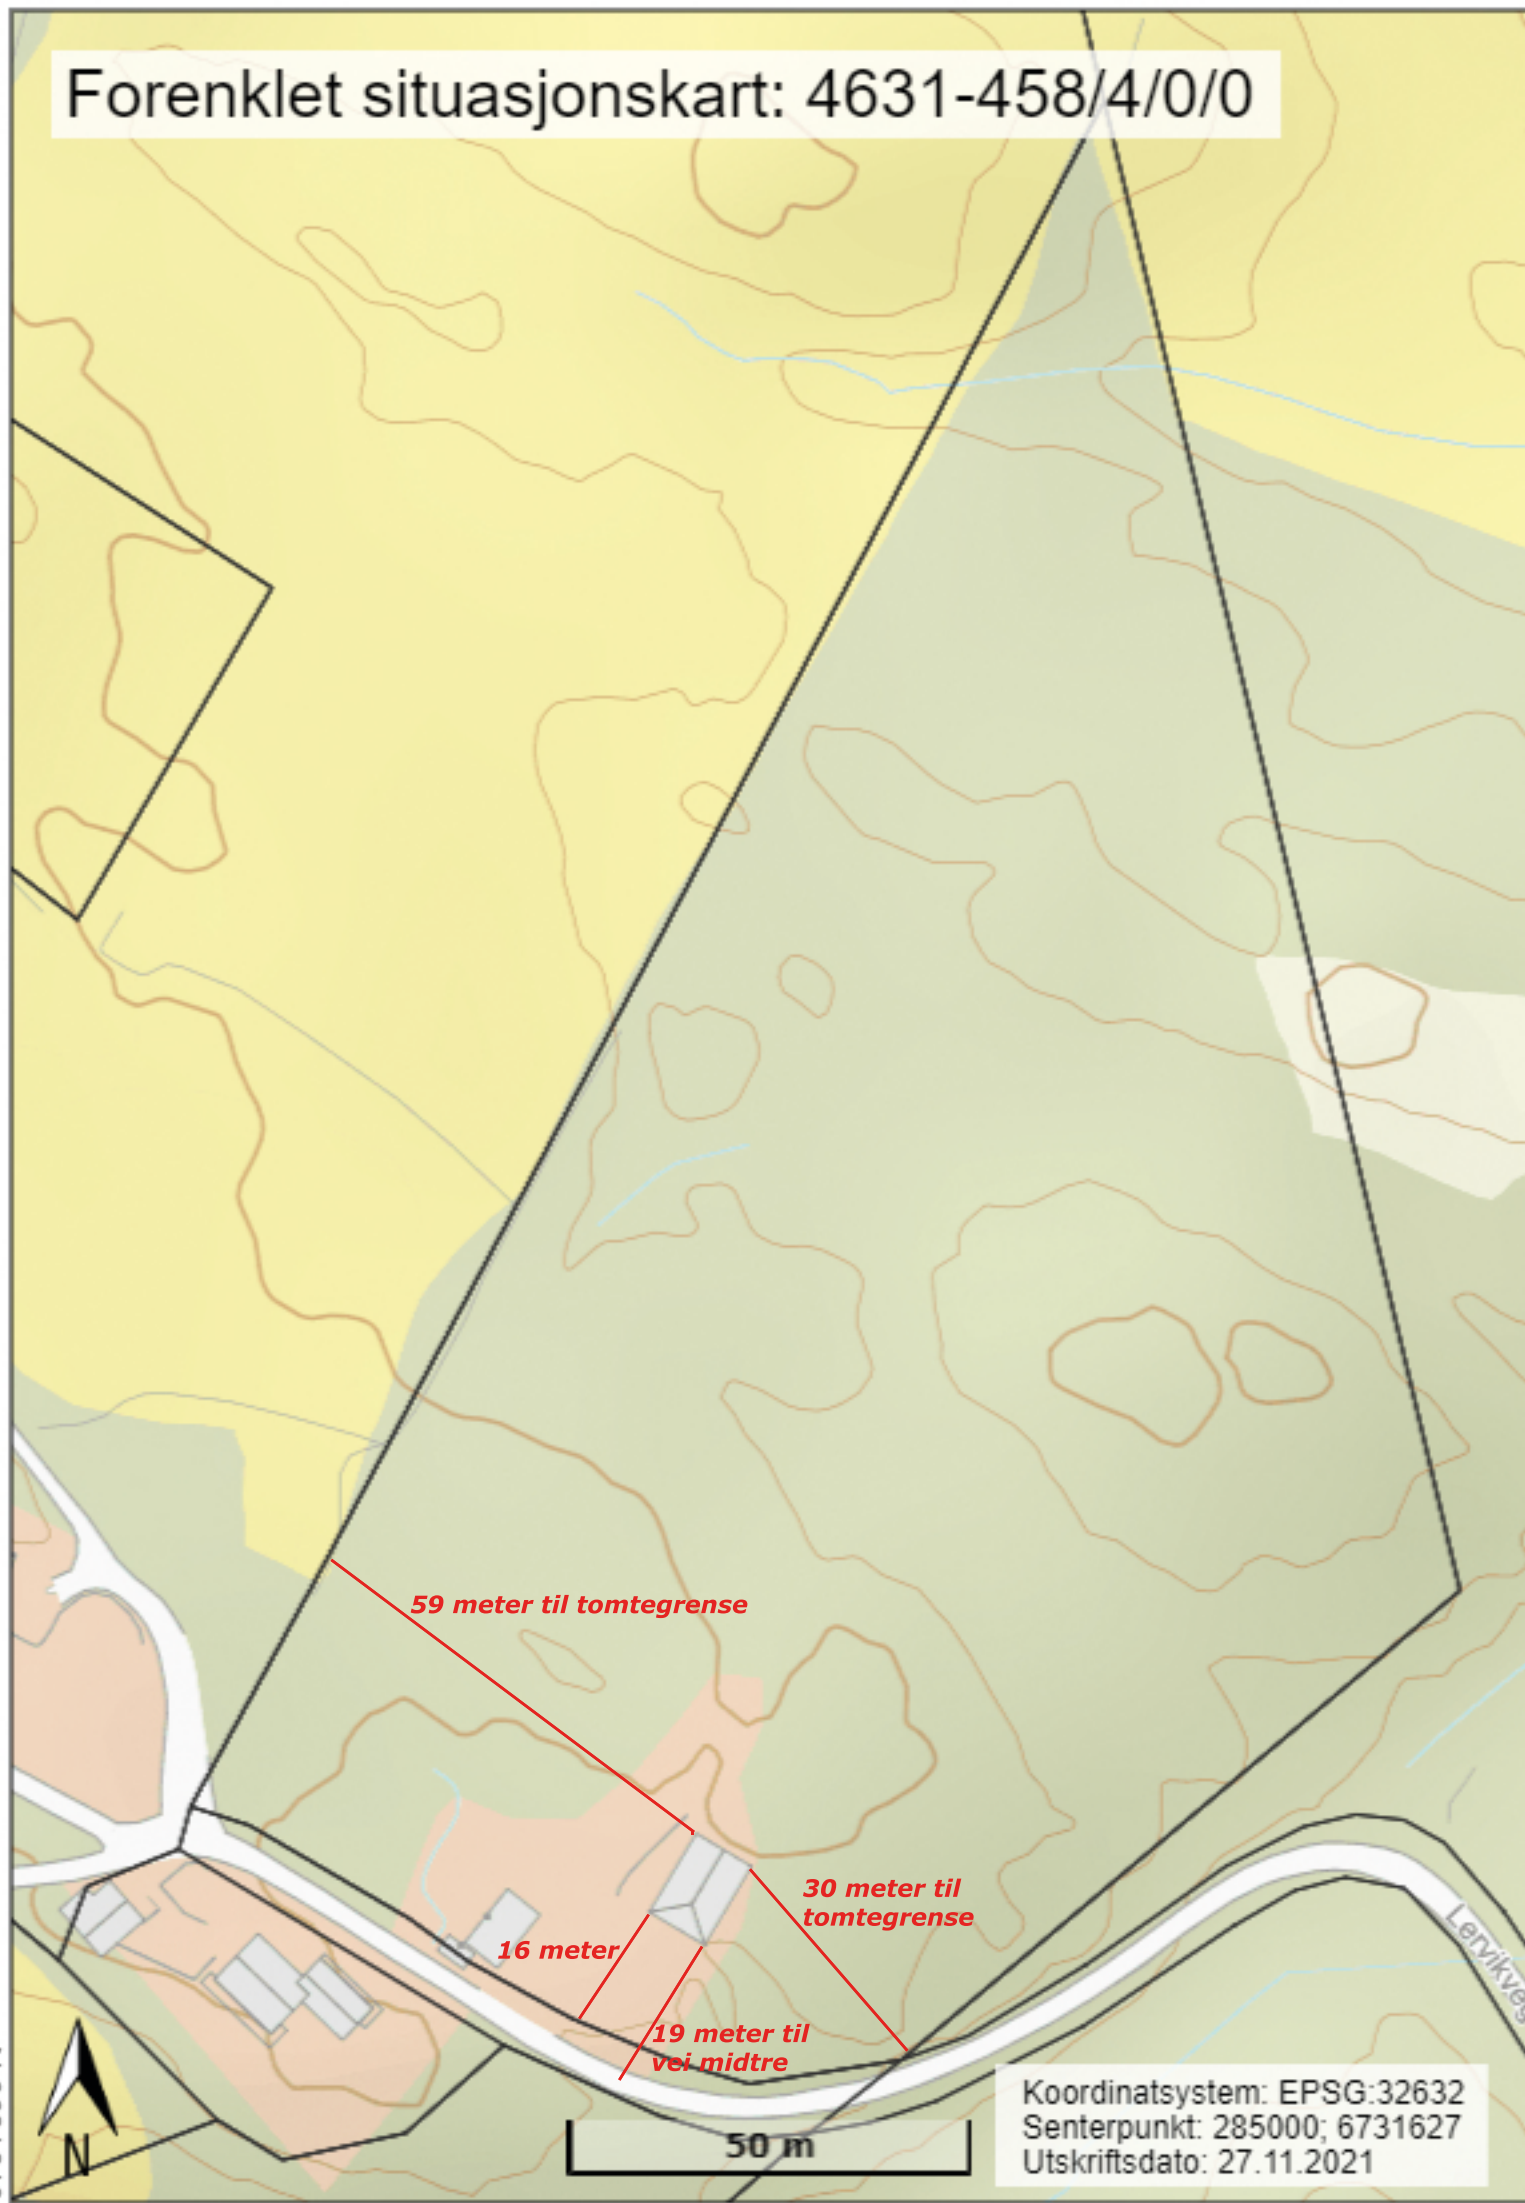

Koordinatsystem: EPSG:32632
Senterpunkt: 285000; 6731627
Utskriftsdato: 27.11.2021