


**Etg 1**  
1 : 50

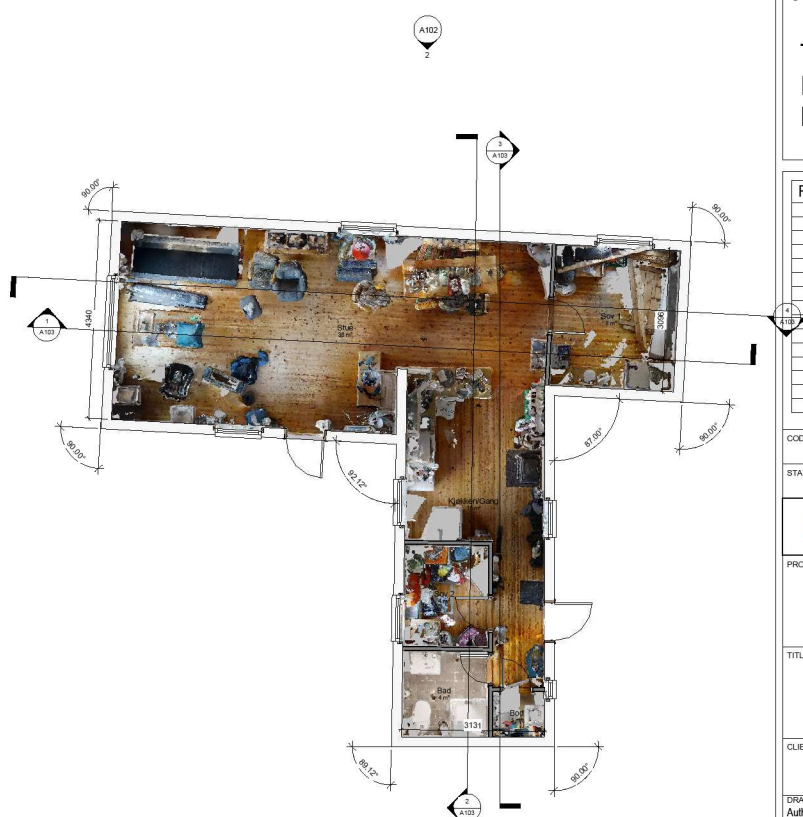

**Etg 1 (med skanning)**  
1 : 50

BRA: 68 m<sup>2</sup>  
BYA: 78 m<sup>2</sup>

(Mål oppgitt av tiltakshaver)

Tiltakshaver:  
Inge Fyllingsnes  
Holding AS

Rev	Description	Date

CODE	SUITABILITY DESCRIPTION
STATUS	PURPOSE OF ISSUE

**AUTODESK**  
www.autodesk.com/revit

PROJECT  
Litlevaagsbrotet 26  
G.nr 214 B.nr 44

TITLE  
Plantegning

CLIENT  
Inge Fyllingsnes

DRAWN BY Author	CHECKED BY Checker	DATE 01/23/07
SCALE (to A1) 1 : 50	PROJECT NUMBER Project Number	
DRAWING NUMBER A101		REV