


Profil 220 (M= 1:100)

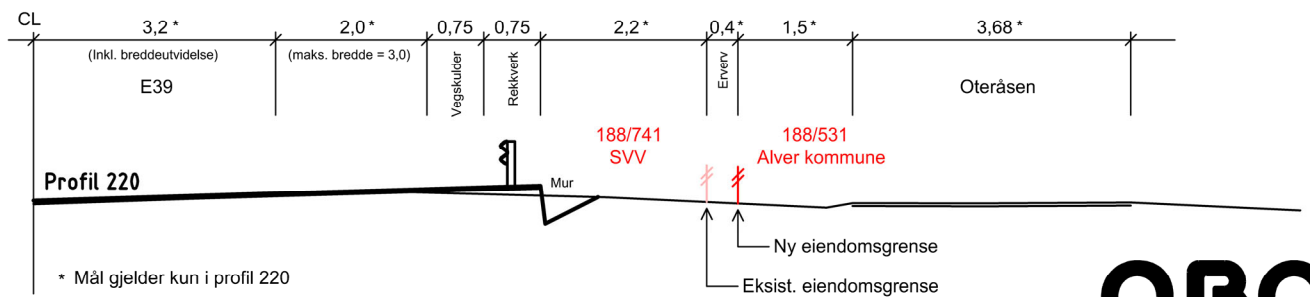

TEGNFORKLARING

- Kommunal eiendom
- Område for erverv

- Rekkverk
- VL
- SP

ABO
PLAN &
ARKITEKTUR

Vedlegg til avtale om tiltak
Os, 24.01.2022