


9.2.2022



FØR

Kyrhovden

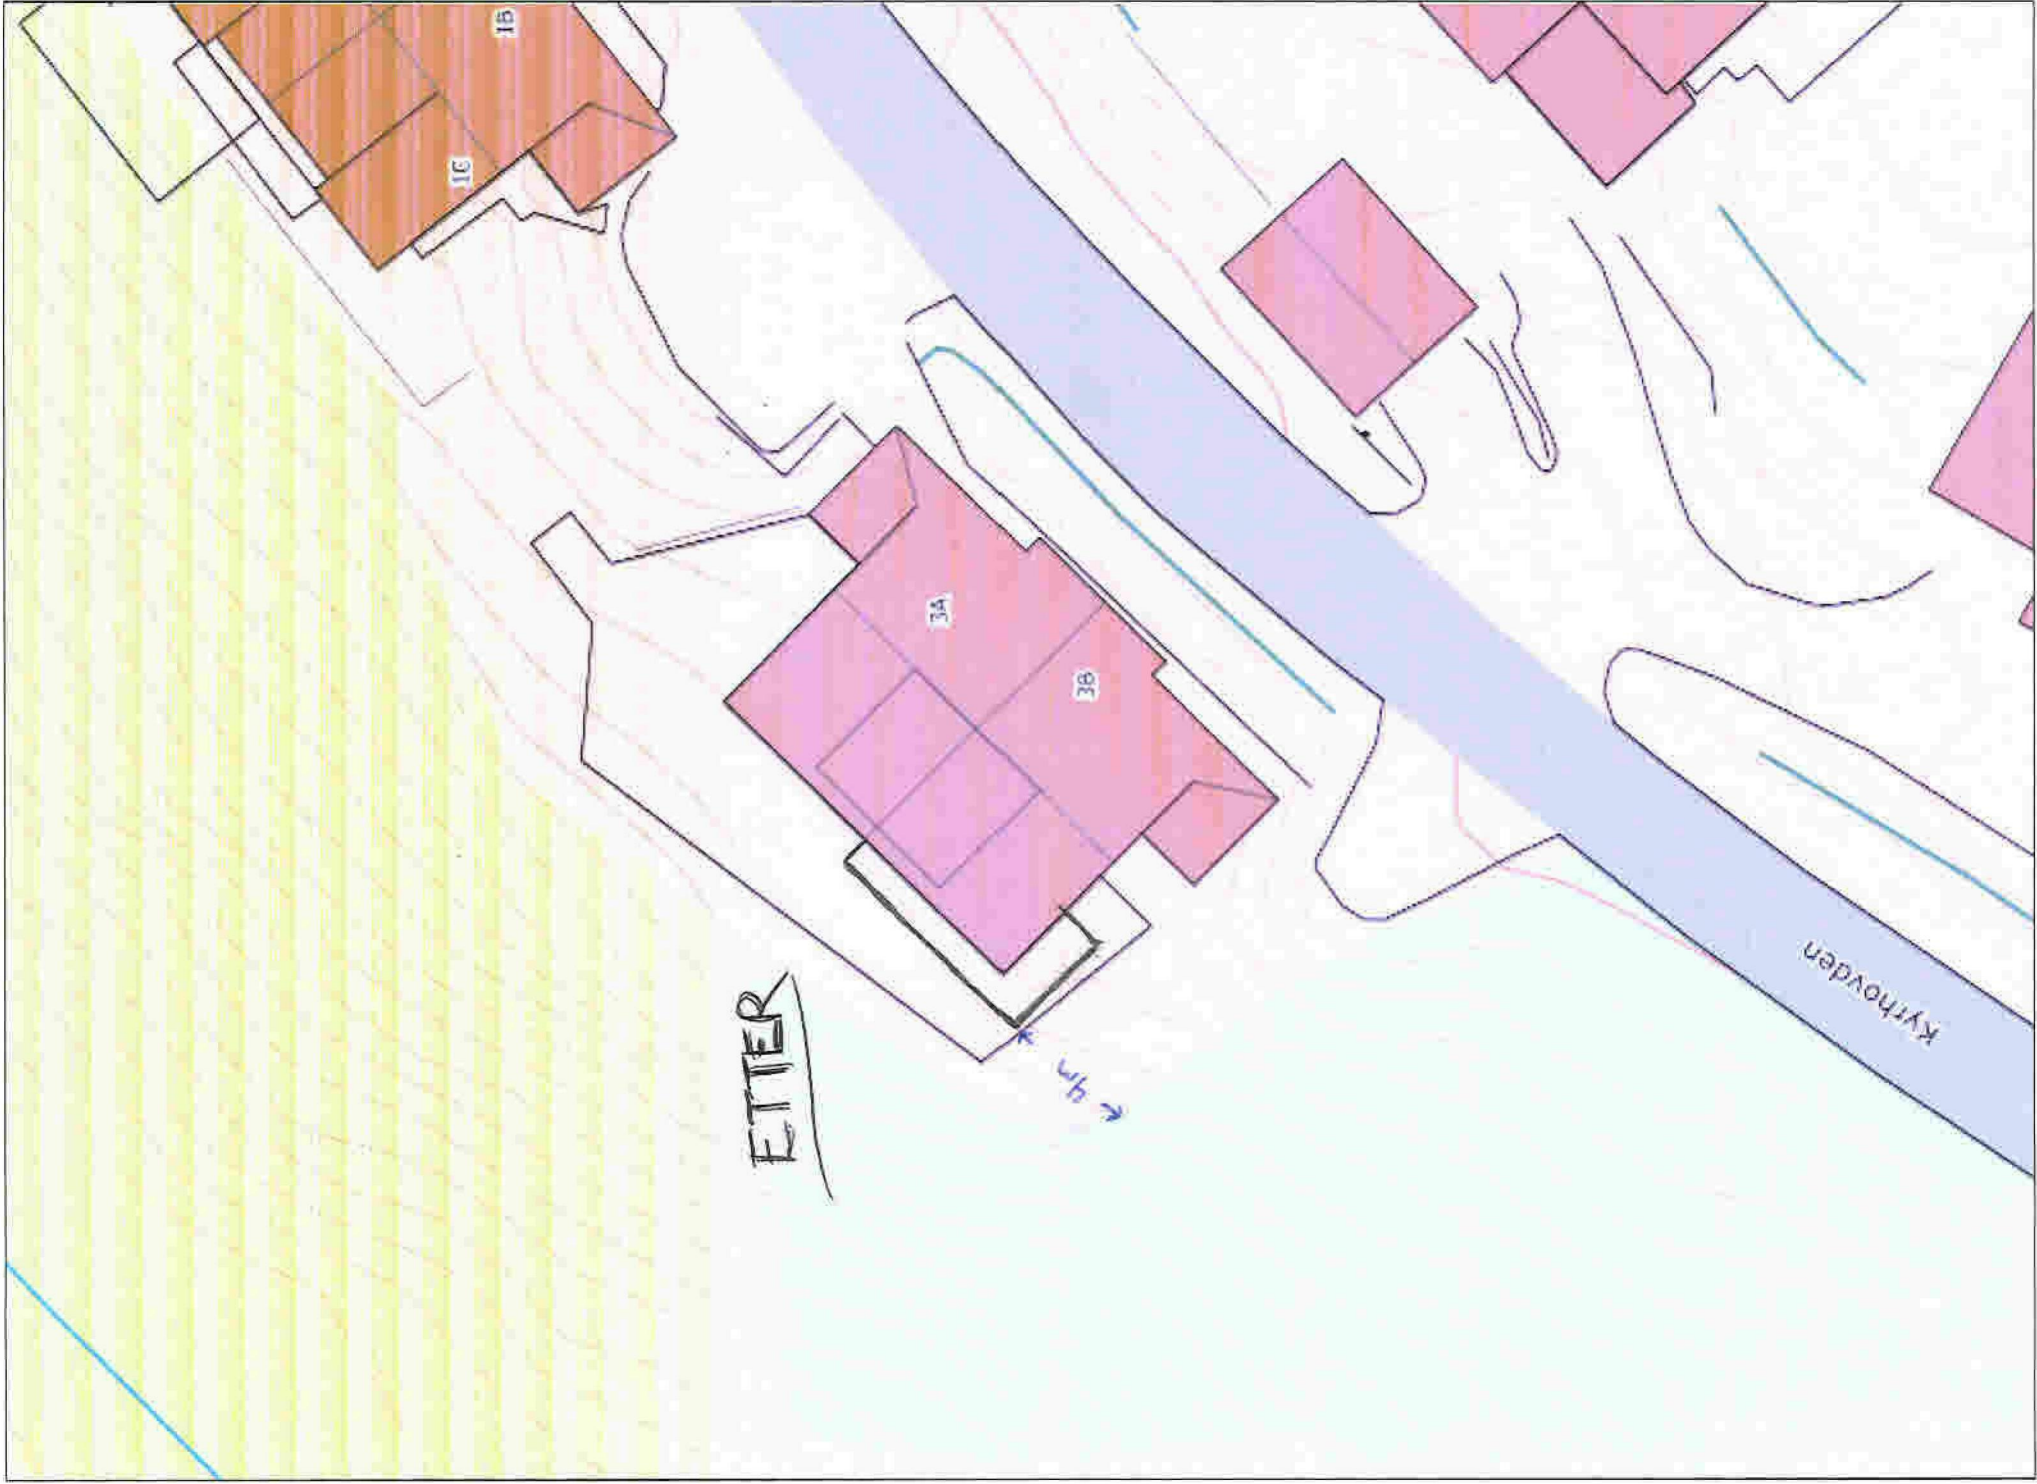

ETTER

→ 4m

Kyrhovden

34

36

15

16