

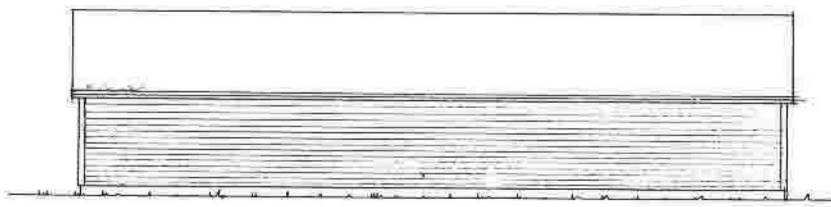


Prosj. lagerlokale på gbnr. 123/4, Alver kommune.
 Plan, Snitt – og gavlfasader i Mål = 1 : 100, langfasadene i Mål = 1 : 200
 Seim, 22.11.2021, Arkitekt Knut Willie Jacobsen



Wf. rettet: 25.02.22

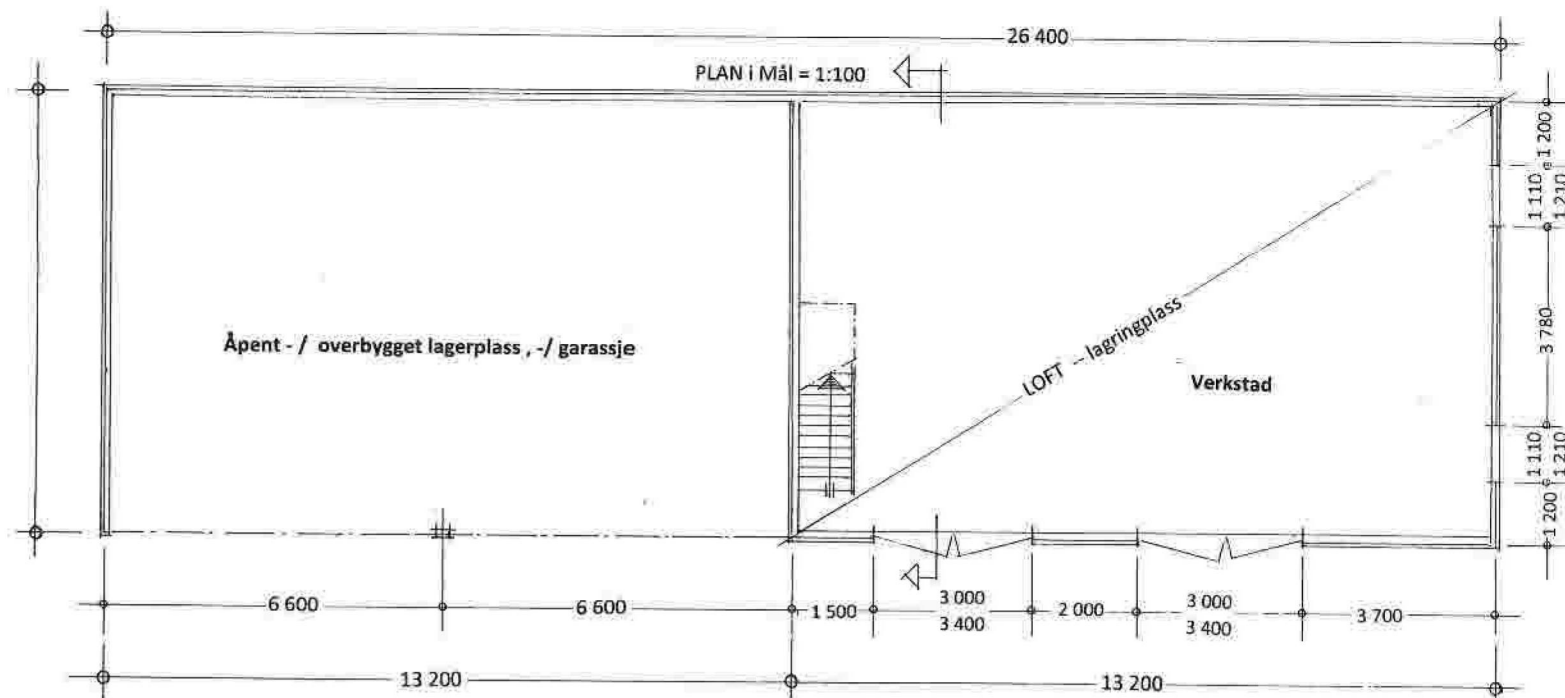

Fasade mot SYD

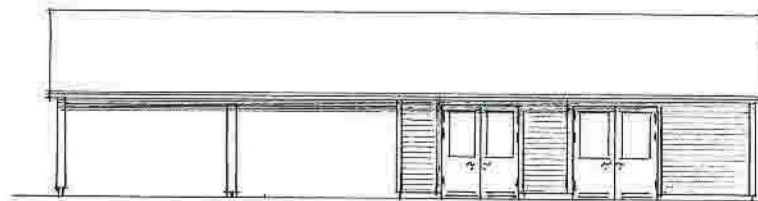

Fasade mot NORD





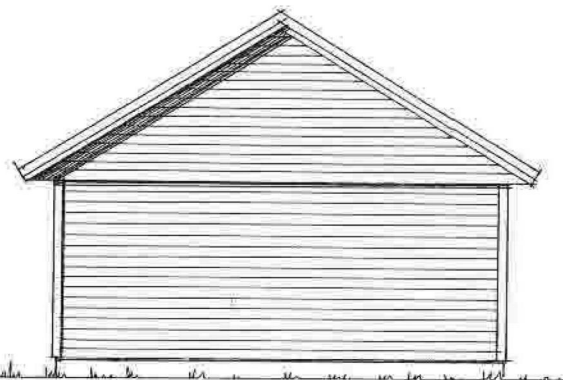
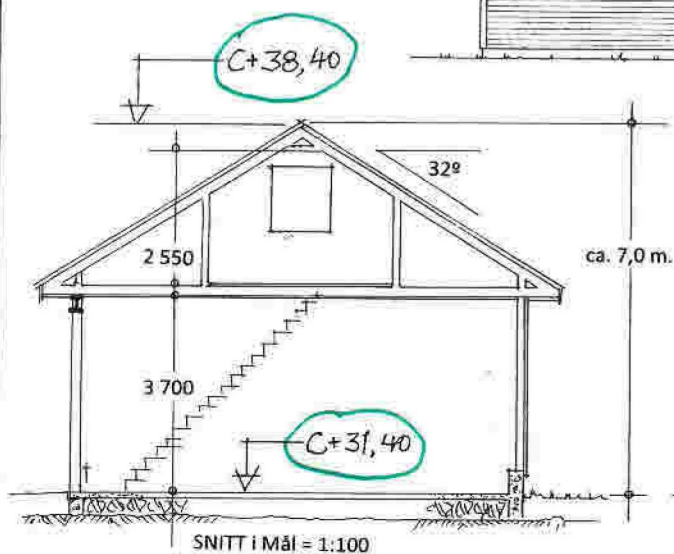


Fasade mot AUST



Fasade mot VEST

Prosj. lagerlokale på gbnr. 123/4, Alver kommune.
 Plan, Snitt - og gavlfasader i Mål = 1 : 100 , langfasadene i Mål = 1 : 200
 Seim , 22.11.2021, Arkitekt Knut Willie Jacobsen
AWP: rettet : 25.02.22

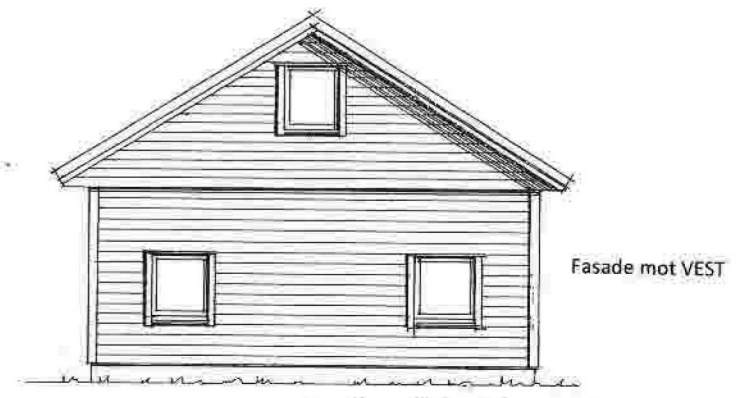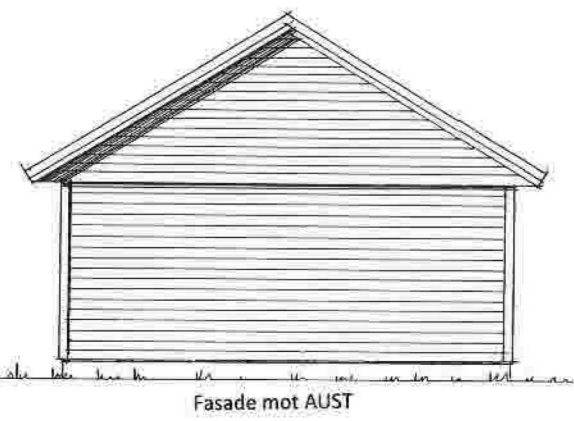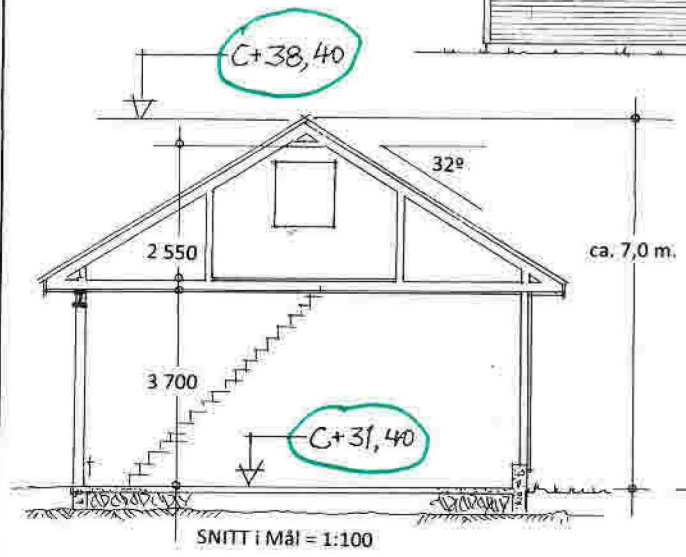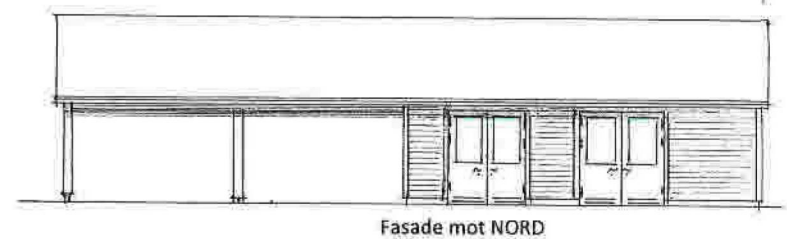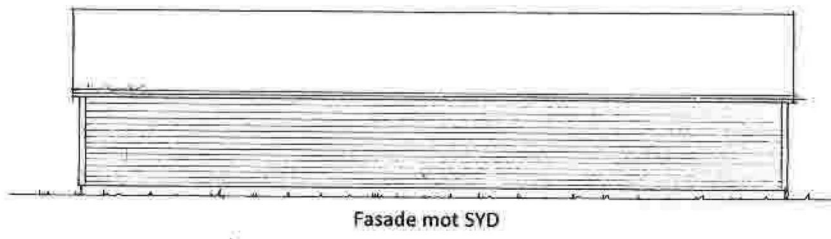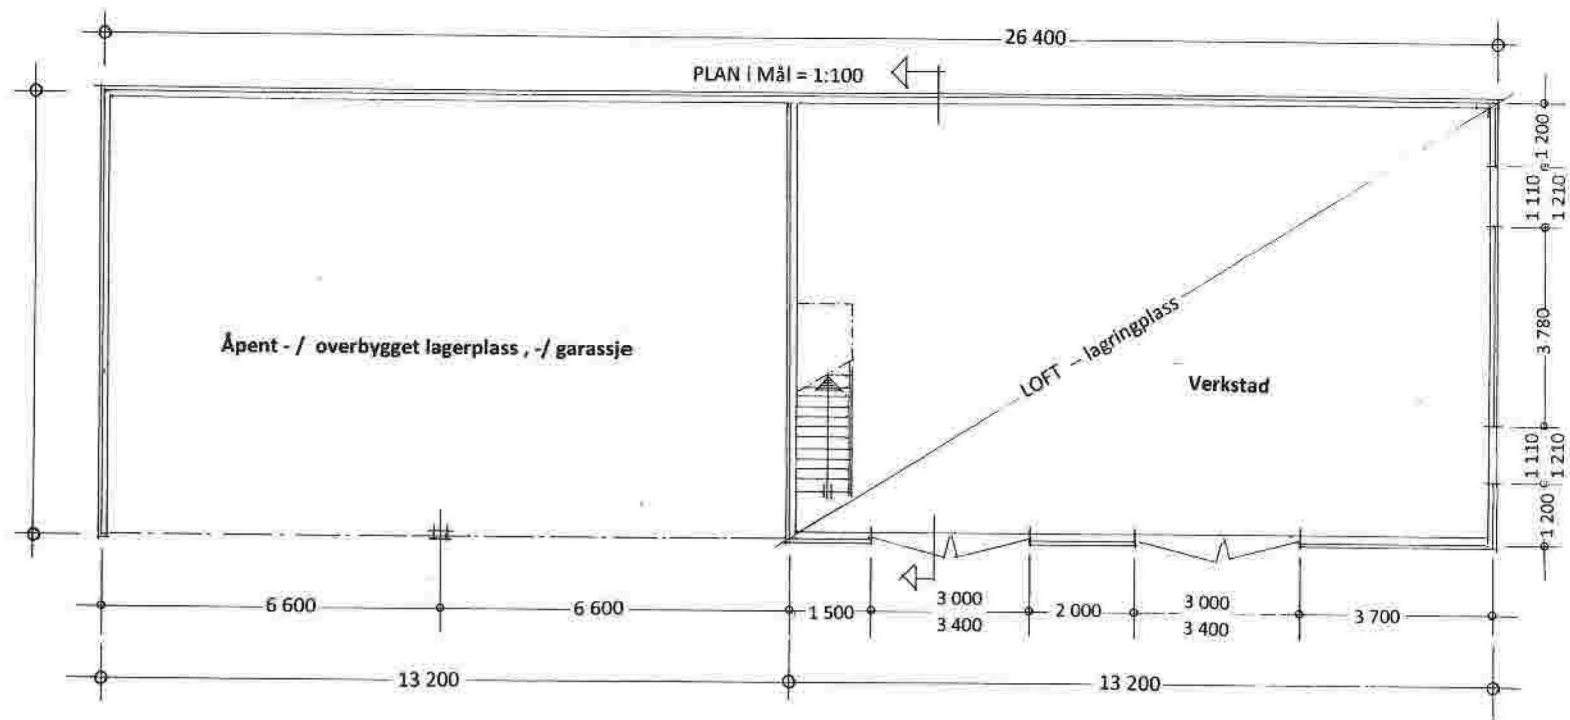

Proj. lagerlokale på gbnr. 123/4, Alver kommune.
 Plan, Snitt – og gavifasader i Mål = 1 : 100 , langfasadene i Mål = 1 : 200
 Seim , 22.11.2021 , Arkitekt Knut Willie Jacobsen
AWP: rettet: 25.02.22