

Rolf Helle bø

Daf. 21/1081 - 22/12013 / adm. Åmundsleirel 97, 5115  
Ulsel.

## Fløysand VVAs


Rørlegger

Mob. 952 73 505

Fløysand, 5918 Frekhaug

Org.nr.: No 987 774 525 MVA

Daf. 21/1081 - 22/12013 / adm. Åmundsleirel 97, 5115  
Ulsel.

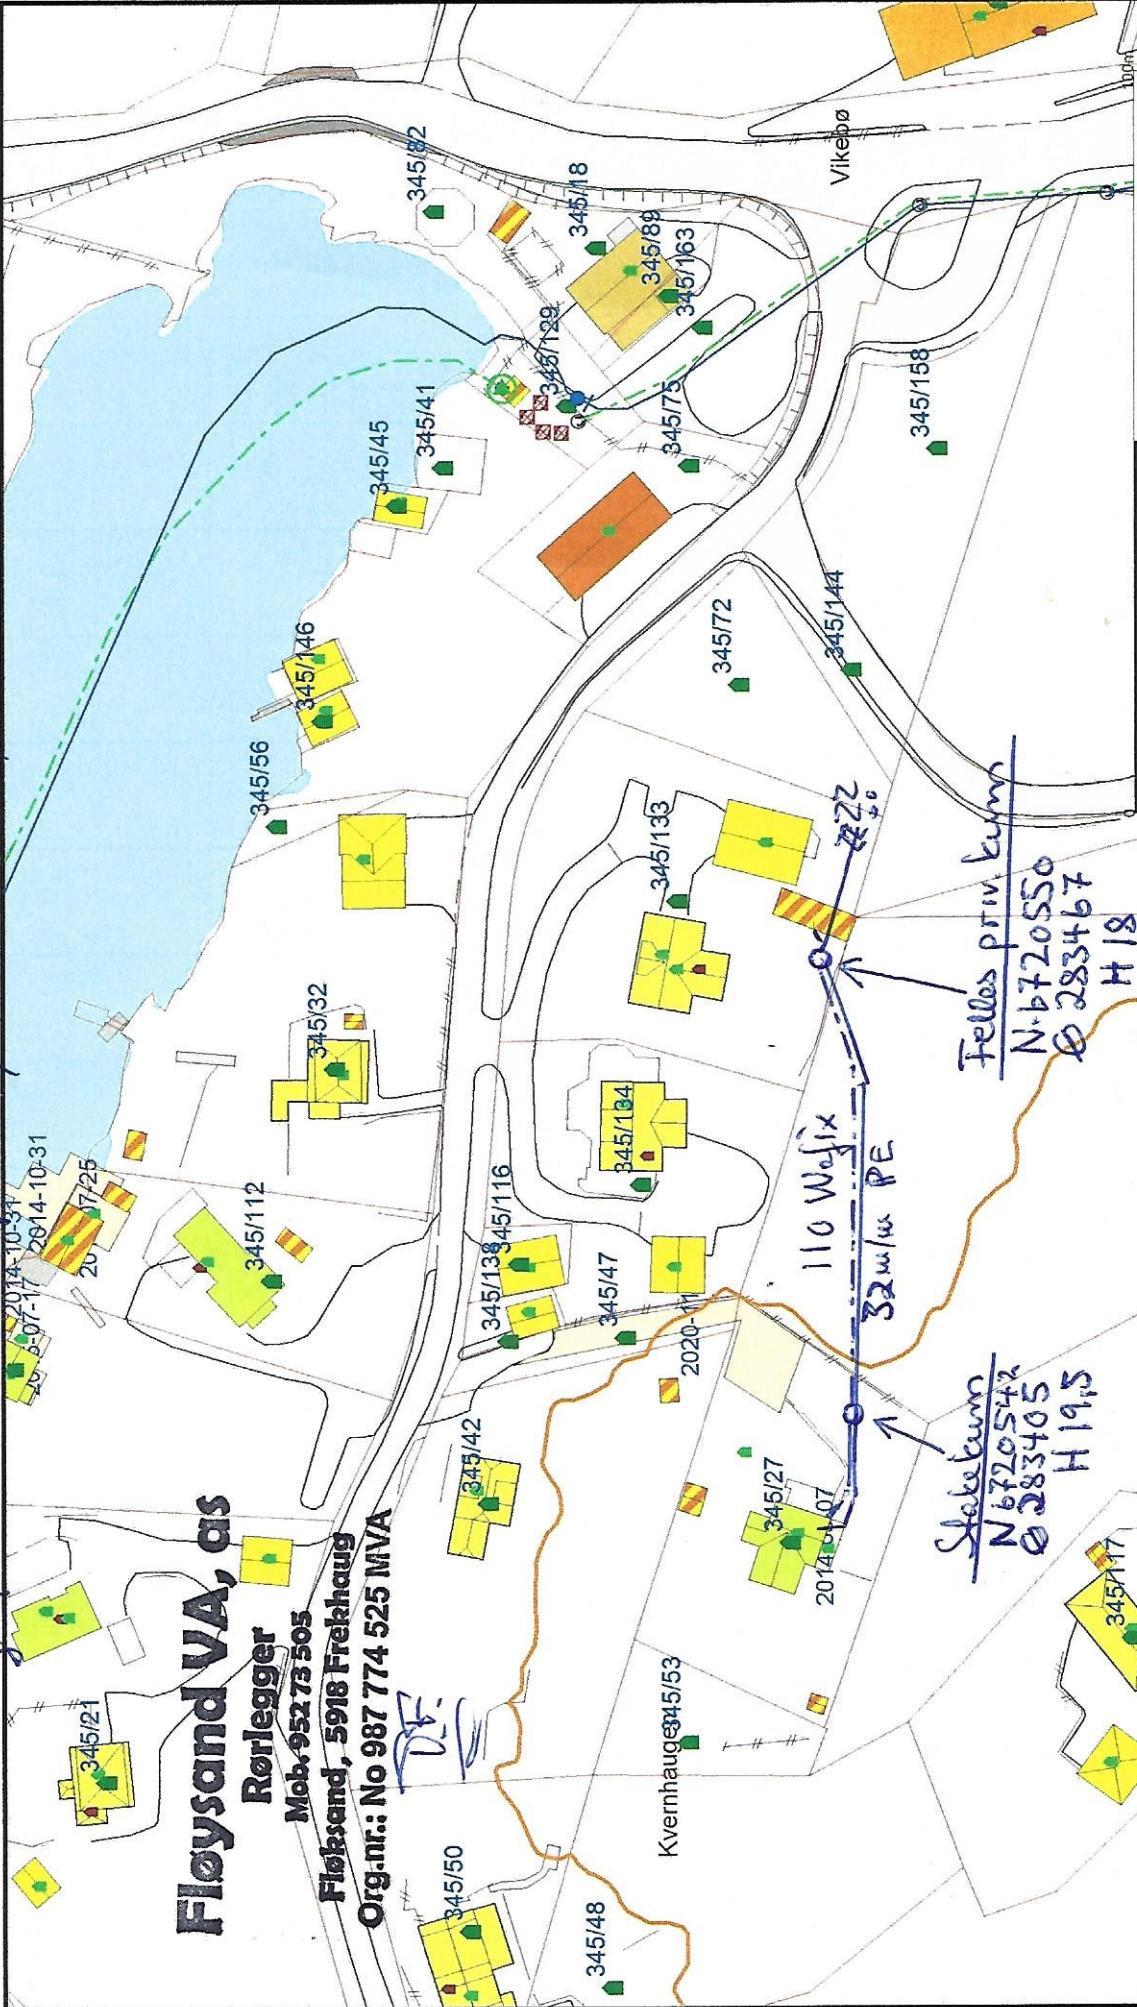

Alver kommune VVAs Avdeling	N	1:1000
	Date: 2022.02.16	Sign: AH
Hovedoppbevaring i felles kunn i rettet. D.G.A. varmebalvel i rettet. Har ikke fekket inn i felles ledninger og ikke velle vell + rase (har dat som munneide)		

Daf. Margaret Halland