


352.17

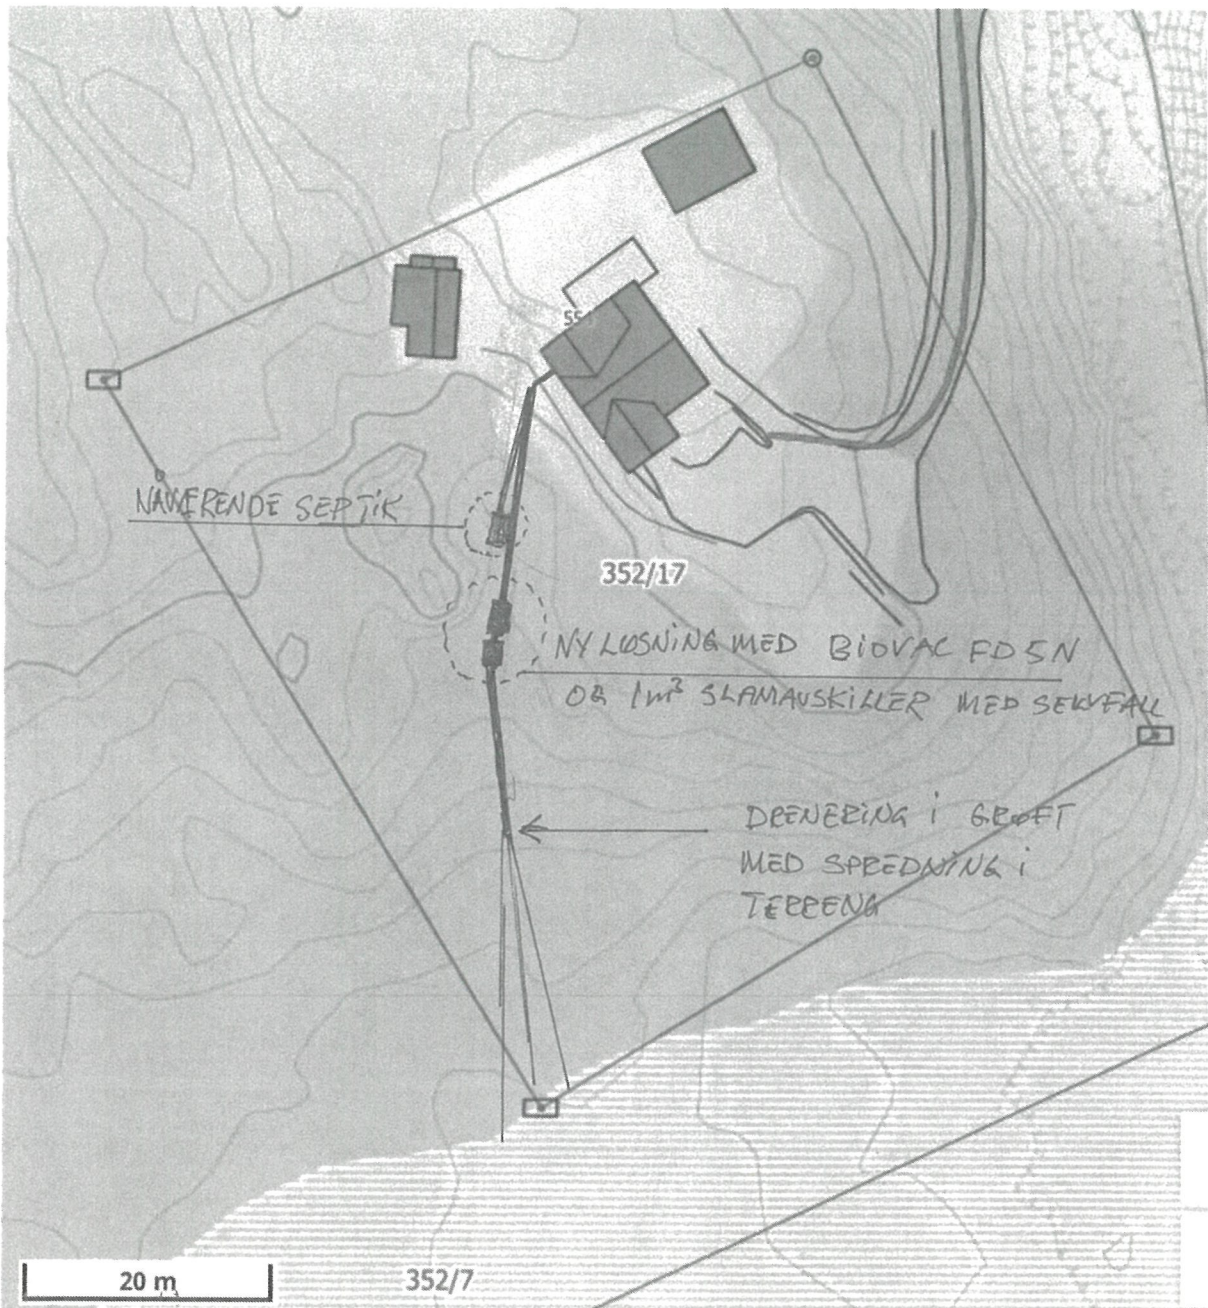

Søknad om
utslipp sendt.
16/3-22 MNS
Ref 18XMTG

ROLF SVENDSEN
NEDSETTING BIOVAC
RENSEANLEGG
Gnr 352 Br.nr. 17
Tlf: 958 76762
mail: suendsen.rolf@gmail.com