


KART
 over
 Indmarten tilhørende Gaarden
VIKEBO

Gaards-nr. 102 i Herlvs Herred,
 Søndre Bergenhus Amt.

Optaget Aar 1903
 af
 V. Winterthun.

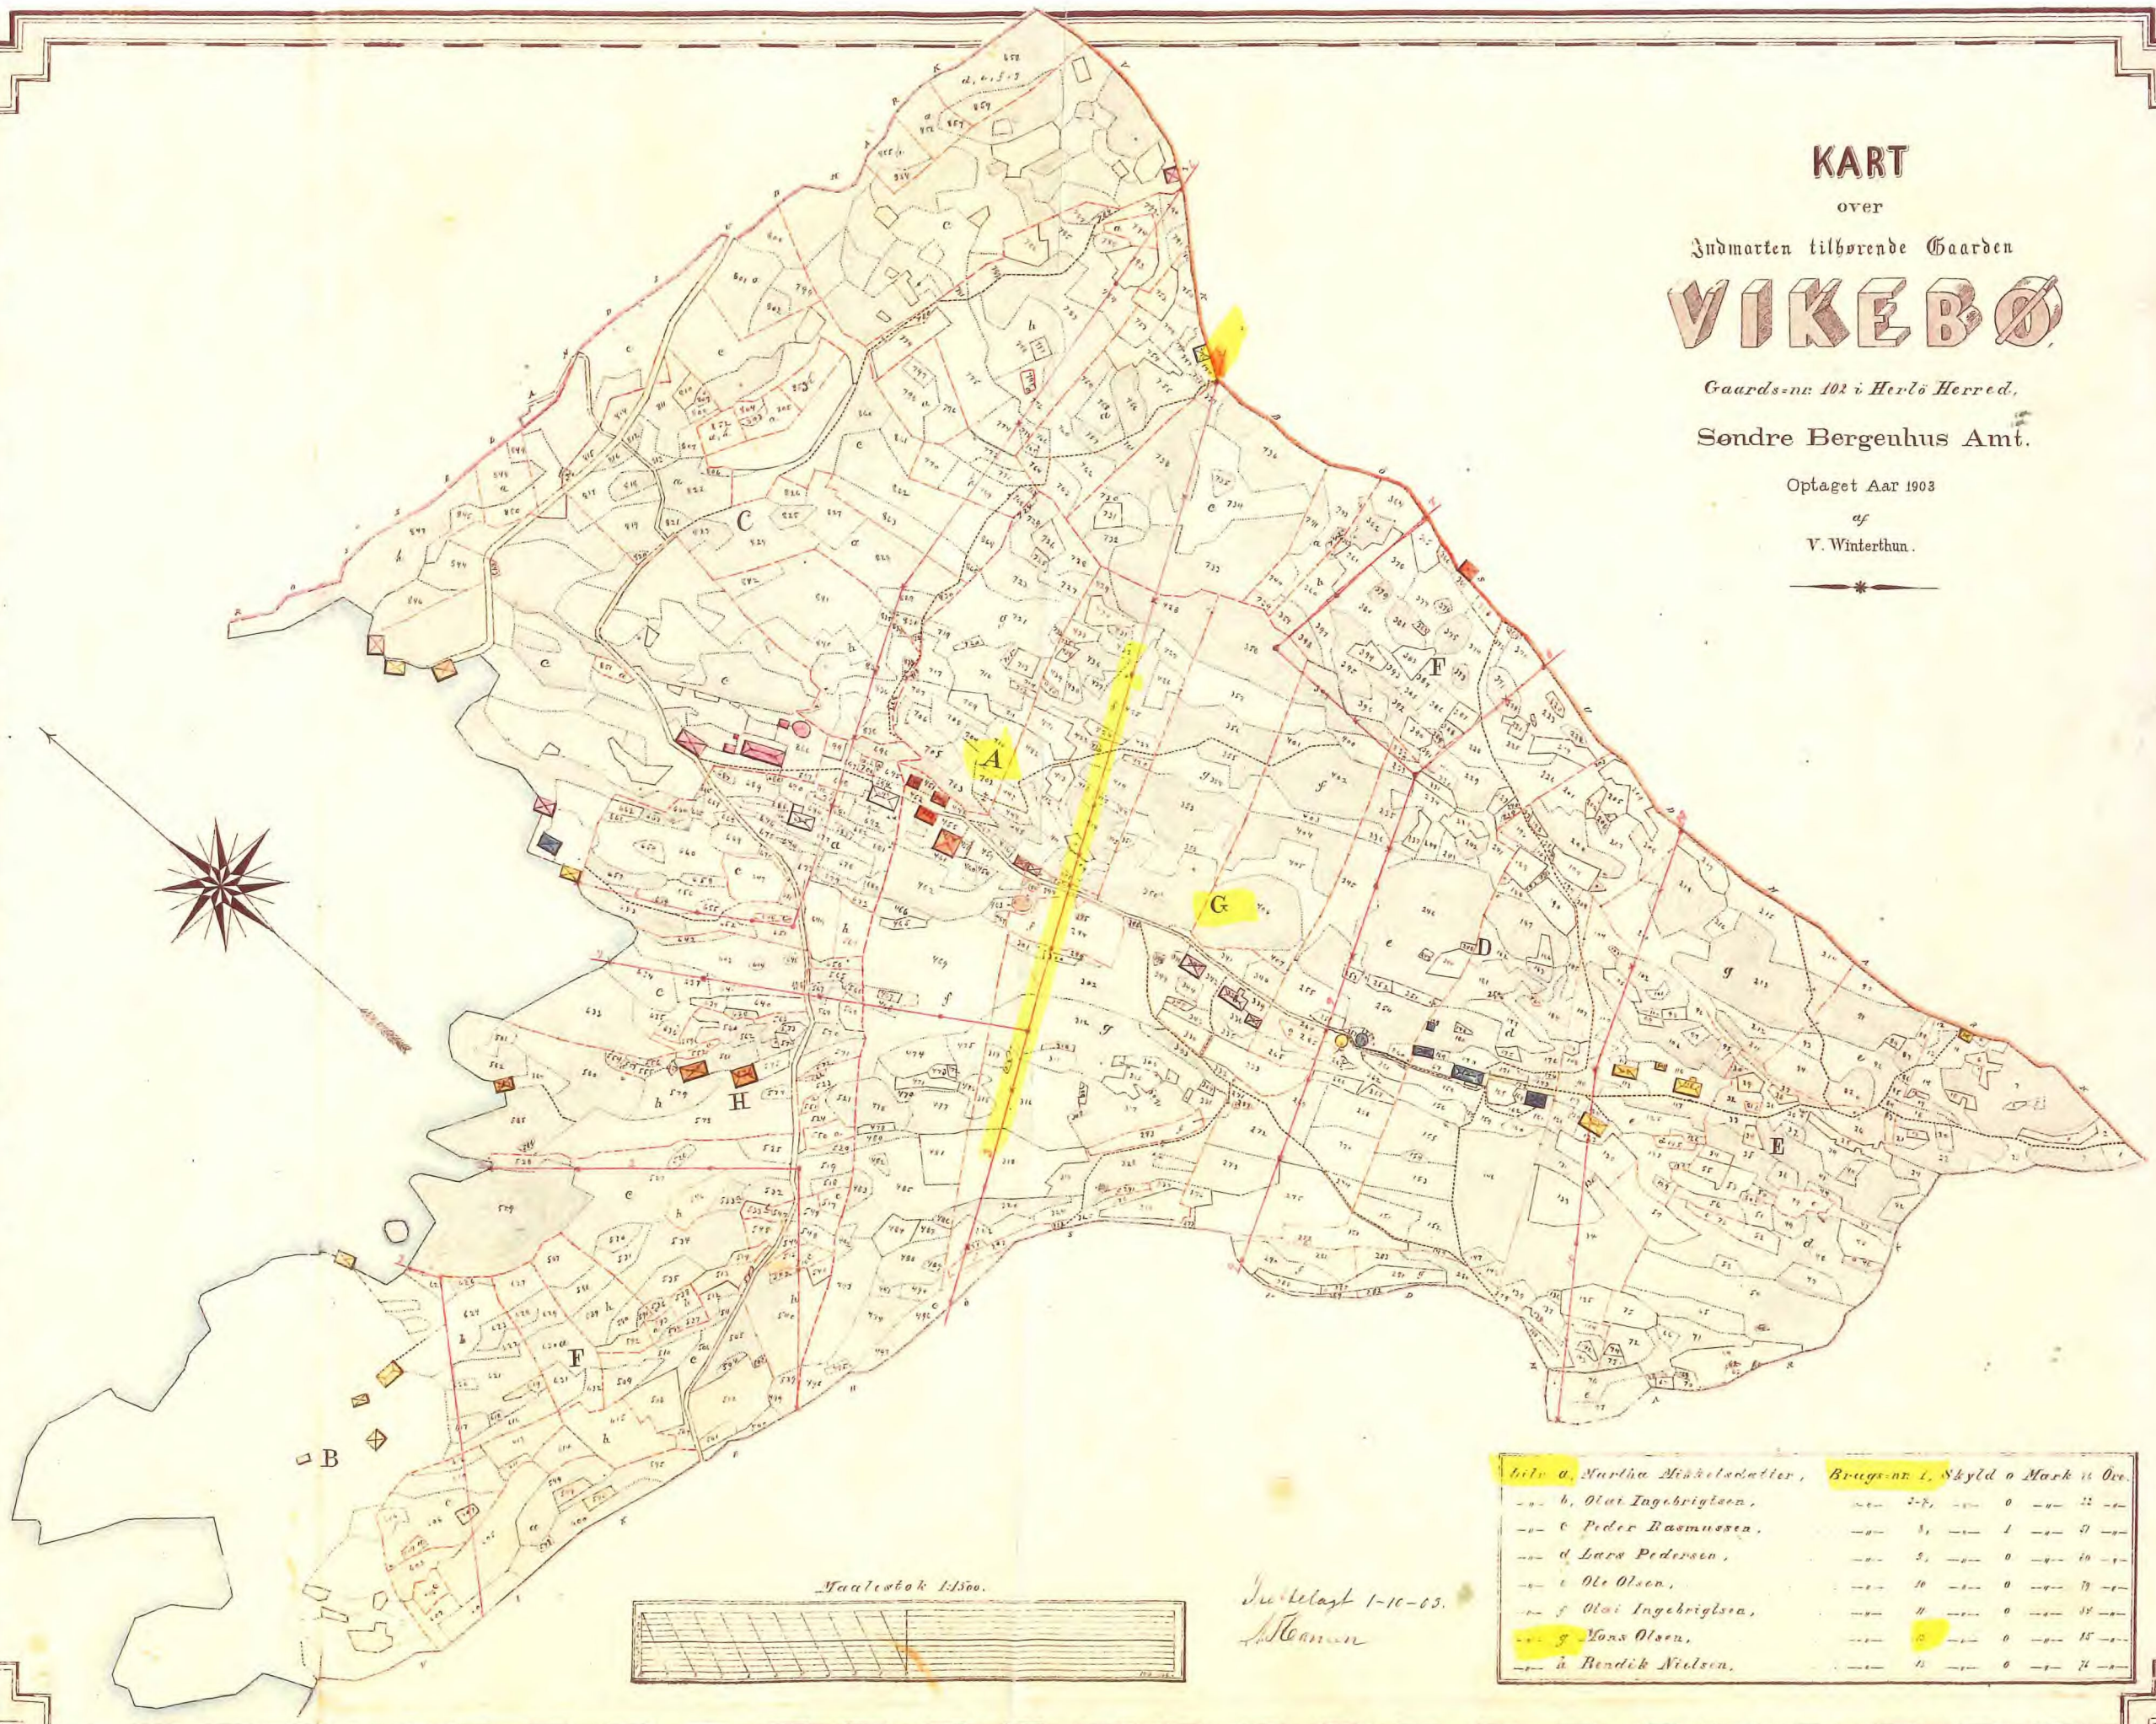


Maalstab 1:1500.



Ju. tilagt 1-10-03.
 Hønen

Lige a. Martha Mikkeladatter, Brugs-nr. 1, Skyld o Mark u. Ov.	
b. Olof Ingebrigtsen,	2-8, 0 - 22 -
c. Peder Rasmussen,	1, 1 - 31 -
d. Lars Pedersen,	3, 0 - 60 -
e. Ole Olsen,	10, 0 - 70 -
f. Olof Ingebrigtsen,	11, 0 - 18 -
g. Mons Olsen,	5, 0 - 15 -
h. Bendik Nielsen,	12, 0 - 74 -


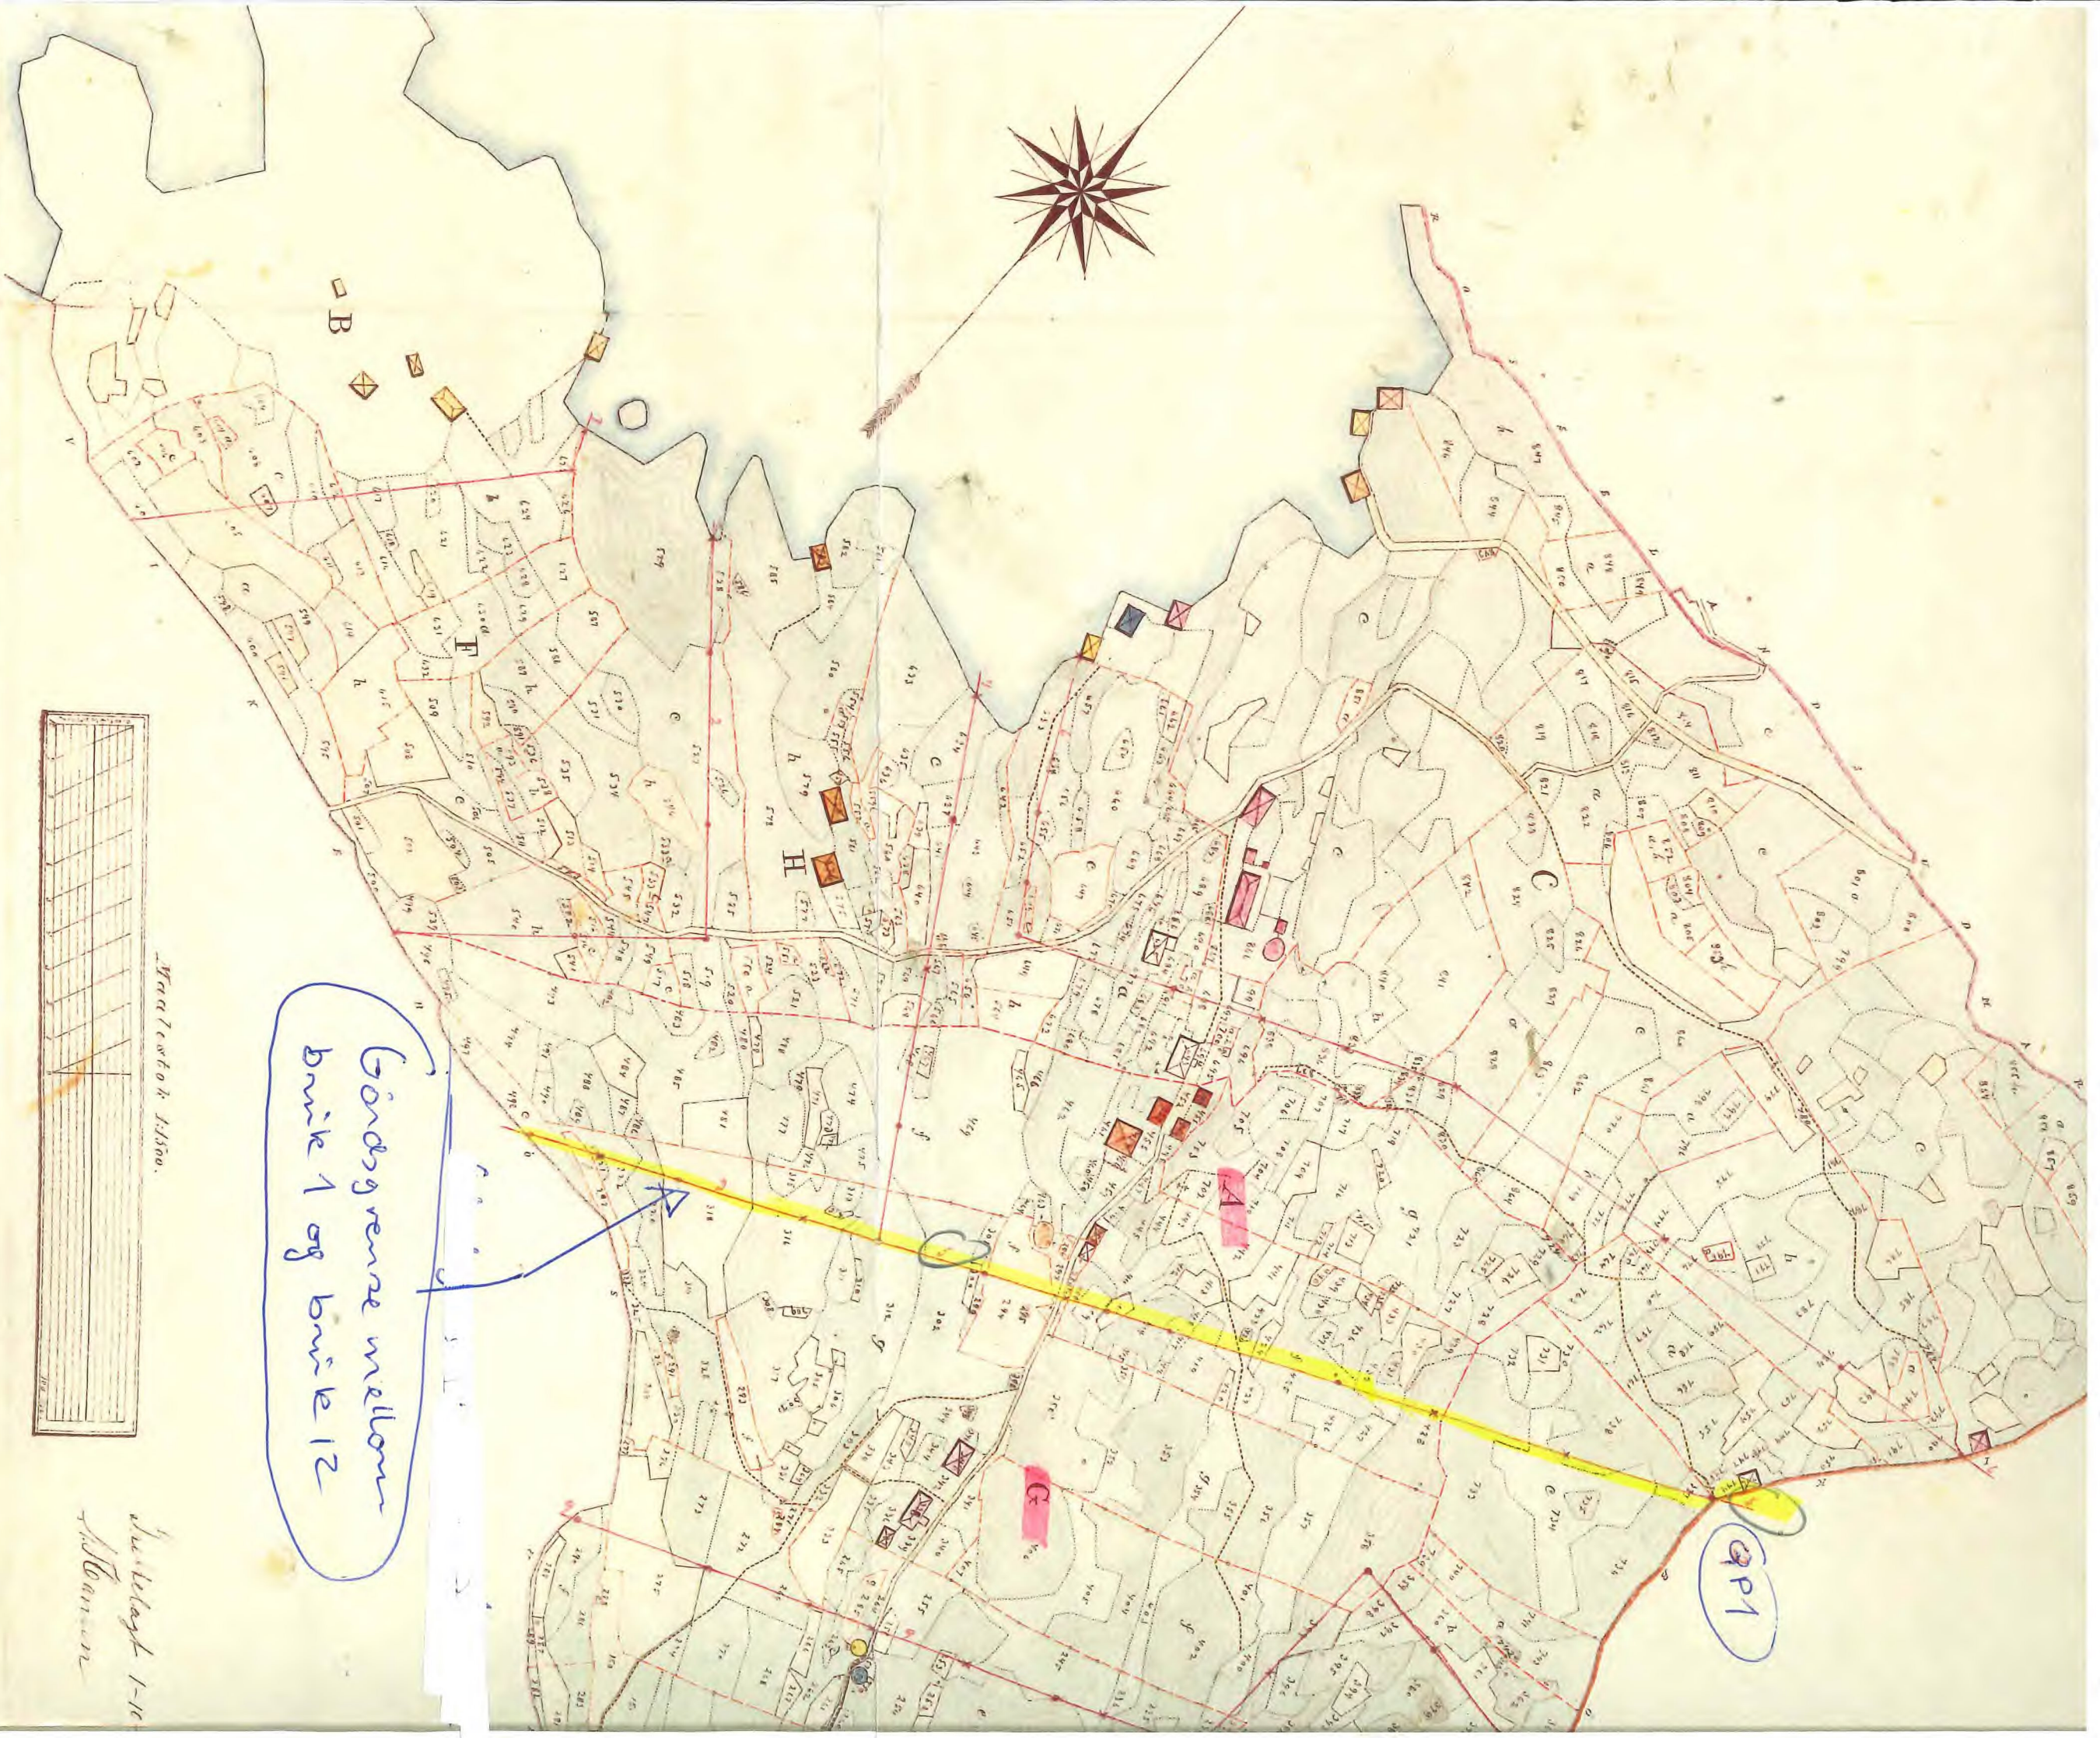

Bördsgrænse mellem
brik 1 og brik 12




