


Vedlegg Q1

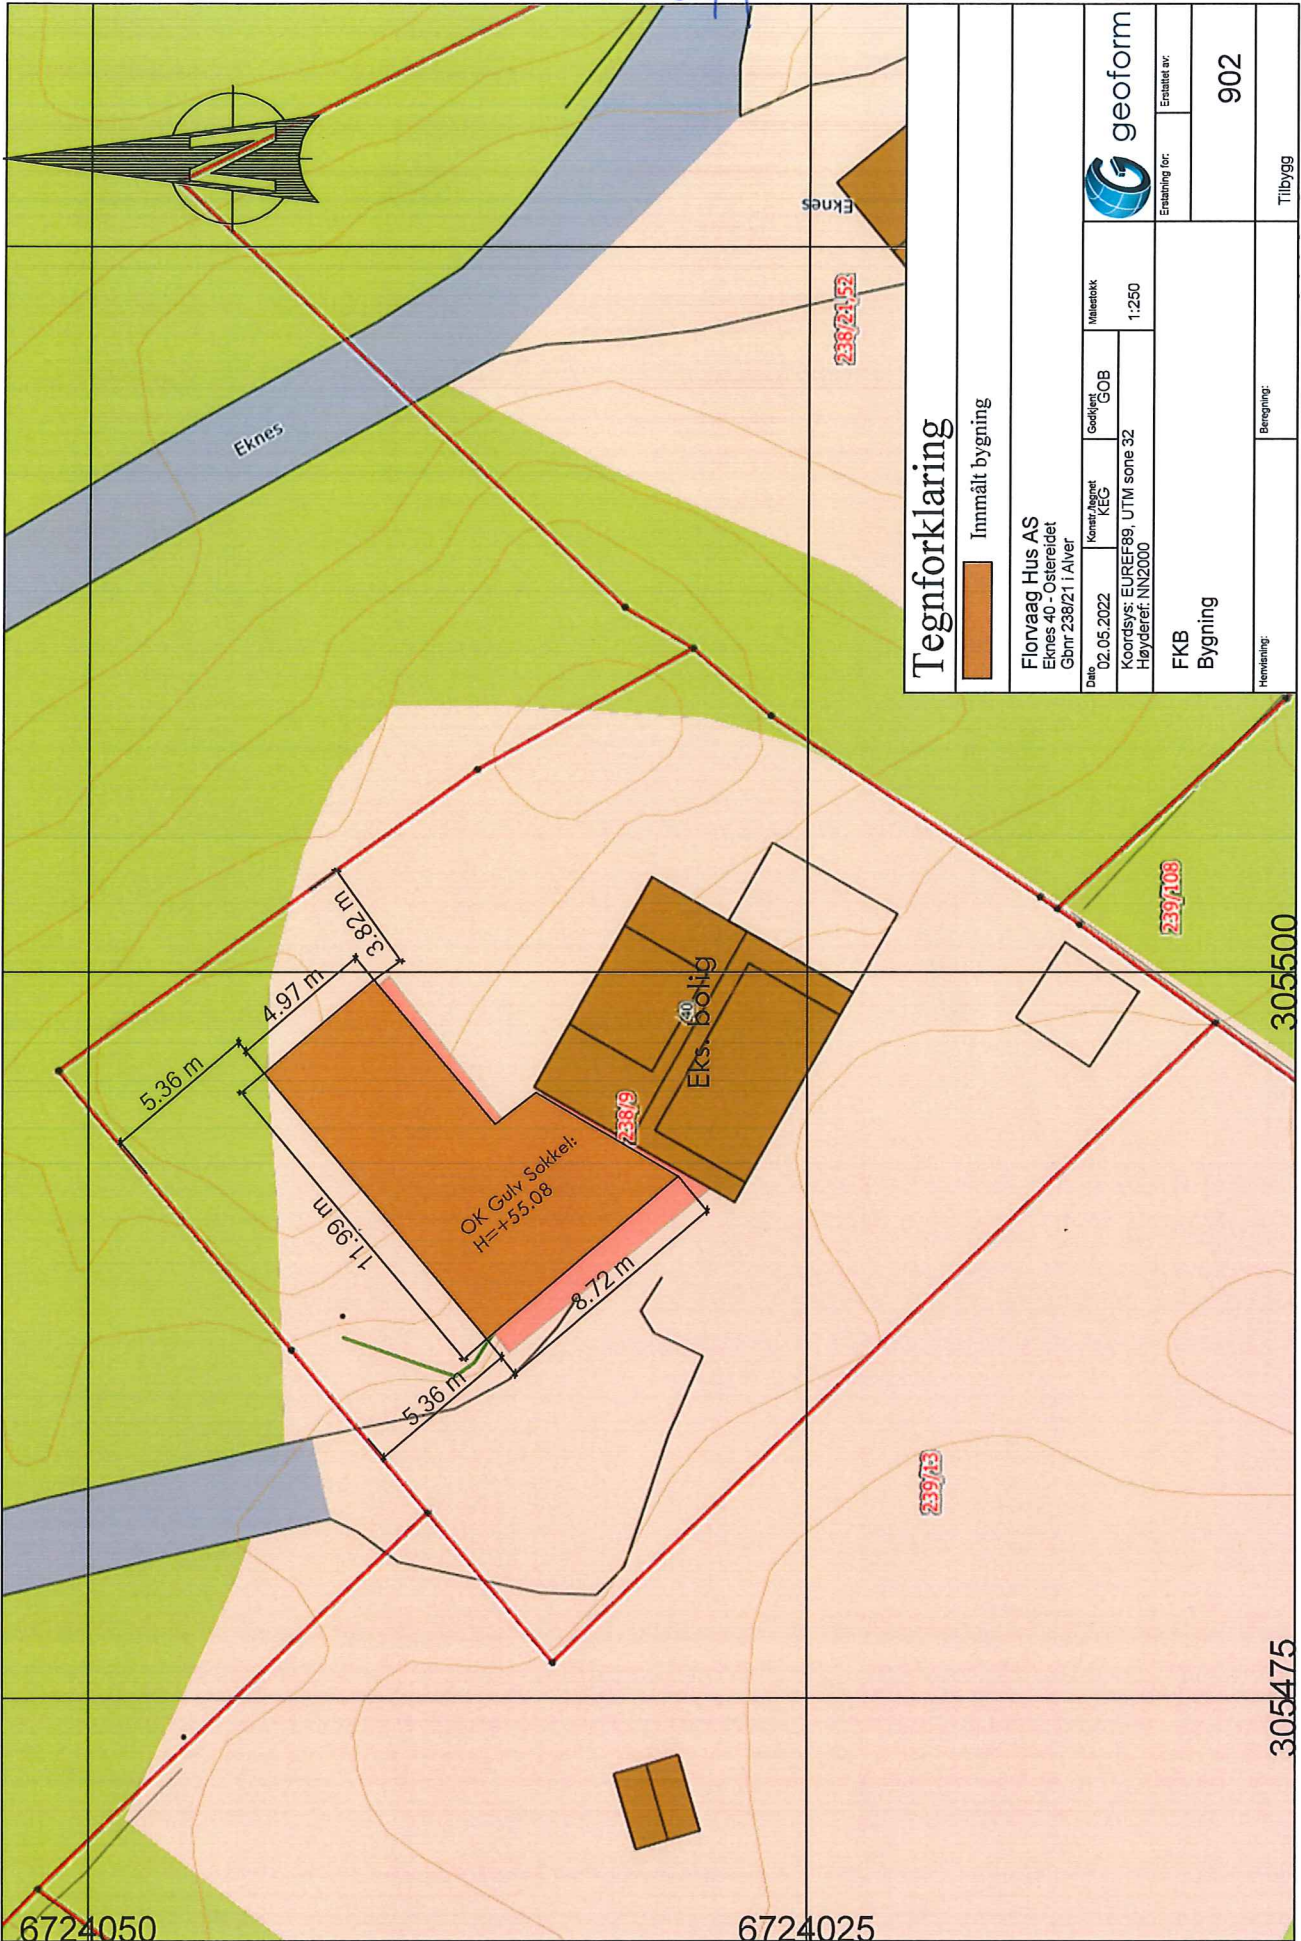


Tegnforklaring

 Innmålt bygning

Florvaag Hus AS
Eknes 40 - Osterelidet
Gbnr 238/21 i Alver

Dato: 02.05.2022	Konr./Agnet: REG	Godkjert: GOB	Målestokk: 1:250
------------------	------------------	---------------	------------------

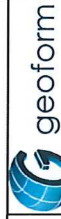

Erstatte nr:

902

Tilbygg

Heravhengig:

Beregning:

305500

305475

6724050

6724025

Eknes

Eknes

238/21/2

239/108

239/13

OK Gultv. Sakkei:
H=+55.08

Eknes 40
Boltig

5.36 m
4.97 m
3.82 m
11.99 m
5.36 m

8.72 m