
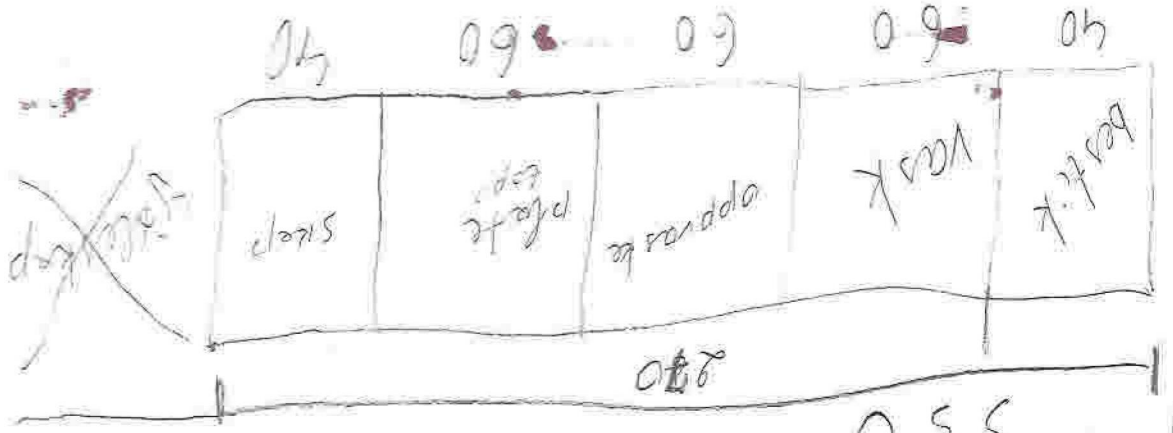
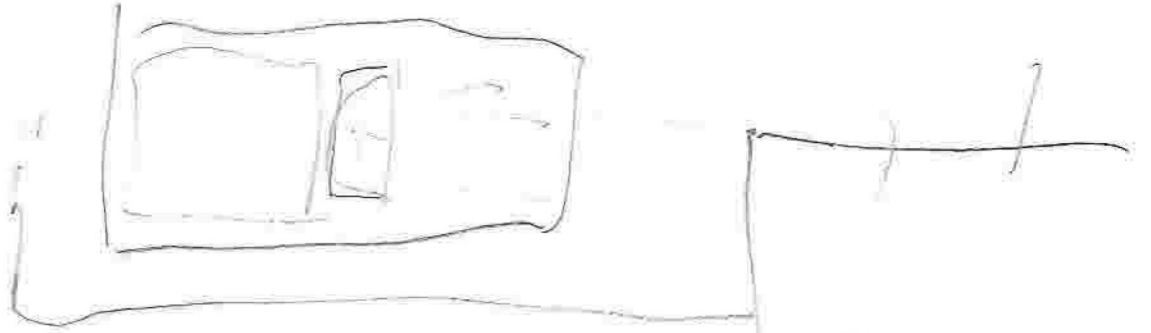


SMUR
PLASS

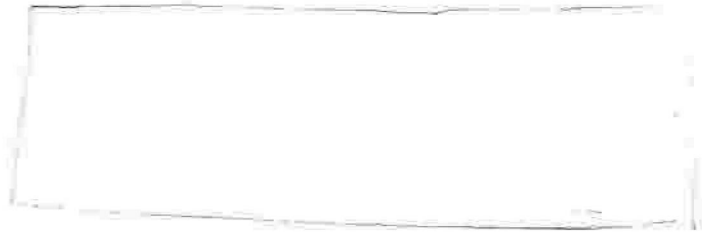

door + box