


D1

15/10-21
H.S.

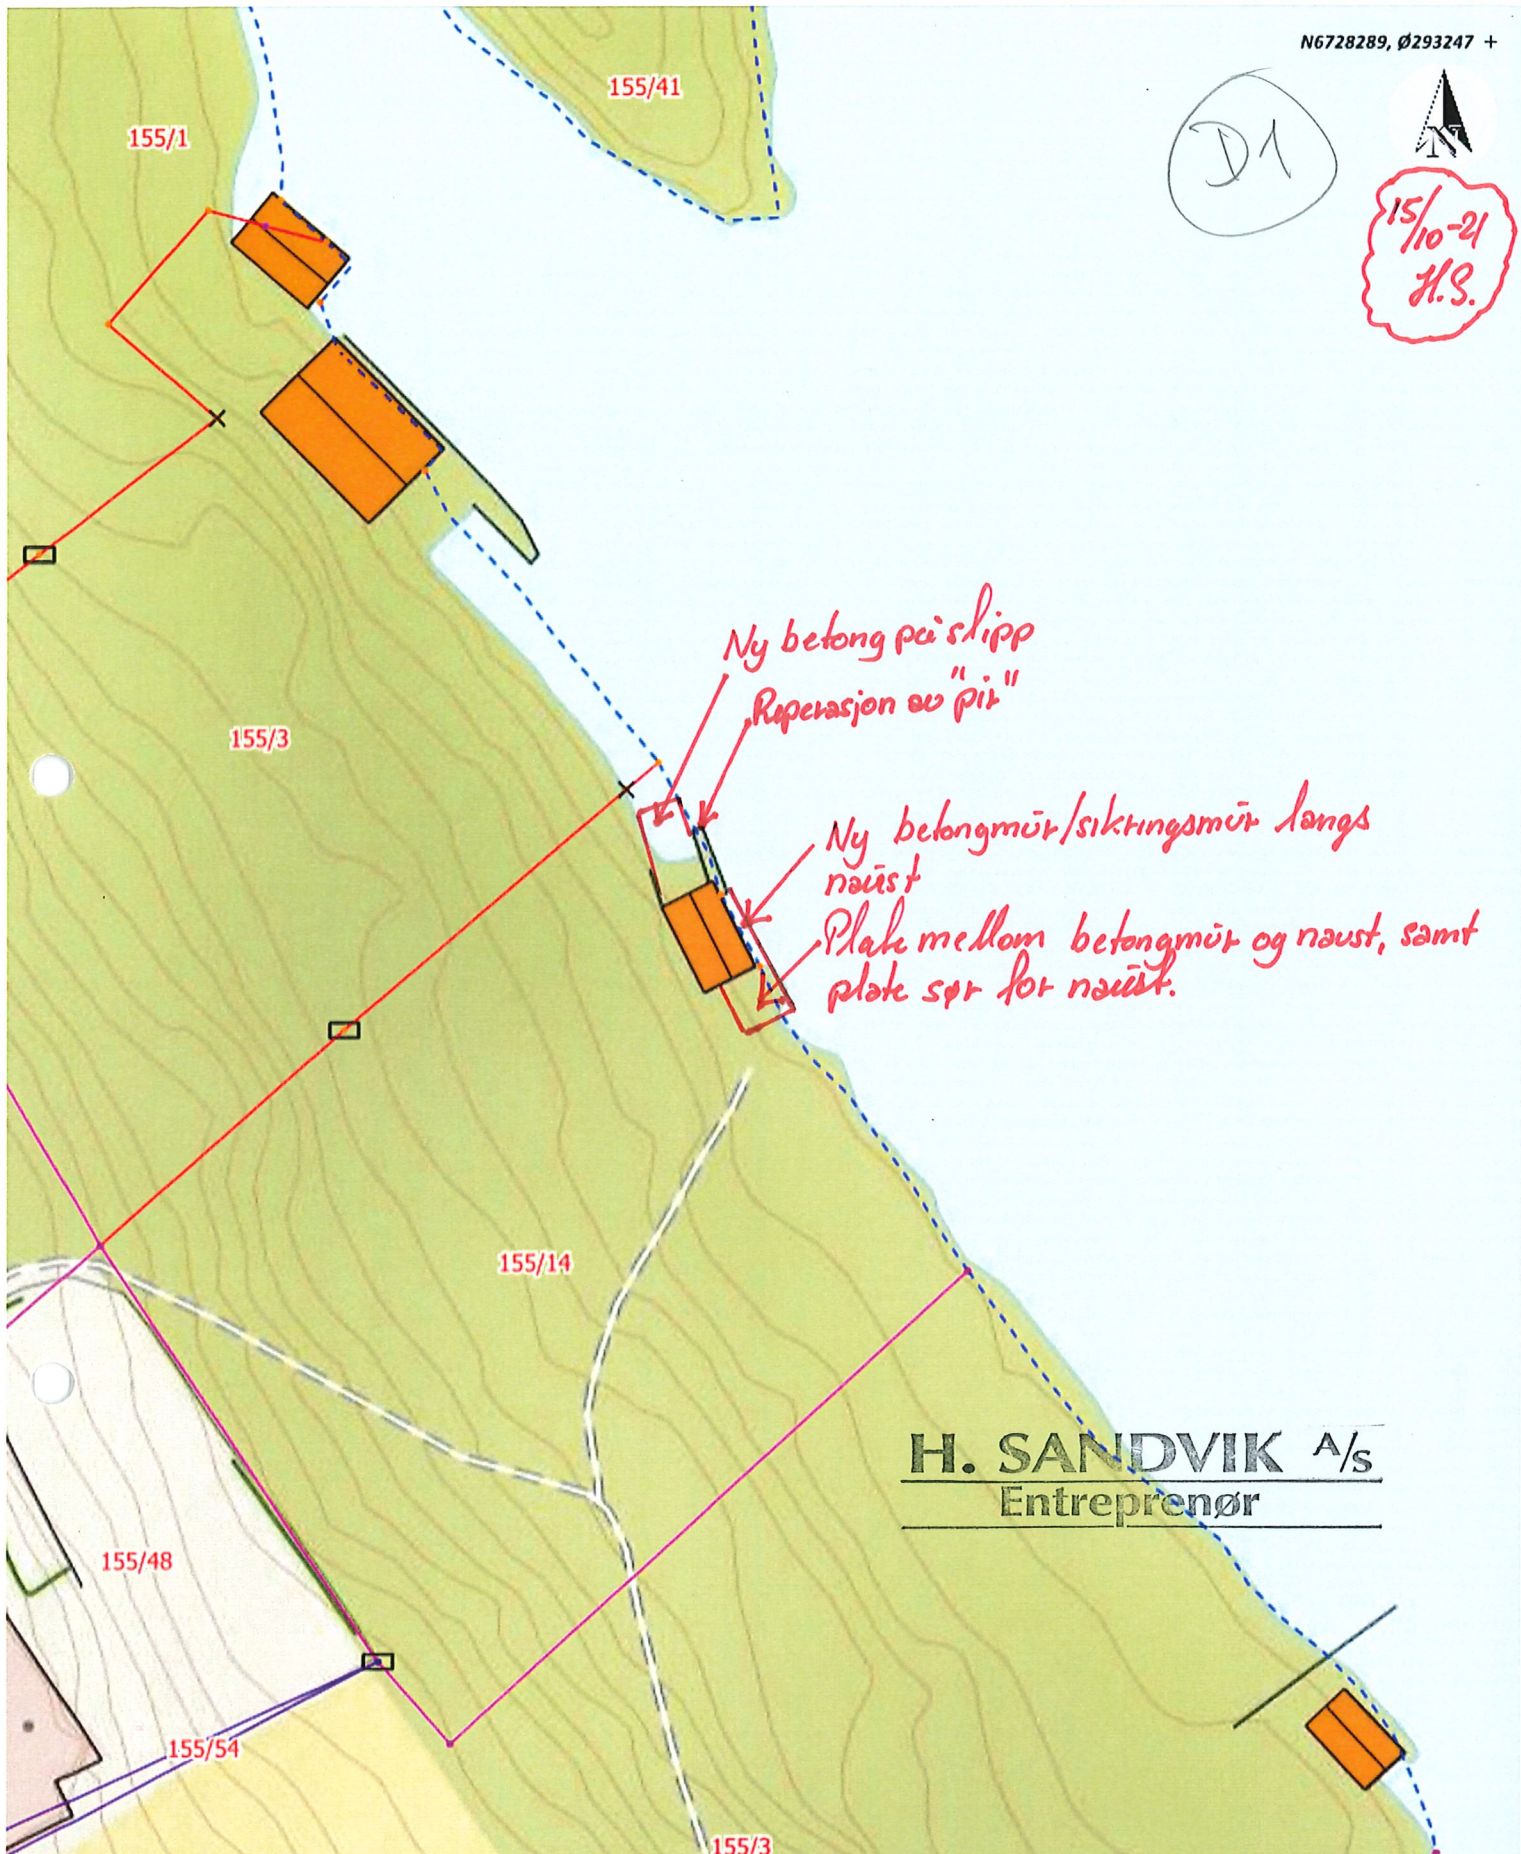

Situasjonskart - 155/14
ALVER KOMMUNE



Dato: 13-10-2021

Målestokk: 1:500
15m