


**Etg 1**  
1 : 50

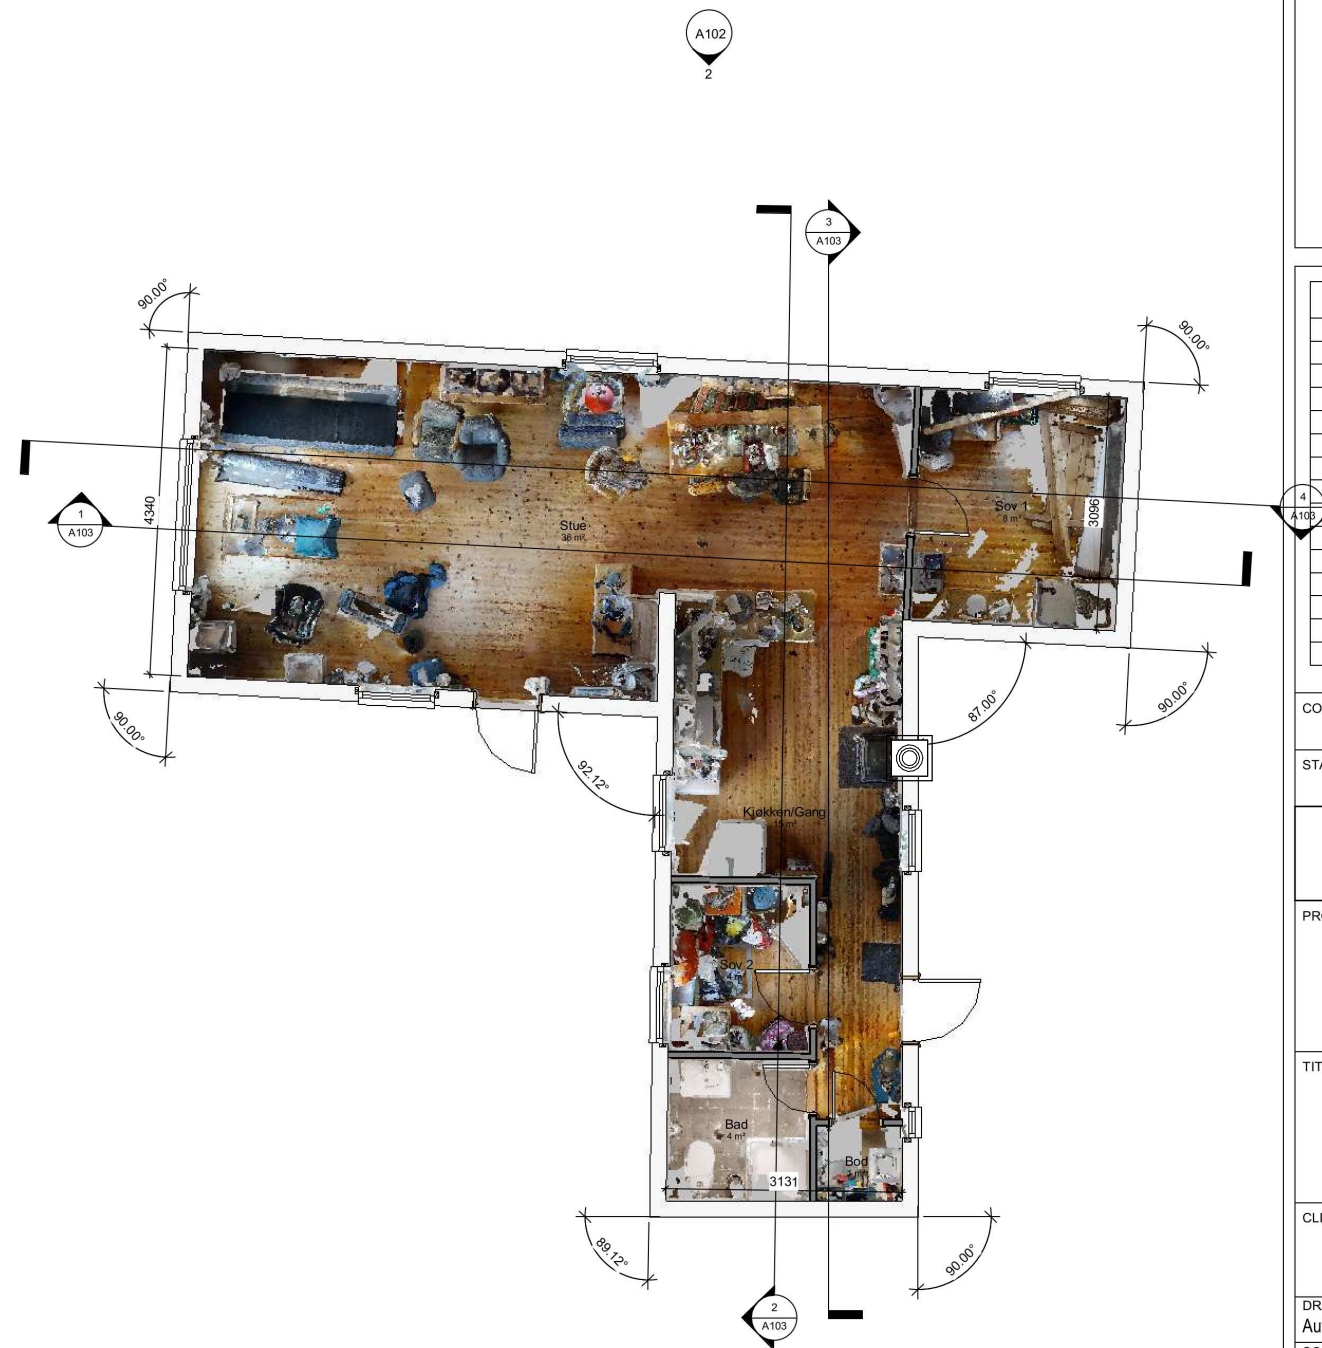

**Etg 1 (med skanning)**  
1 : 50

Rev	Description	Date

CODE	SUITABILITY DESCRIPTION
STATUS	PURPOSE OF ISSUE



PROJECT  
**Litlevaagsbrotet 26**  
**G.nr 214 B.nr 44**

TITLE  
**Plantegning**

CLIENT  
**Inge Fyllingsnes**

DRAWN BY Author	CHECKED BY Checker	DATE 01/23/07
--------------------	-----------------------	------------------

SCALE (@ A1) 1 : 50	PROJECT NUMBER Project Number
------------------------	----------------------------------

DRAWING NUMBER A101	REV
------------------------	-----