


S  M  L

FARGE:

SNAP

SLETT REDIGER

TØM AVBRYT LAGRE

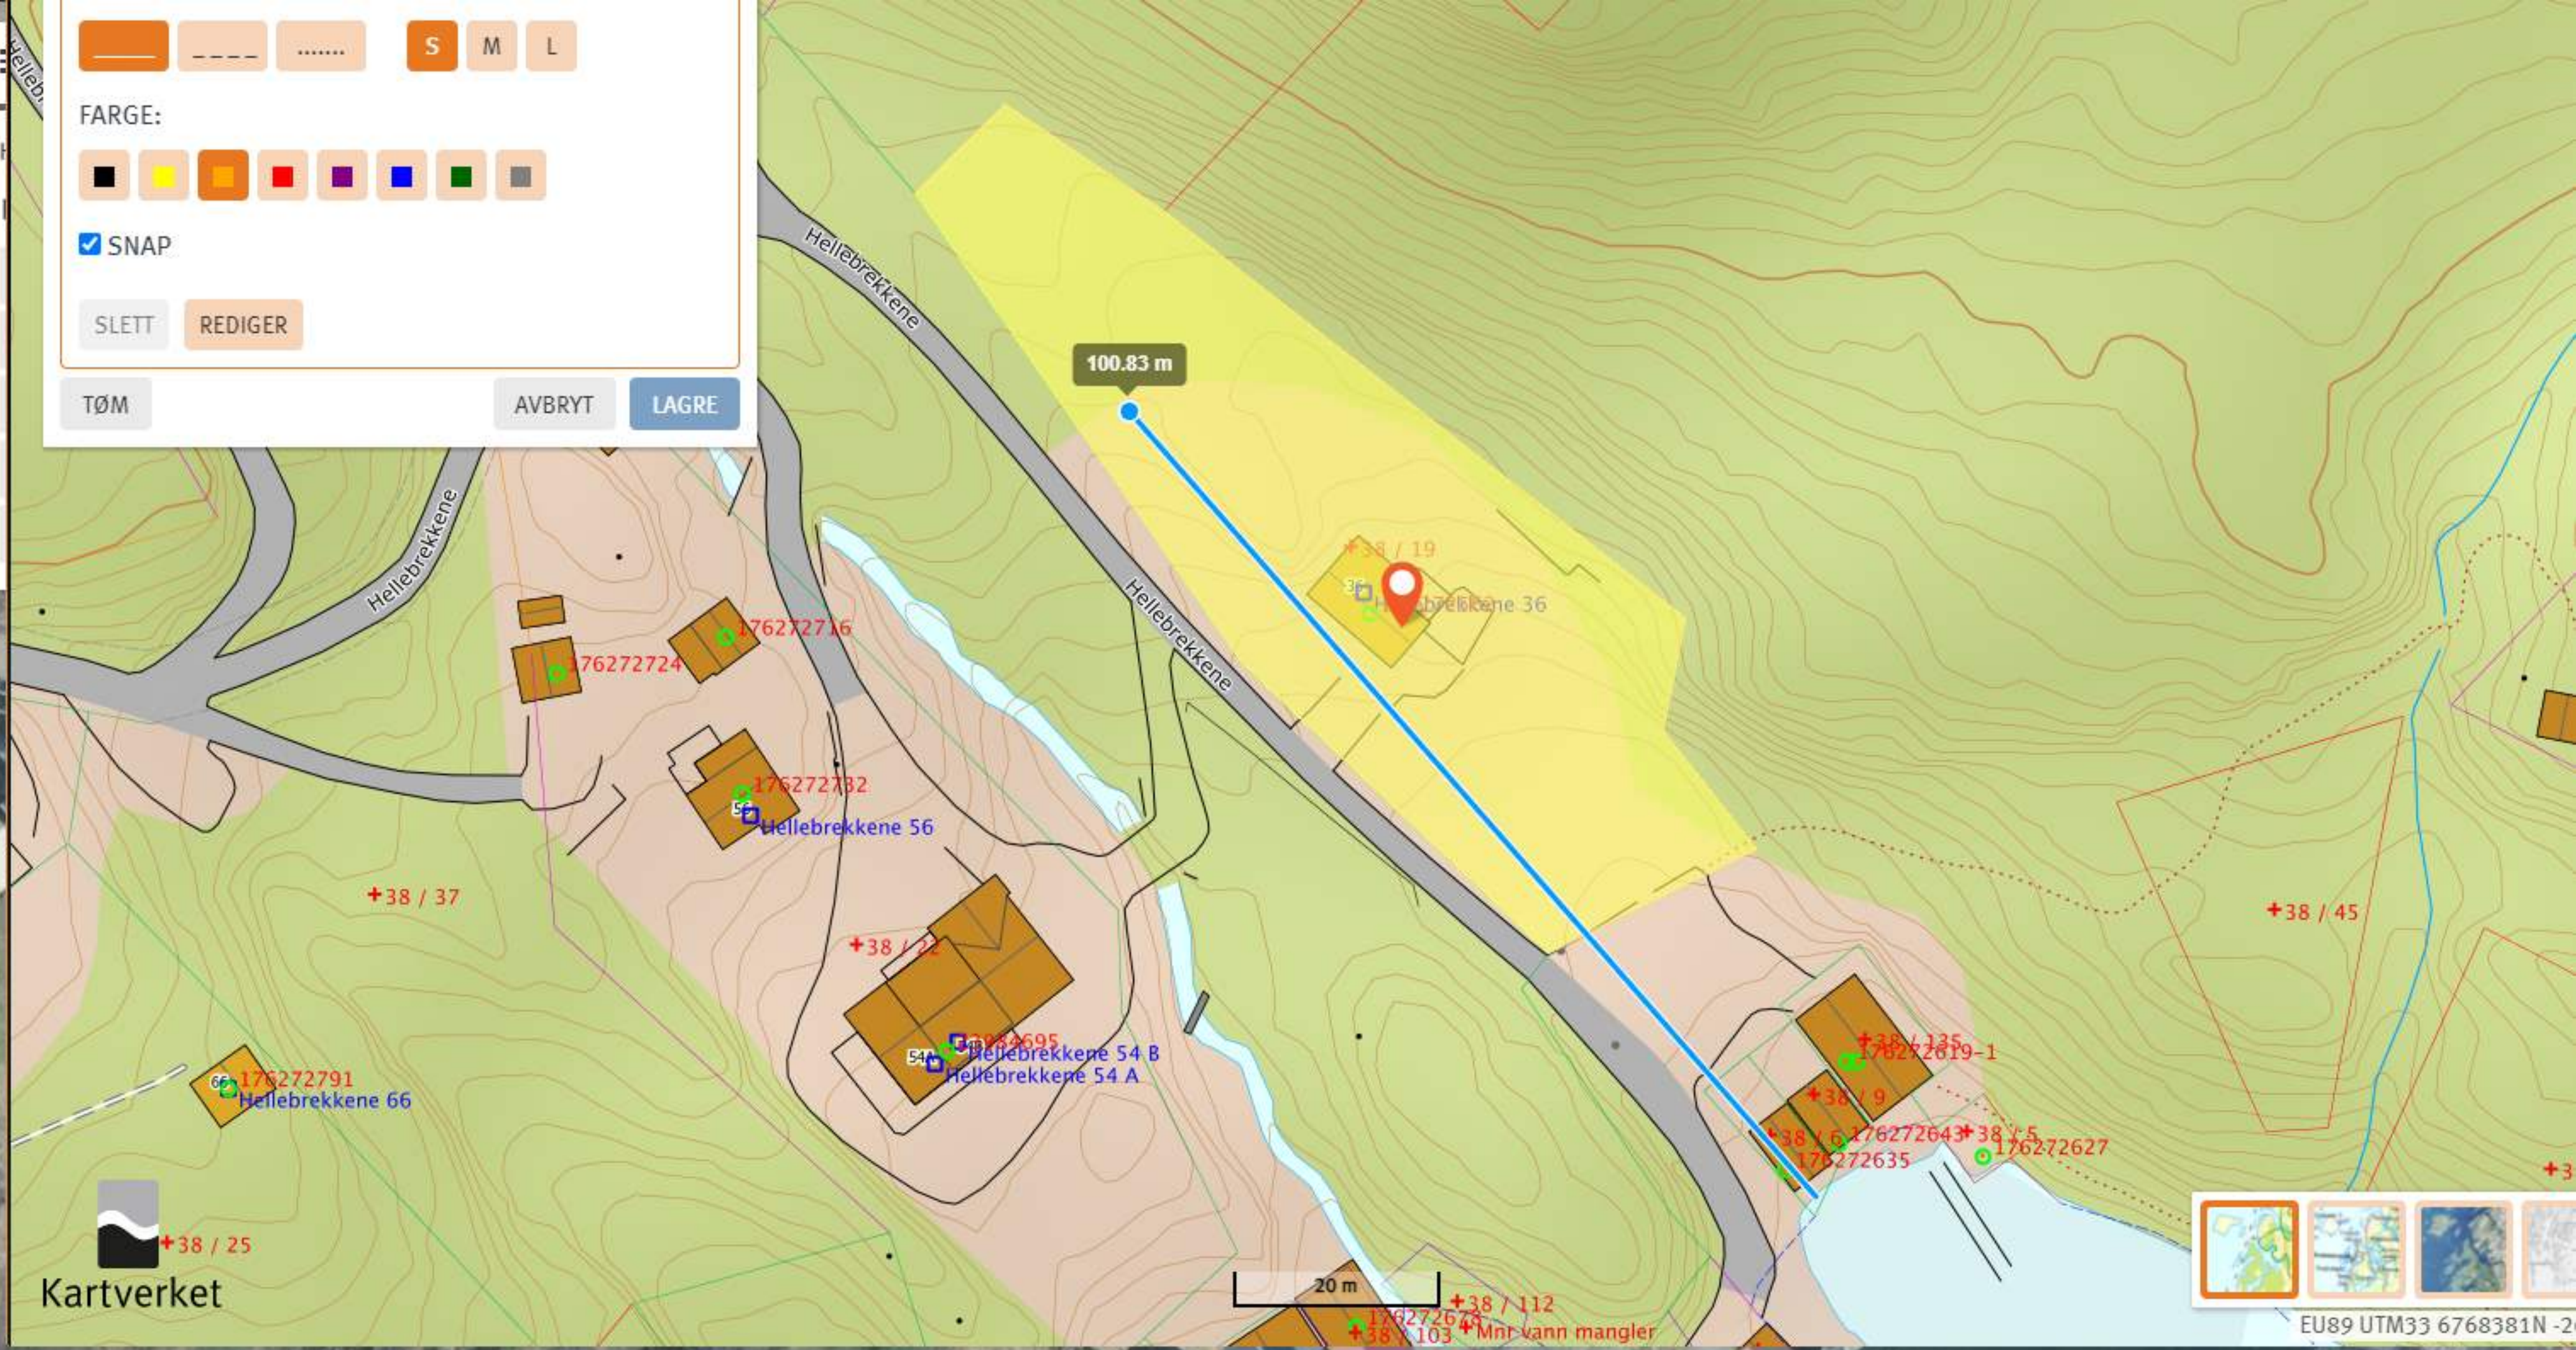

EU89 UTM33 6768381N -2

