


Senterposisjon: -35260,97, 6769495,29
Koordinatsystem: EPSG:25833
Utskriftsdato: 27.10.2022

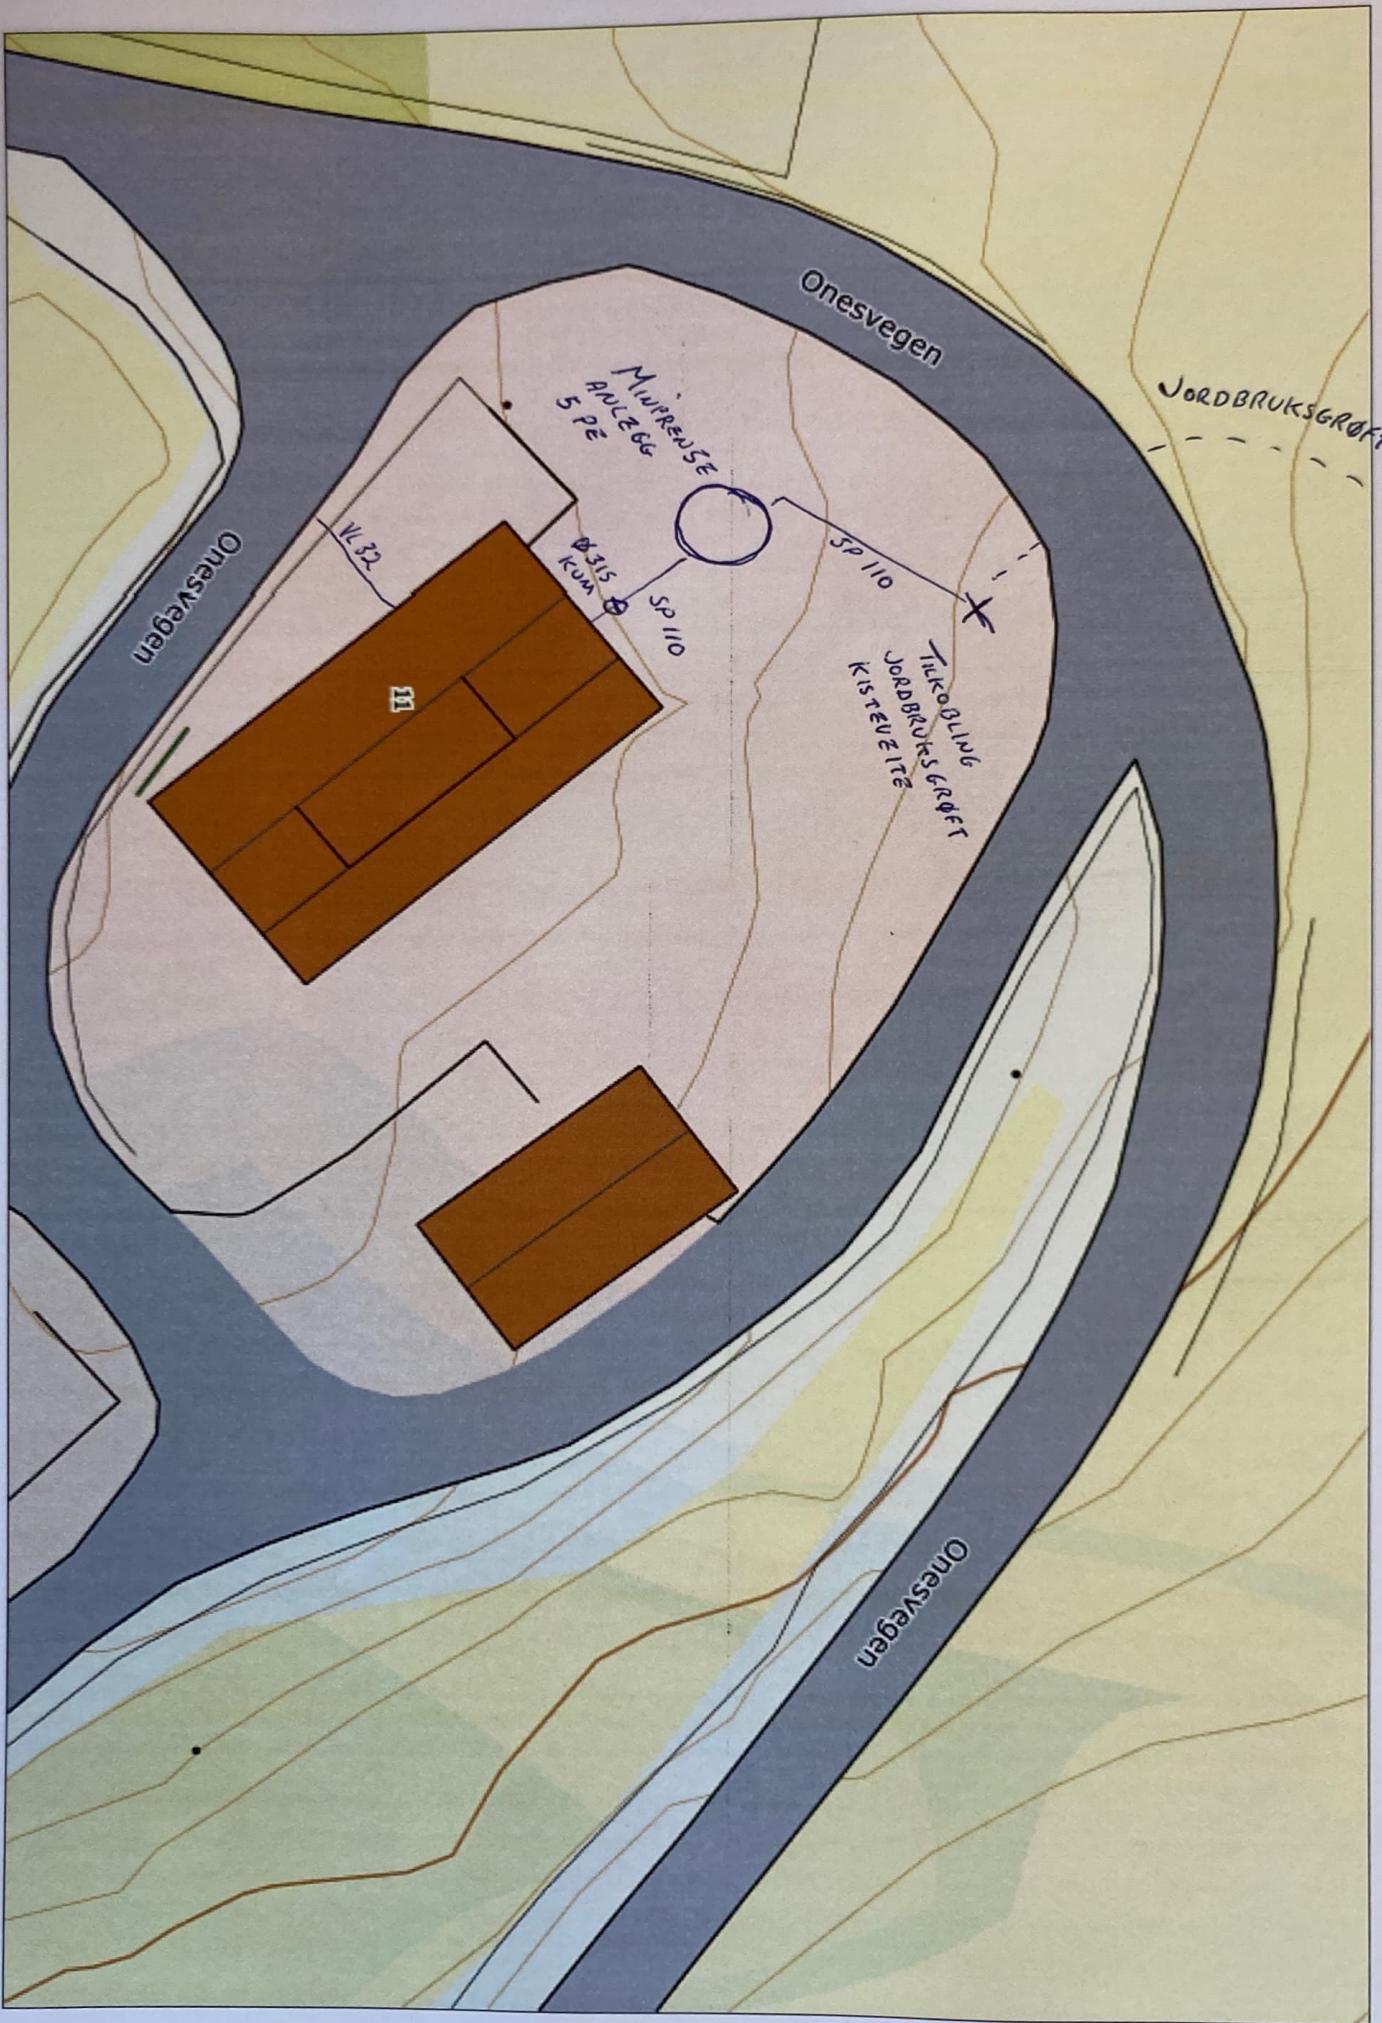

Senterposisjon: -35260,97, 6769495,29
Koordinatsystem: EPSG:25833
Utskriftsdato: 27.10.2022

