


F 12



N6723293, Ø301462 +  
15.11.2022

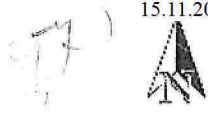

203/5

203/61

REKET SKUR

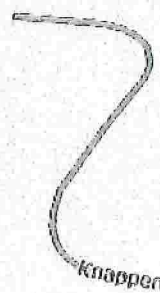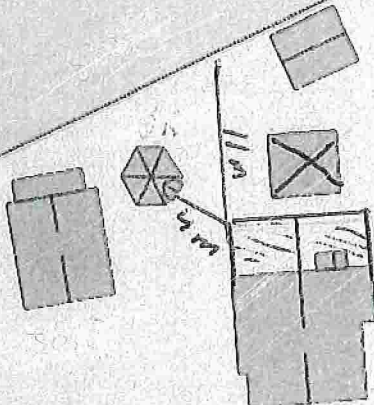

3.608 m<sup>2</sup>  
40


150

116

203/13

203/42

203/49

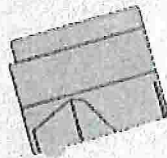

1.700 m<sup>2</sup>

1.300 m<sup>2</sup>

60

120 m<sup>2</sup>

20

1.625,25 m<sup>2</sup>

170 m<sup>2</sup>

Knappen

203/50

Situasjonskart - Knappen 43

203, 49, 13  
B. nr.

Nhdigi.no

Dato: 04-04-2022

Målestokk: 1:500

15m