




Plassering situasjonsplan

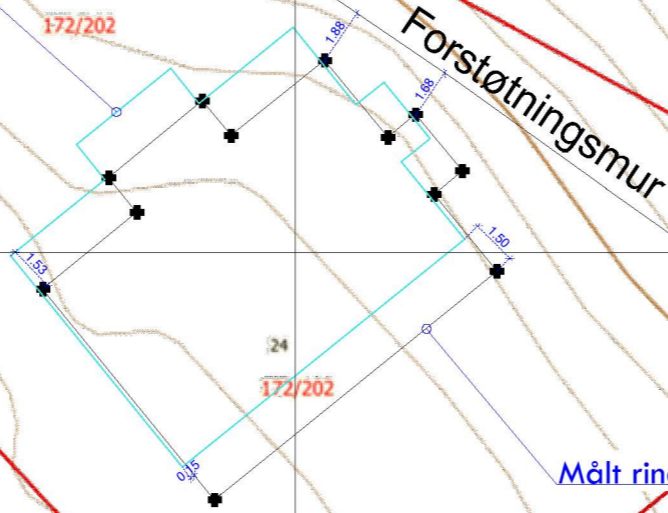

Seim Bygg AS Nesbrekka 28 5912 Seim				Målestokk 1:250	 Epost: post@sh-oppmaling.no Tlf 472 99 092
Dato 15.10.2021	Konstr./egnet sh	Godkjent			
Kartutsnitt innmålt ringmur Gnr 172. bnr 202 Tiltakshavar: T Kolås				Erstatning for:	Erstatet av: 901
Henvisning:				Beregning:	Alver kommune

6726075

6726050

6726025

295675

295700

295725