

INNMÅLINGSTJENESTER AS



Organisasjonsnr. 979 927 703
Bankgiro:3624 07 79751

Vår ref:
Knut Henanger
Frekhaug Bolig as

Deres ref:

Dato:13.05.22.

Innmålingsdata for Gnr.202 Bnr.177,Helleåsen,Alver Kommune.

Målt topp grunnmur

HUSET

| <u>PUNKT</u> | <u>TEMA</u> | <u>X</u> | <u>Y</u> | <u>H</u> |
|--------------|-------------|-------------|------------|----------|
| 05 1 | 5000 | 6722785.537 | 300551.476 | 59.286 |
| 05 2 | 5000 | 6722781.113 | 300543.199 | 62.057 |
| 05 3 | 5000 | 6722771.302 | 300548.589 | 62.060 |
| 05 4 | 5000 | 6722775.239 | 300555.757 | 59.303 |
| 05 5 | 5000 | 6722781.796 | 300552.155 | 59.301 |
| 05 6 | 5000 | 6722782.394 | 300553.218 | 59.308 |

TOMTEN

| | | | | |
|-------|------|-------------|------------|--|
| 05 8 | 4011 | 6722757.020 | 300545.220 | |
| 05 9 | 4011 | 6722763.600 | 300528.220 | |
| 05 10 | 4011 | 6722780.560 | 300534.670 | |
| 05 11 | 4011 | 6722806.880 | 300562.560 | |
| 05 12 | 4011 | 6722778.210 | 300583.740 | |
| 05 13 | 4011 | 6722758.320 | 300547.150 | |

Med vennlig hilsen
Innmålingstjenester as

Kjersti K. Madsen



Kontoradresse:
Telefon
Kjersti K. Madsen
Johnny Sandvik

Helgeplassen 144
55 59 02 77 (76)
Mob.tlf.90 78 72 08
Mob.tlf.40 40 23 23


5148 Fyllingsdalen
E.Post: innmal@innmal.no

X 6722850

Y 300550

Skisse for Gnr.202 Bnr.177 Helleåsen, Alver Kommune.

X 6722800

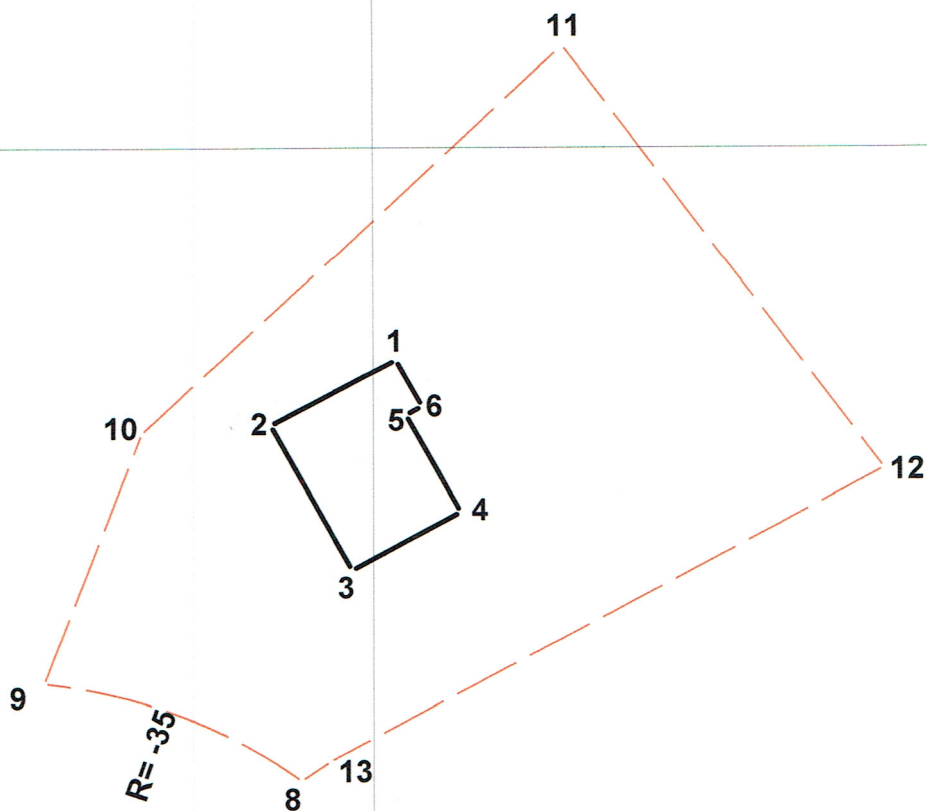

X 6722750



Skisse for Gnr.202 Bnr.177
Helleåsen, Alver Kommune.
Frekhaug Bolig as
Dato: 13/05/22

Målestokk 1:500

Innmålingstjenester as

Kjerkv. Madsen