

Ørjan Tveit

357/8


Situasjonskart -

Nhdigi.no

Målestokk: 1:1 000

30m

Dato: 31-10-2022

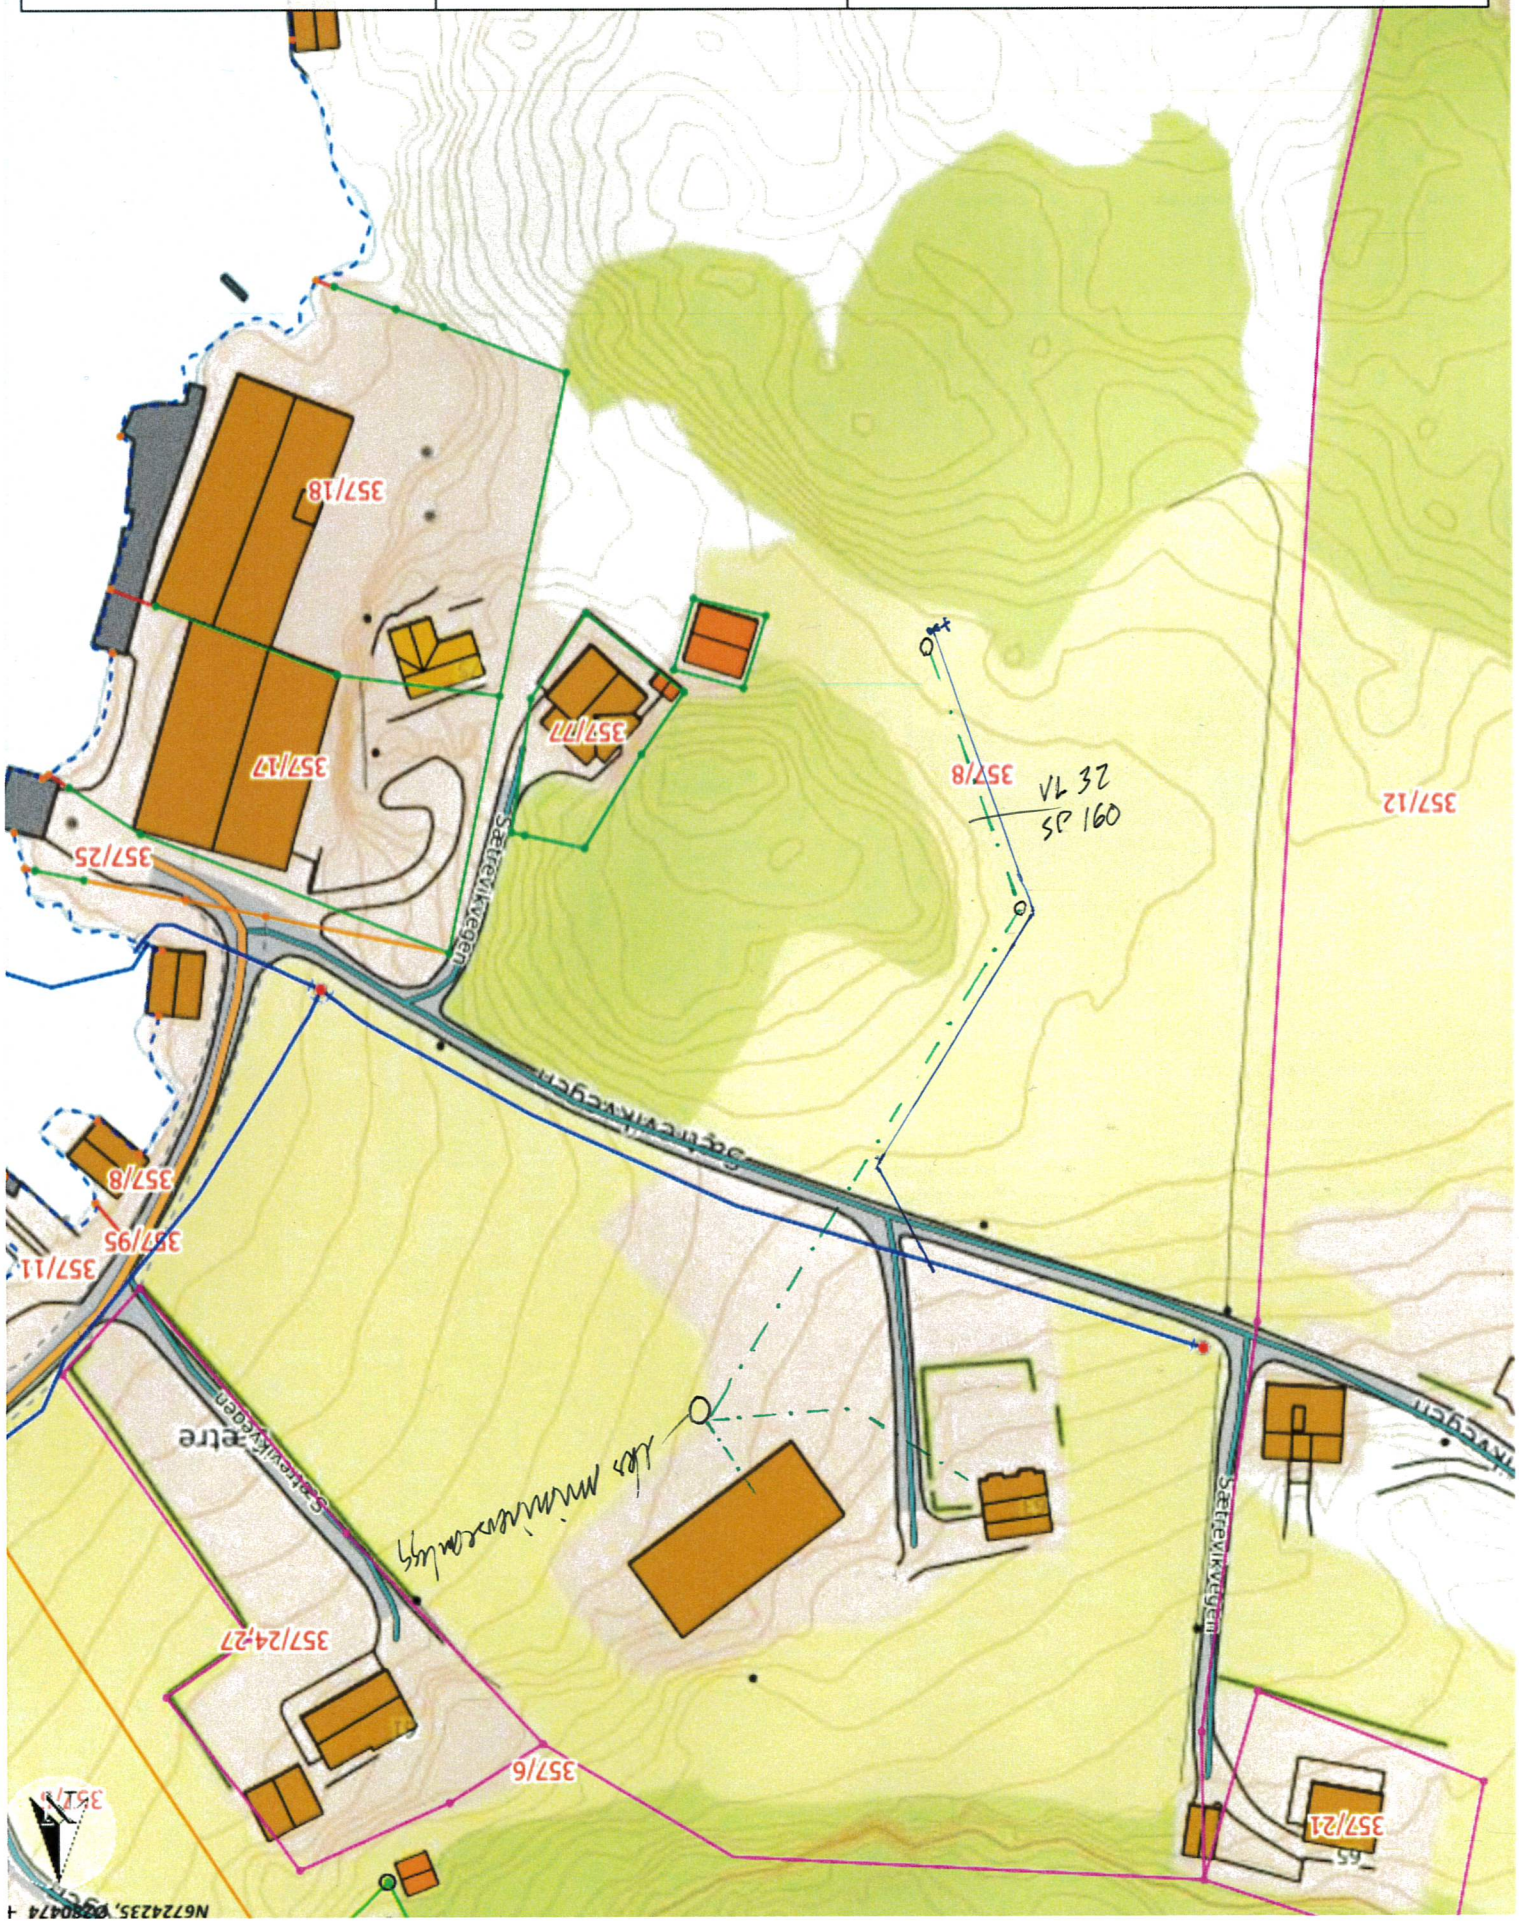

N6724235, Ø280474

N6723948, Ø280274