

# Kartvedlegg til protokoll for oppmålingsforretning

Alver Kommune



Eigedom  
131/44

Saks nr  
20227959


Oppdragnr

Rekvirent  
Fosse Astrid Skare

Forretningsdato  
29/11/2022

Landmålar  
Kjell Rune Standal

Målestokk 1:500

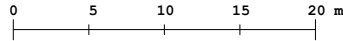

Beskriving/avtalar:

X 6723550

Y 292350

Y 292400

131/4

131/4

131/44

131/87

131/44

X 6723500

14

15

12

11

10

9

21

20

7

6

131/83

131/80

131/81

131/86



30.11.2022  
Målestokk 1:500