


23.12.2022

ISDALSTØBAKKEN 10
137/731
HOGNE REIKERÅS
140756 46764

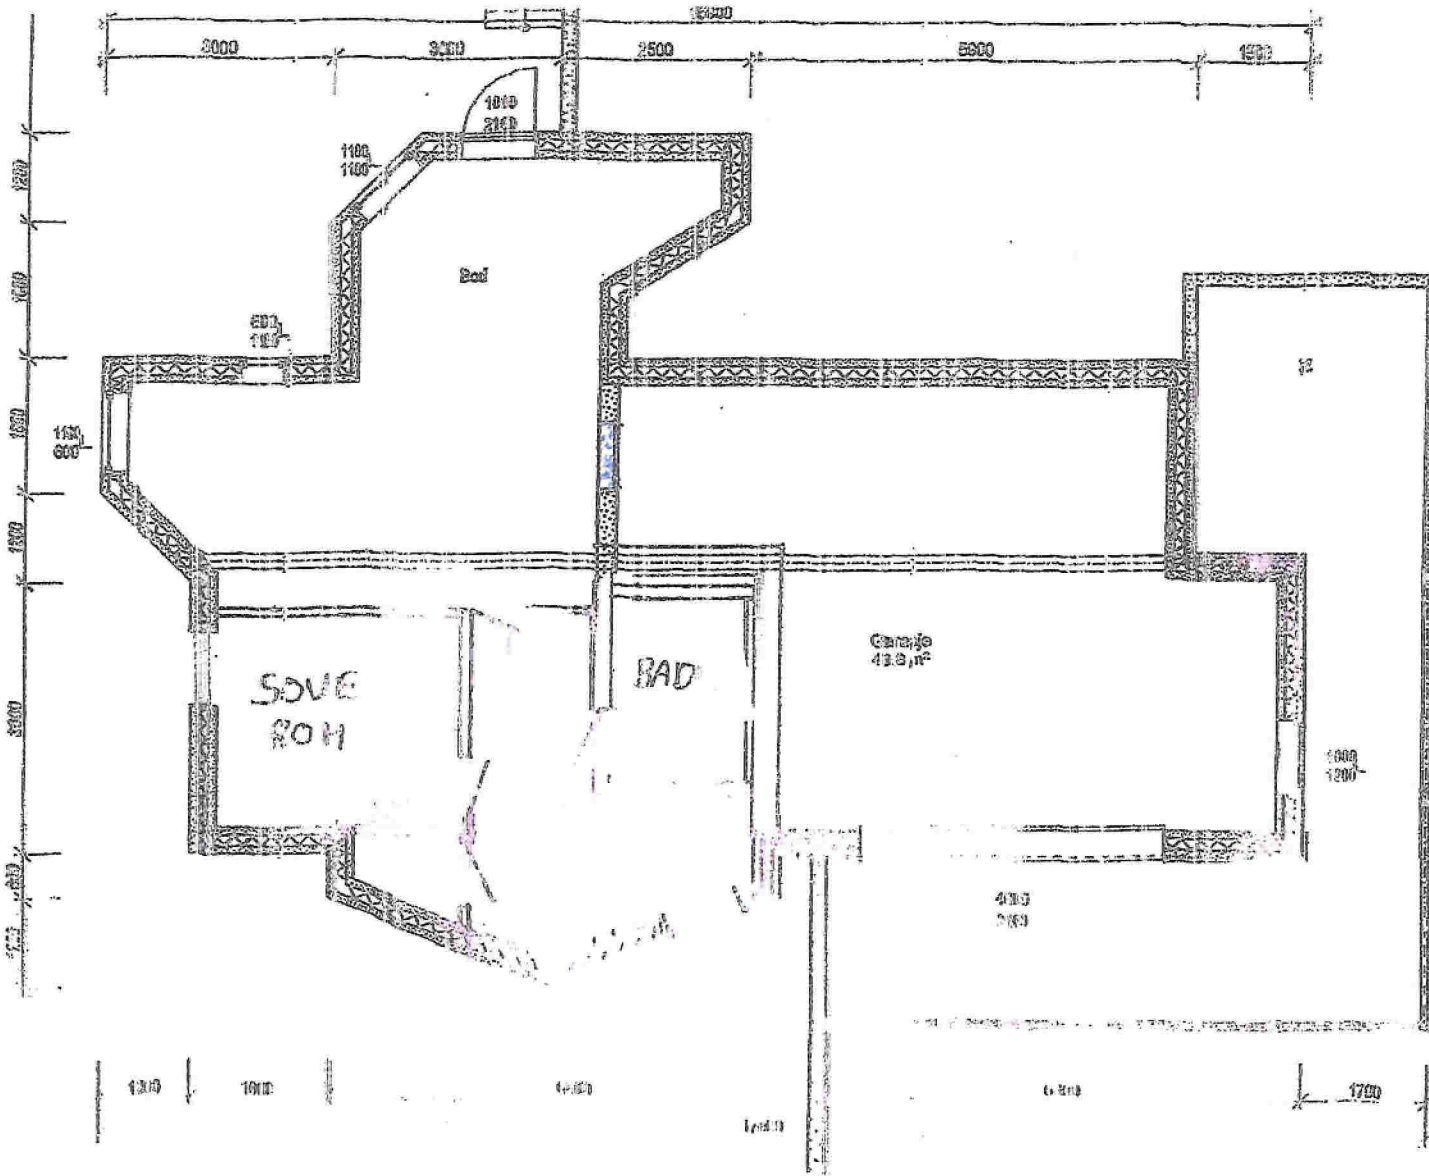

EKSISTERENDE