


D1

309/10

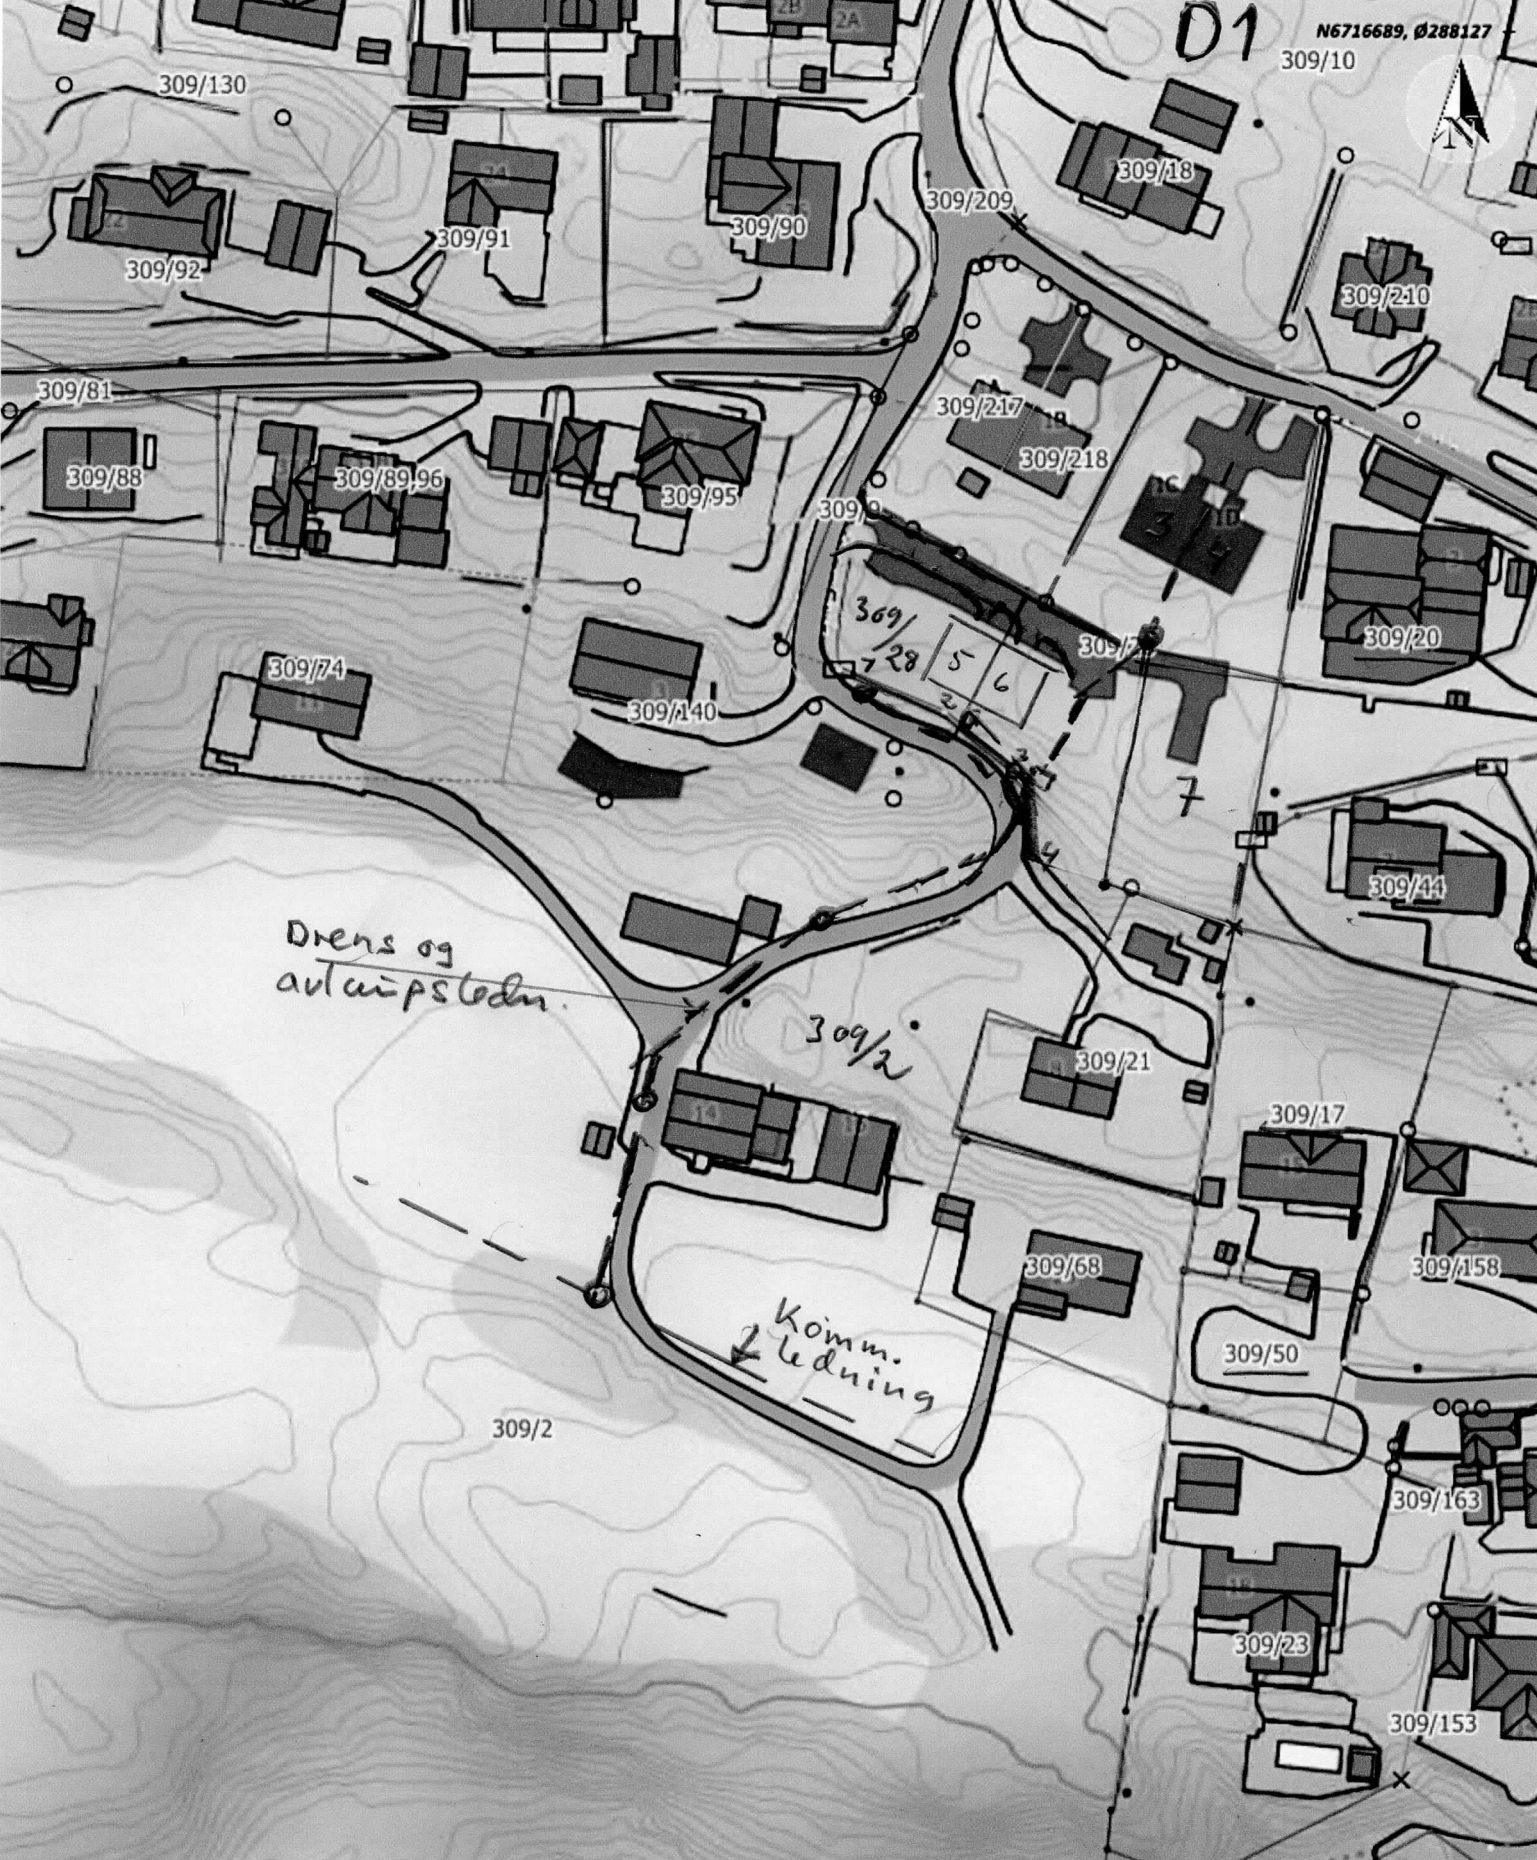

Situasjonskart -
gnr. 309 bnr. 28
nas 5 og 6
avløps- og dreneledn.

Nhdigi.no

Dato: 15-11-2022

Feltet 15.11.22

Målestokk: 1:1 000

