


Y 294850

Y 294900

Y 294950

13

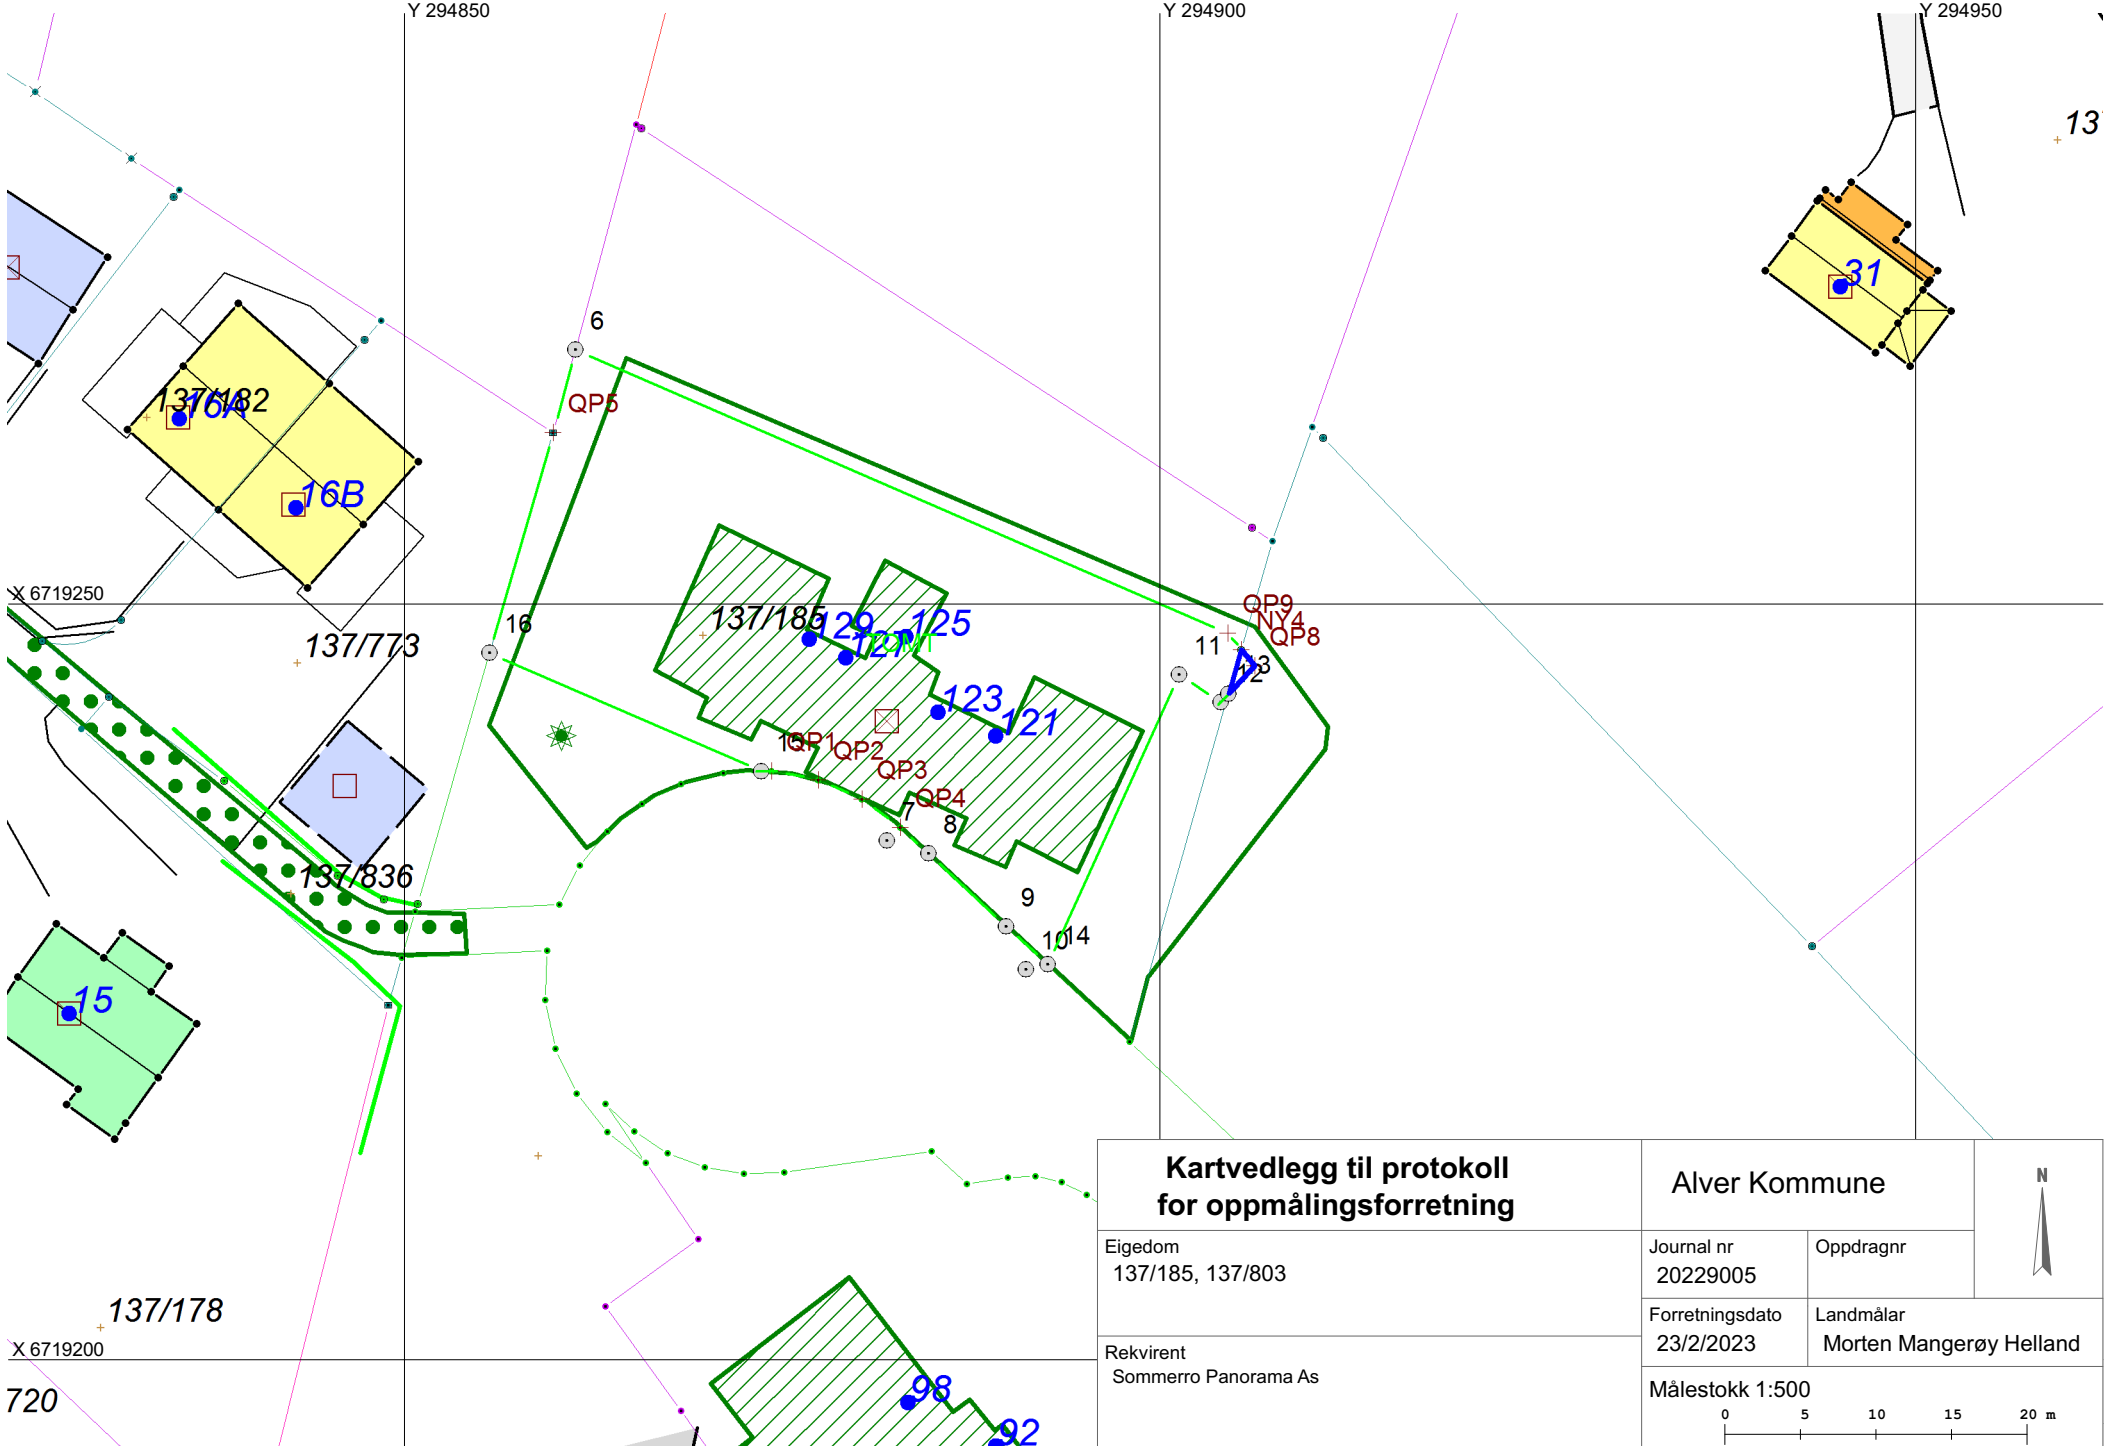

X 6719250

137/773

137/836

137/185 20 125

123 121

11

9

1014


137/178

X 6719200

720

98

92

Kartvedlegg til protokoll for oppmålingsforretning		Alver Kommune		
		Journal nr 20229005	Oppdragnr	
Eigedom 137/185, 137/803 Rekvirent Sommerro Panorama As		Forretningsdato 23/2/2023	Landmålar Morten Mangerøy Helland	
		Målestokk 1:500 