



GODTEKE  
13 APR. 1972  
Lindås Bygningsskild


LINDÅS KOMMUNE  
KOMMUNE-  
INGENIØRKONTOR  
00040 C. 1. 72  
ARKIV NR. 88

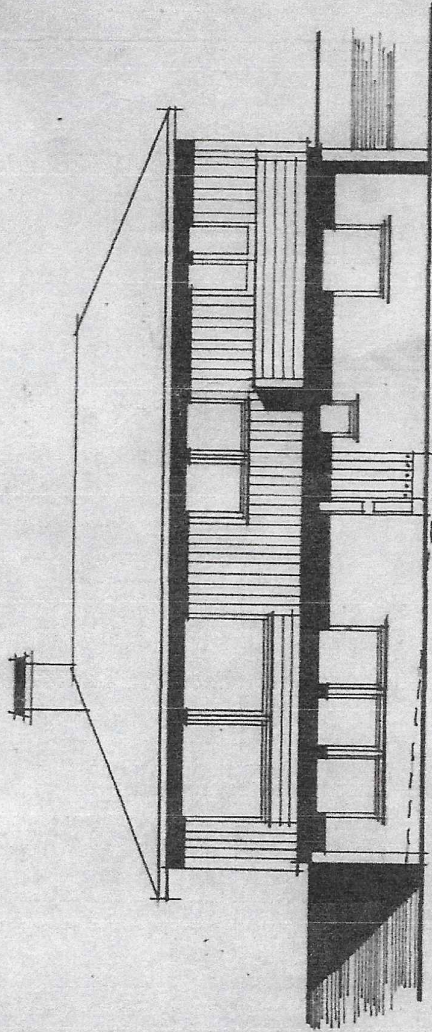


SYD-ØST

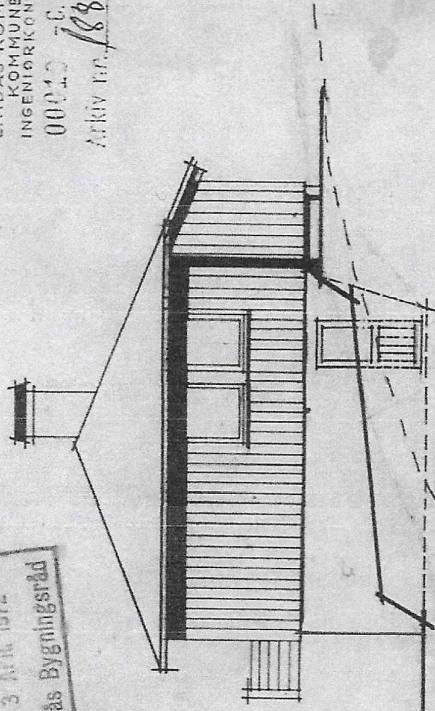

NORD-ØST

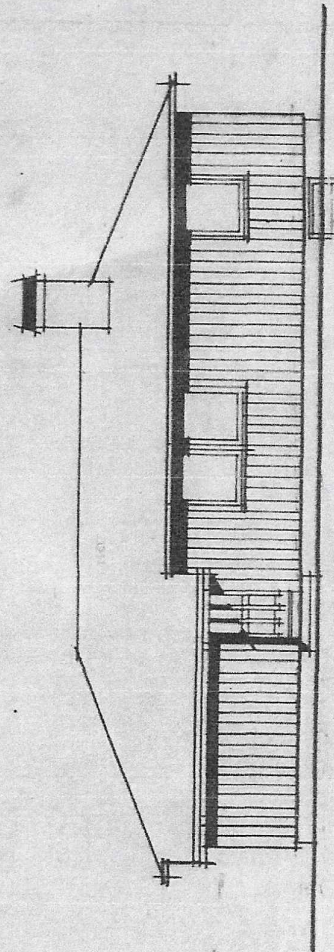

NORD-VEST

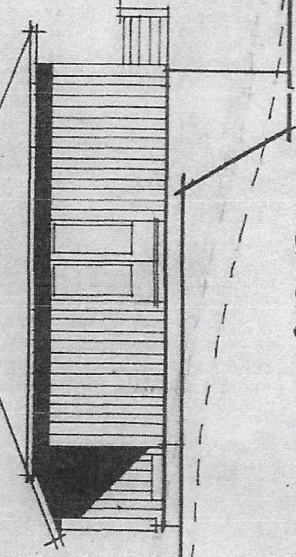

SYD-VEST

Tøikning n.s

Fasader

• Som bygd i 1972

TYPE 111  
FASAD  
M=1  
NACIV