





E.1

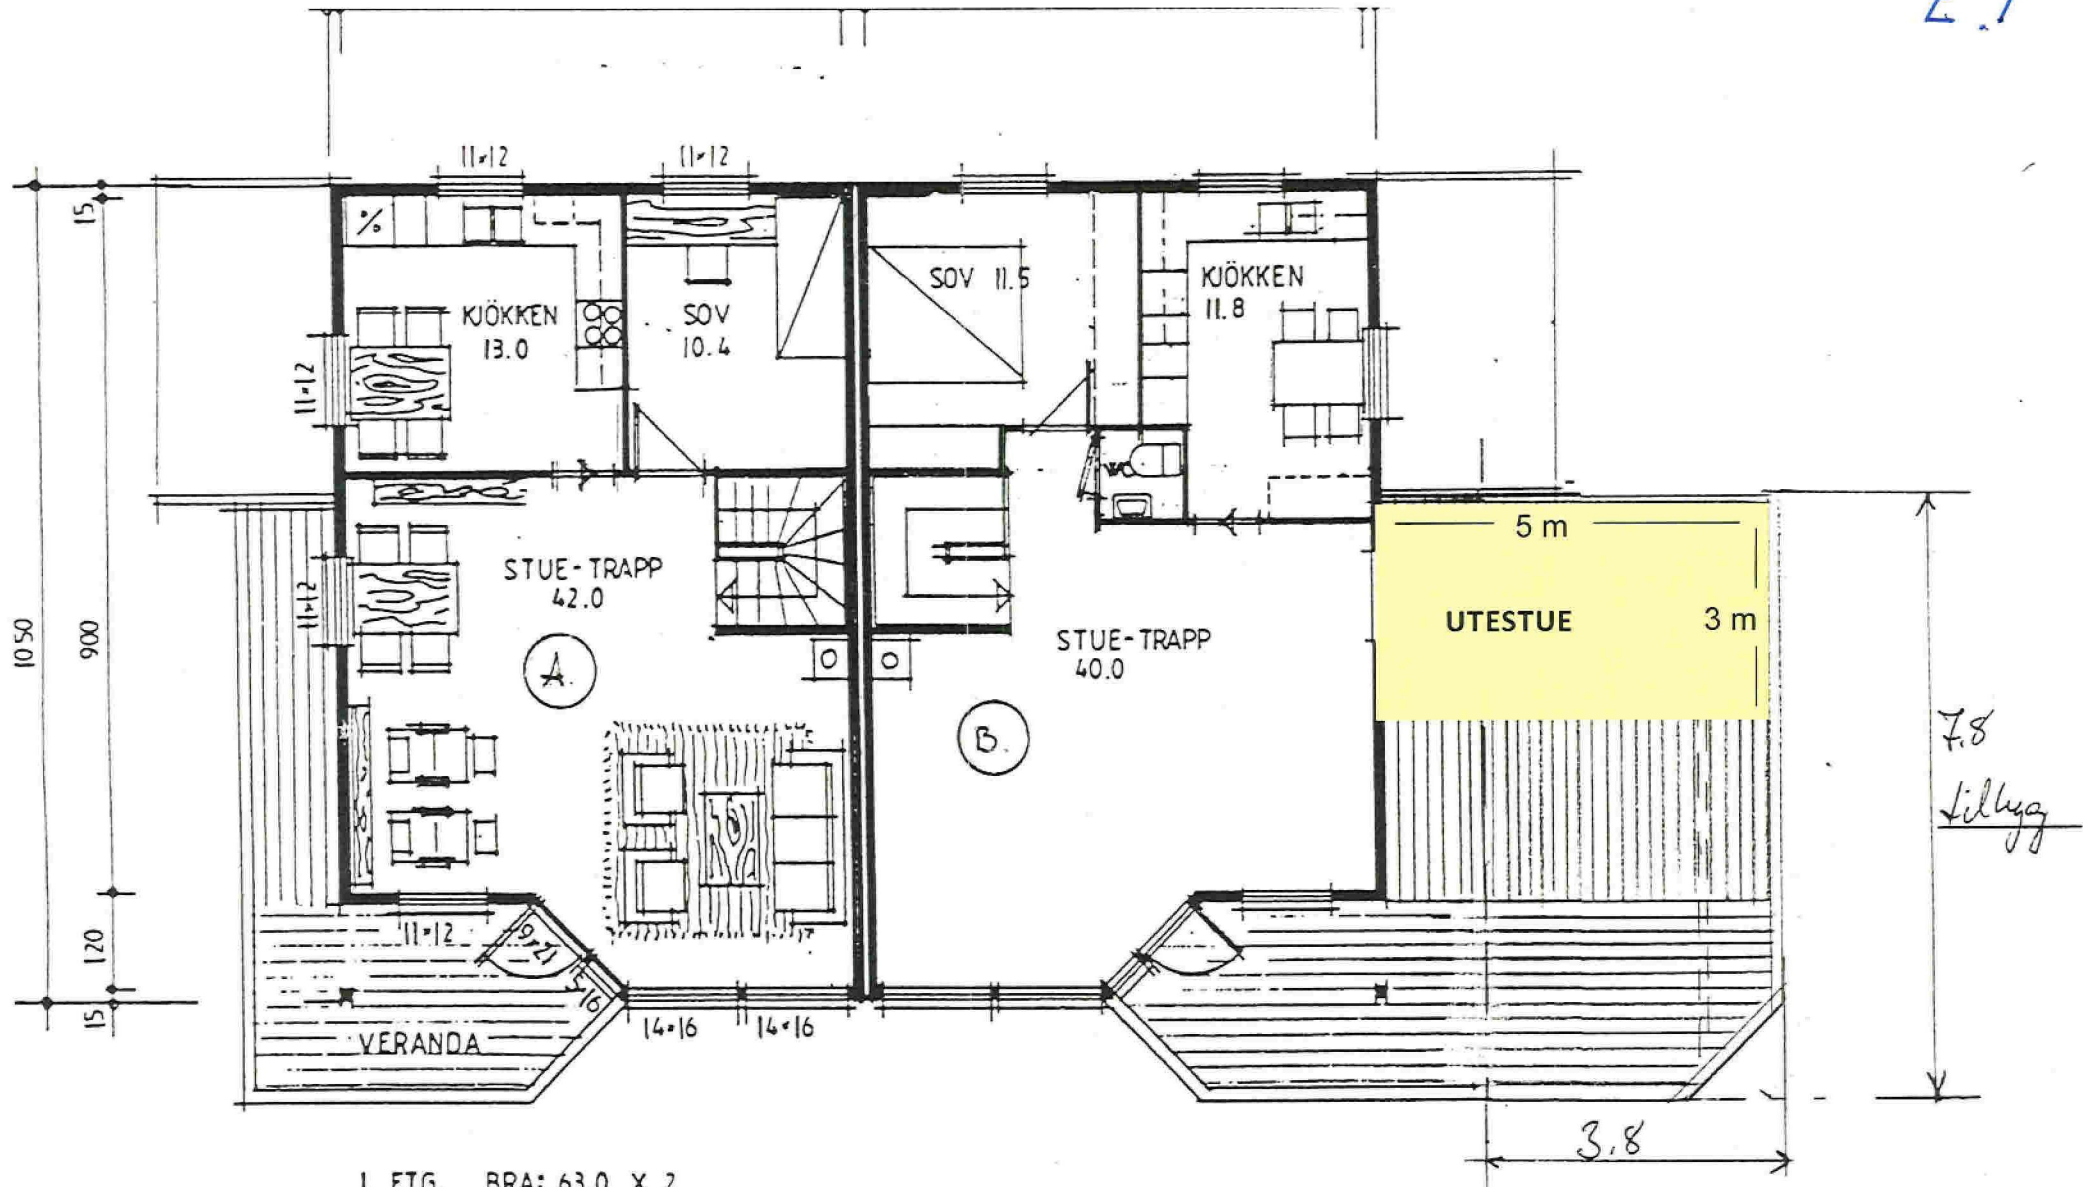

I. ETG. BRA: 63.0 X 2

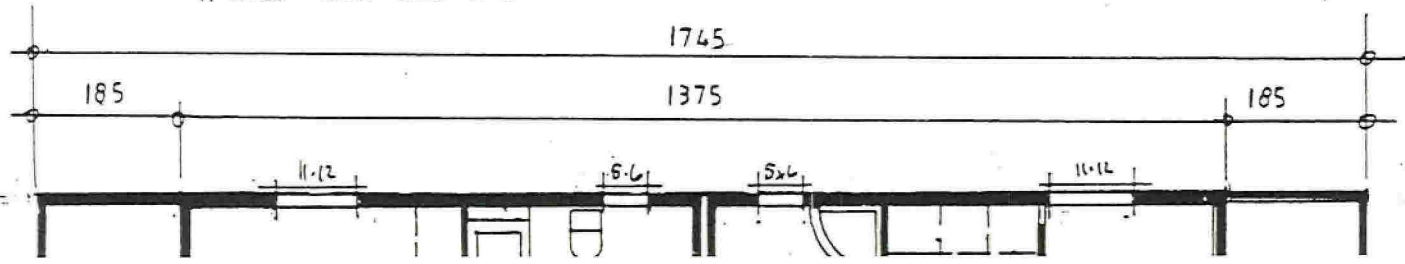

137/542  
08.05.2018  
SNO

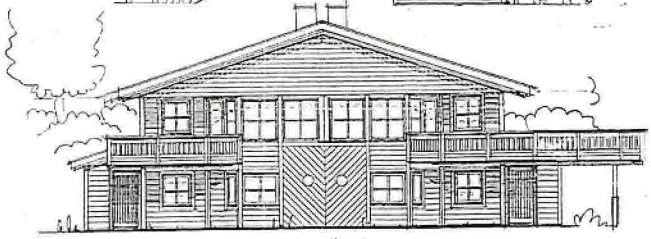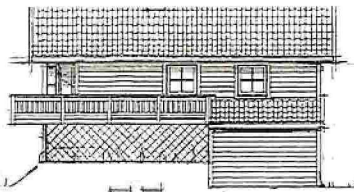


