




Retting av gresse
Grensejusteres

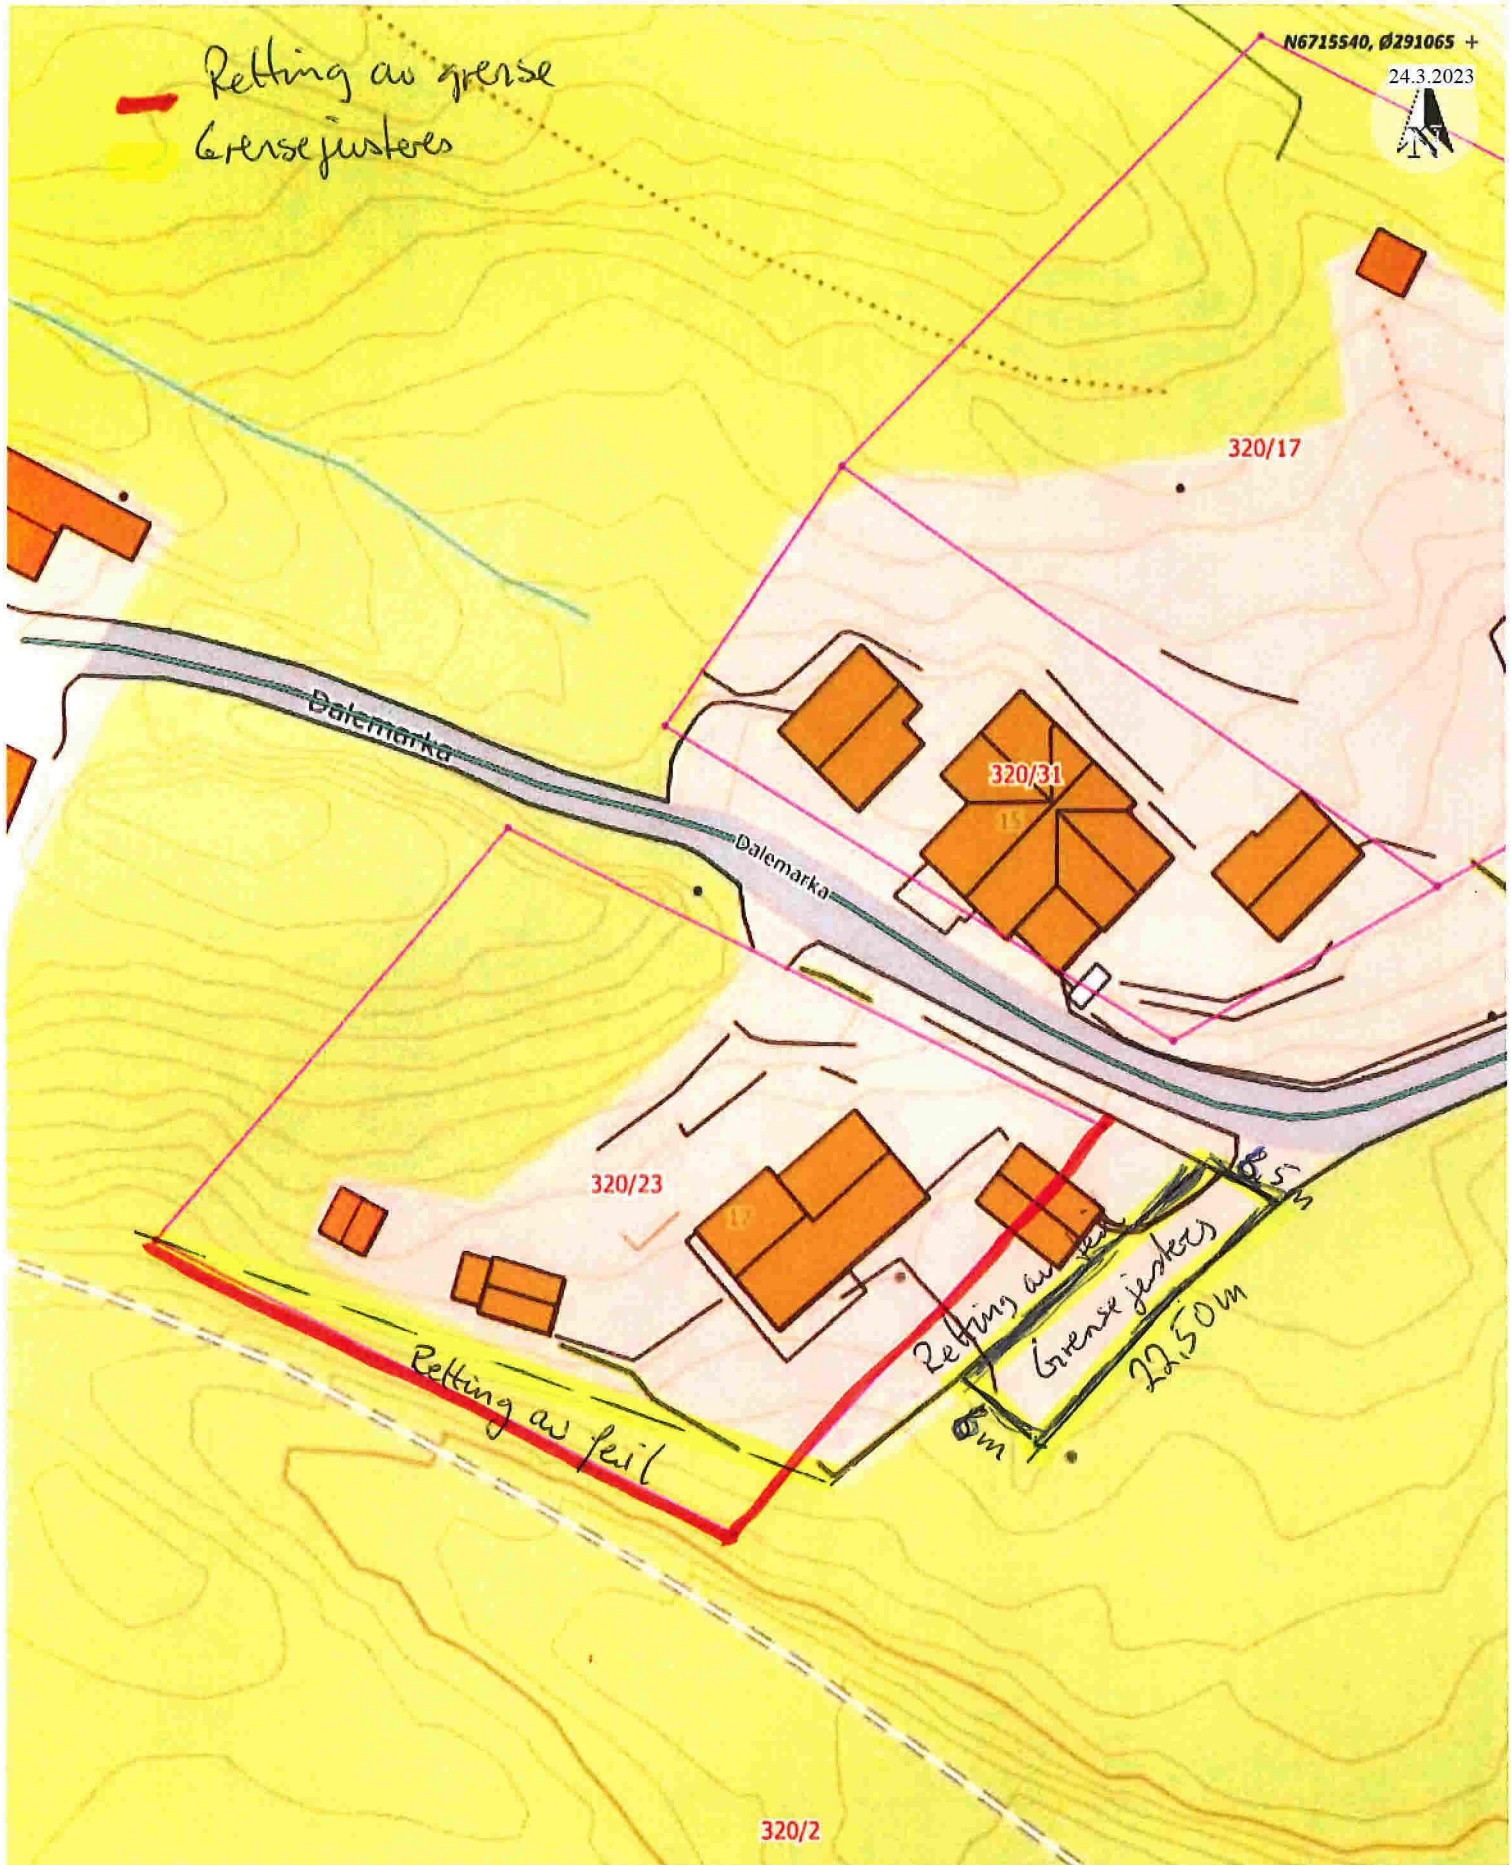

<p>Situasjonskart -</p>		<p>Dato: 06-02-2023</p>
		<p>Målestokk: 1:500</p> <p>◄—————► 15m</p>



Vedlegg:

Grunnboksutskrift_4631_320_2_0_0.pdf	11,5 KB
Eiendommen 320-2 Alver.JPG	98,8 KB
Kart over eiendommen Dalamarka 17 - Alver.JPG	116 KB
Feil grenser i eiendomskartet _ Kartverket - Google Dokumenter.pdf	32,9 KB