


137/622

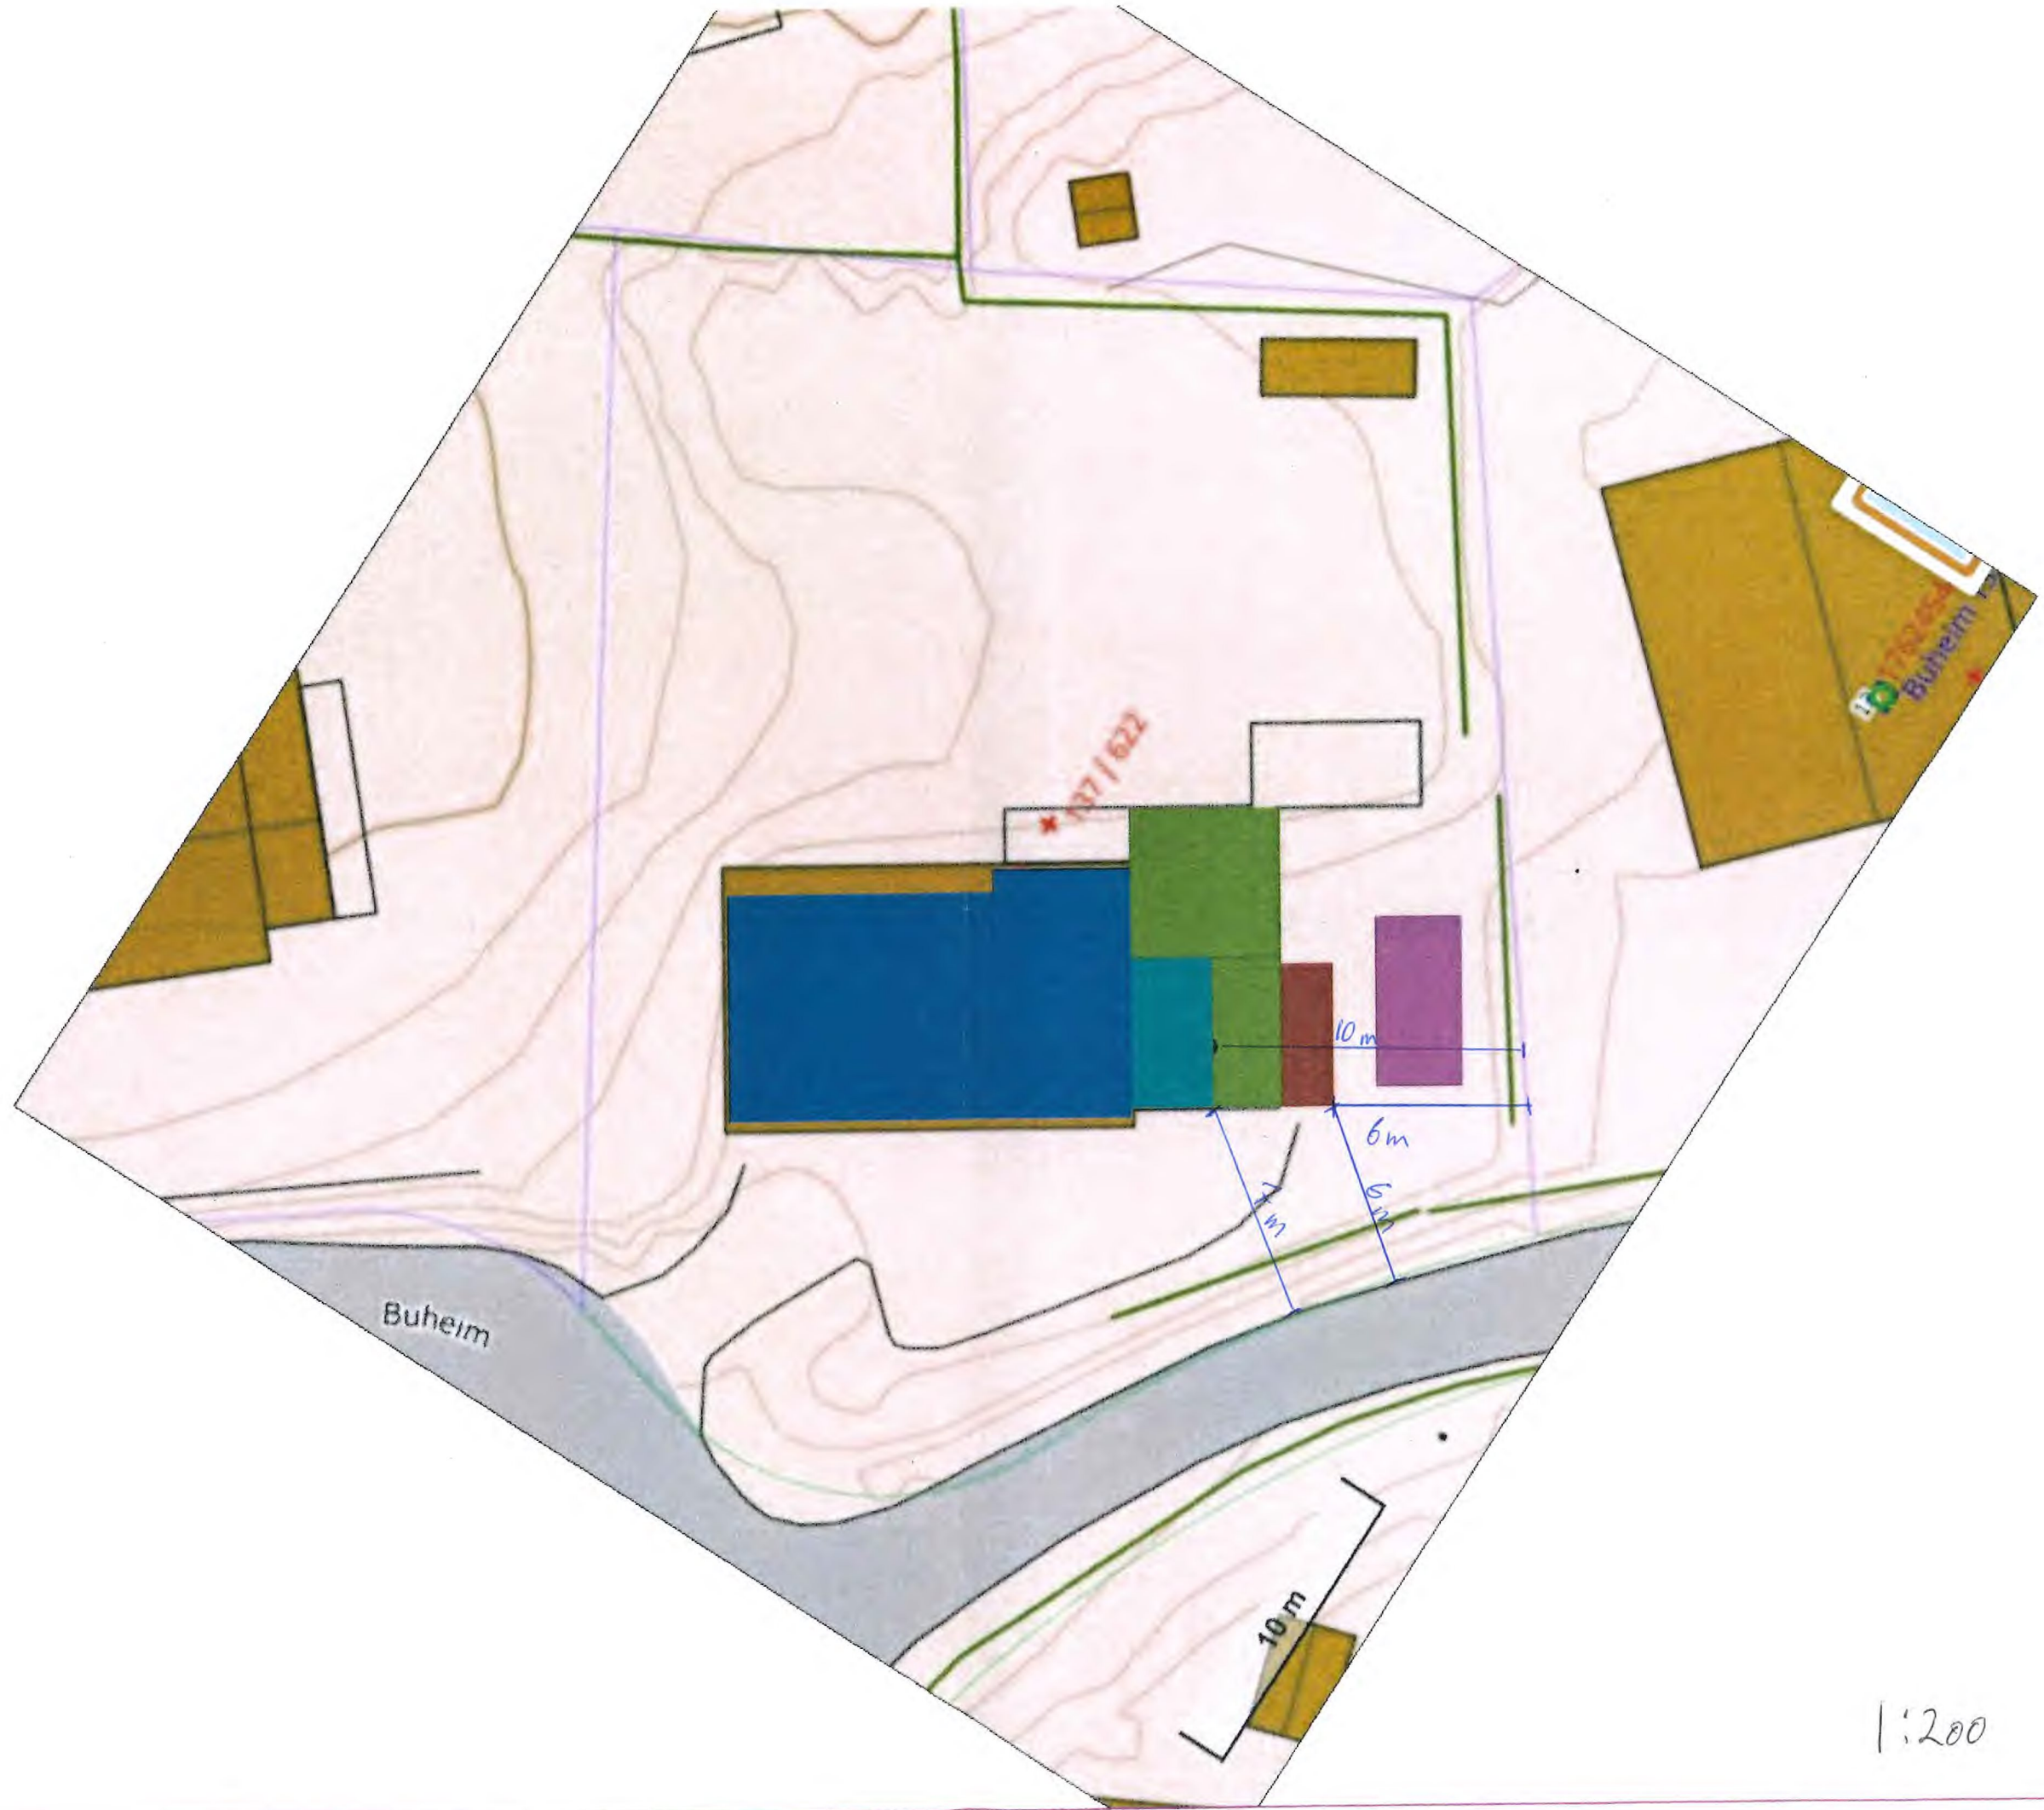


1:200

137/622



1:200

137/622

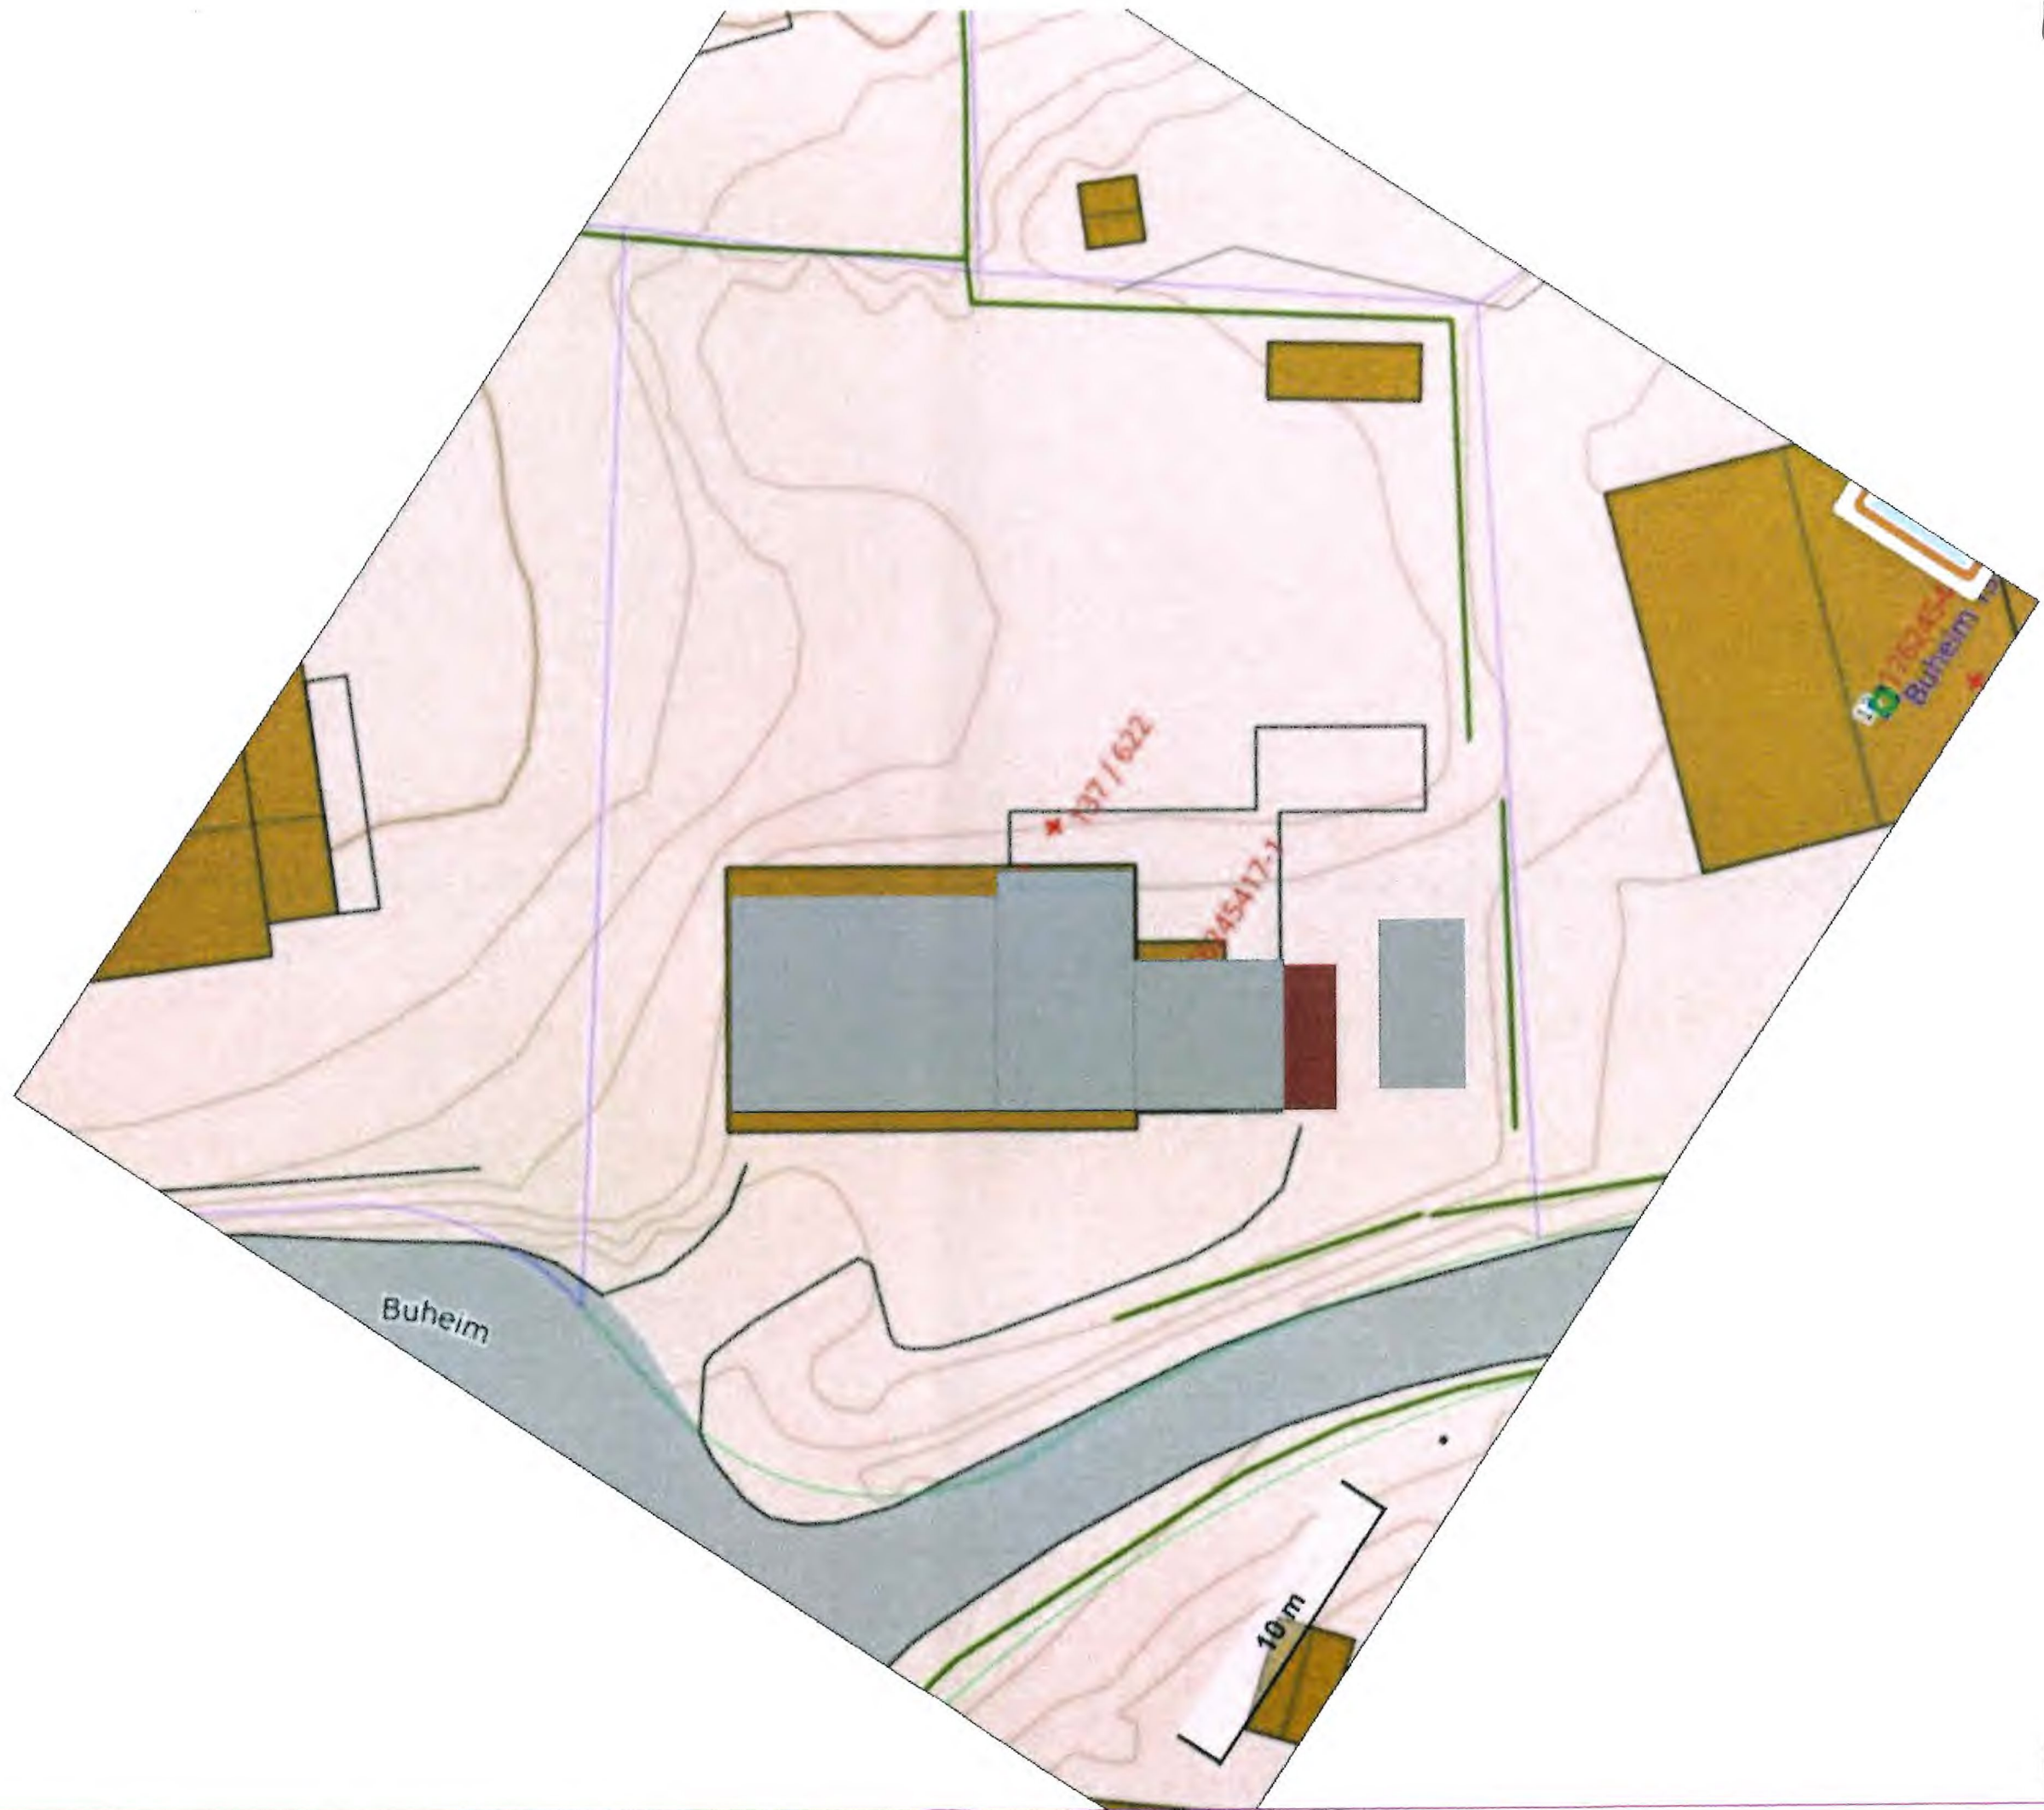

1:200

137/622



1:200