


31.07.2023  
Malesstokk 1:1000

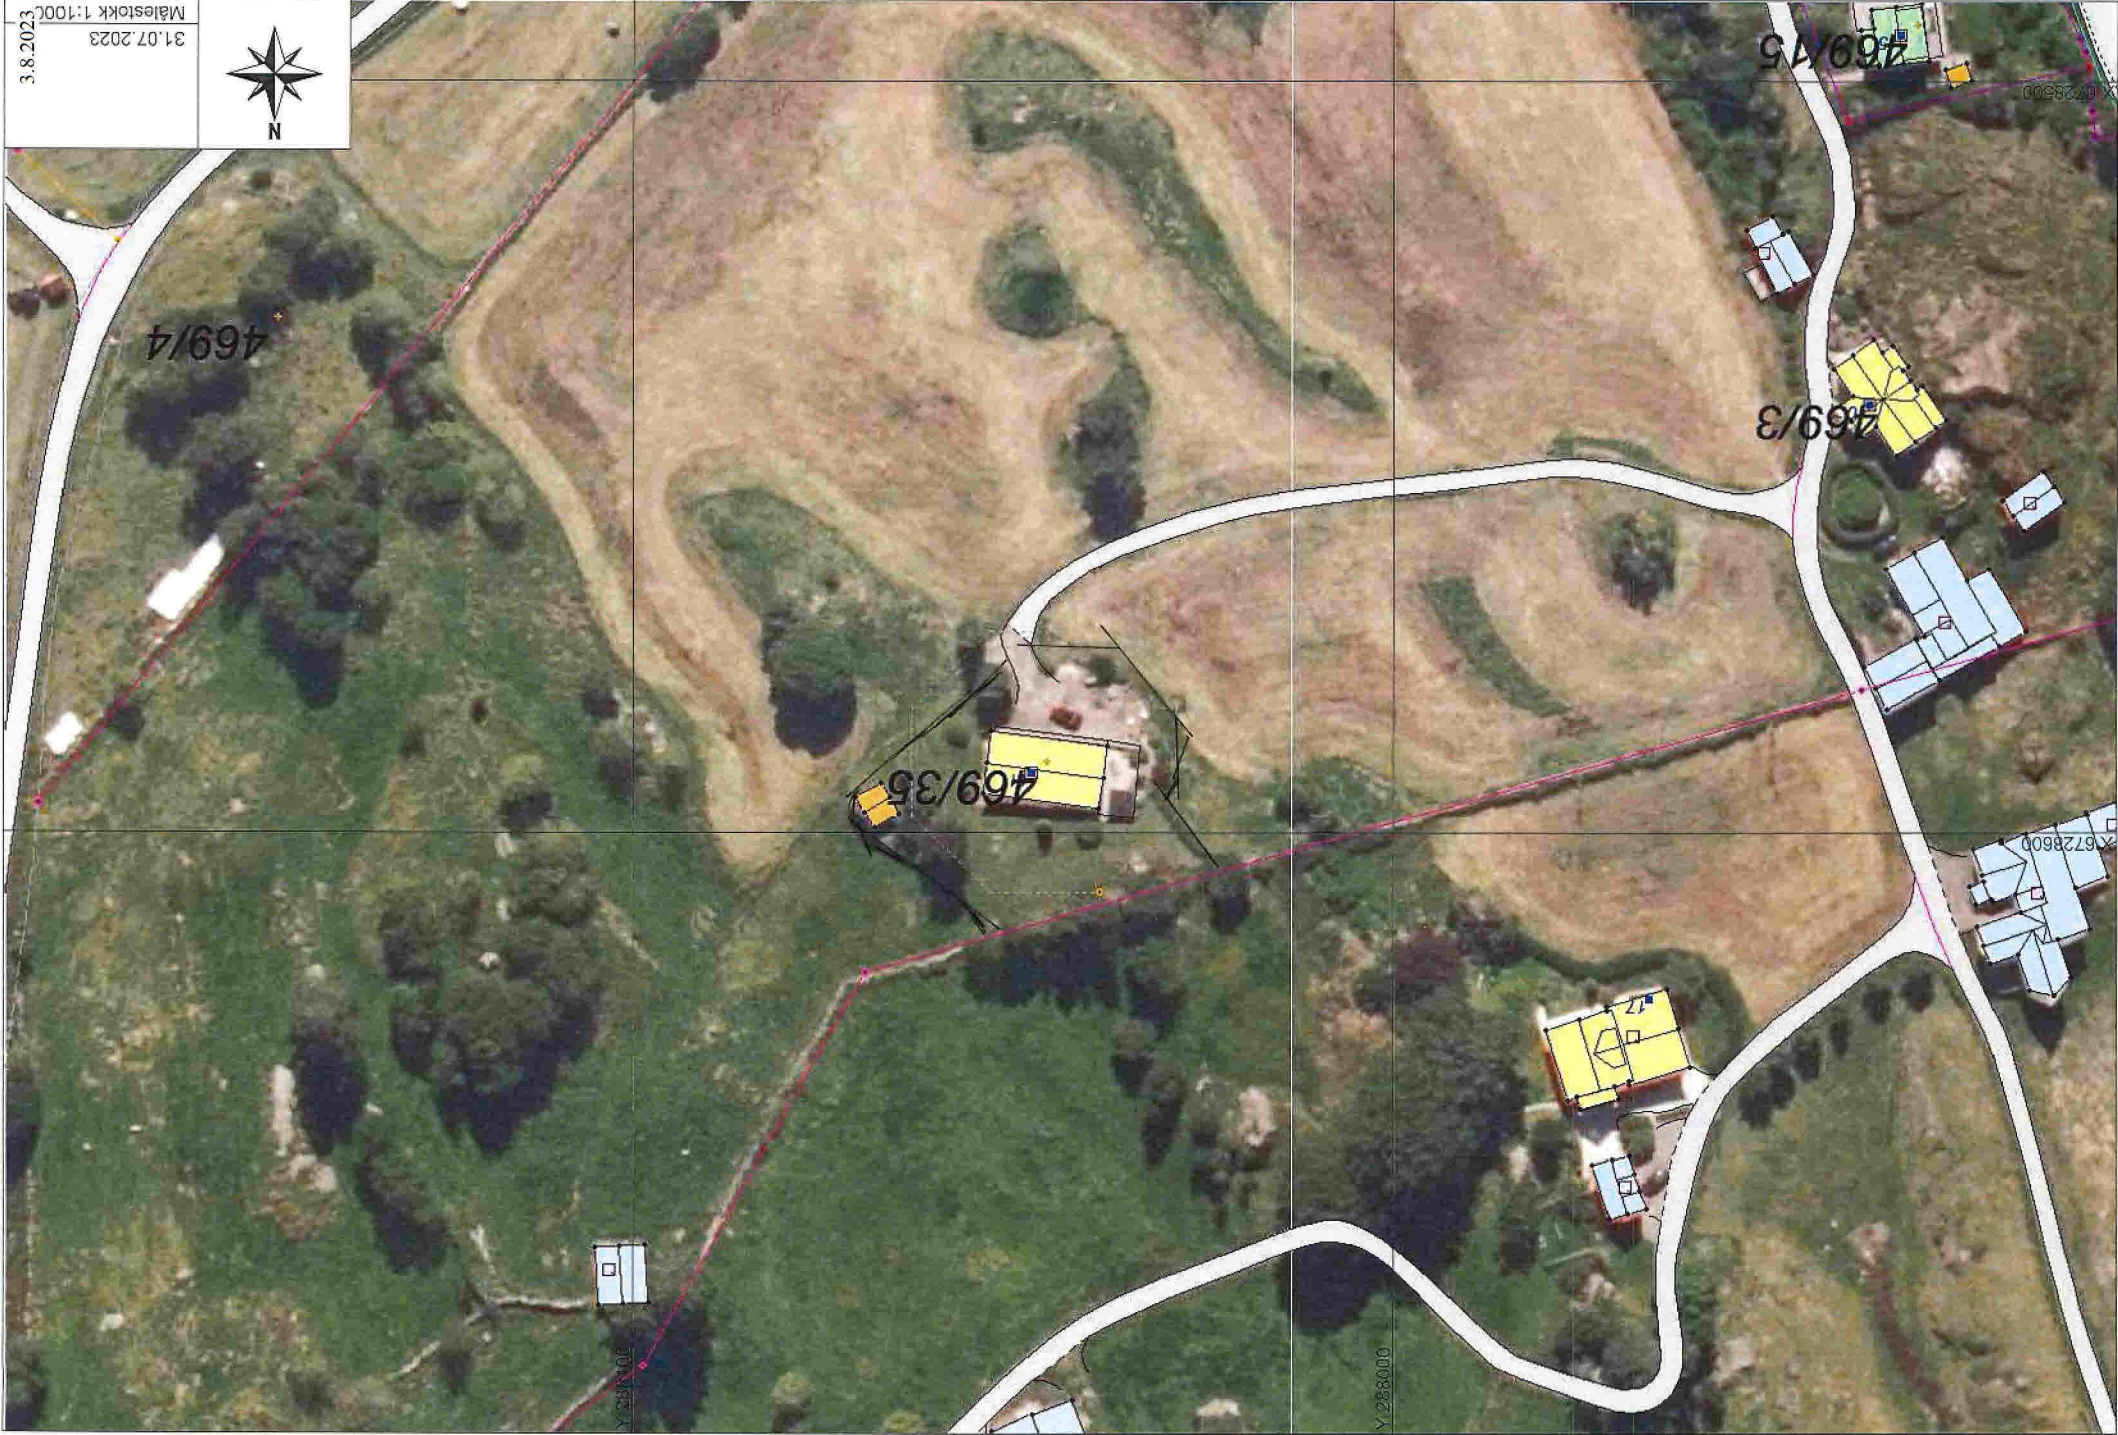

469/5

469/3

469/35

469/4

6728600

6728600

Y 2588000

Y 2588000