




Eksisterende snitt

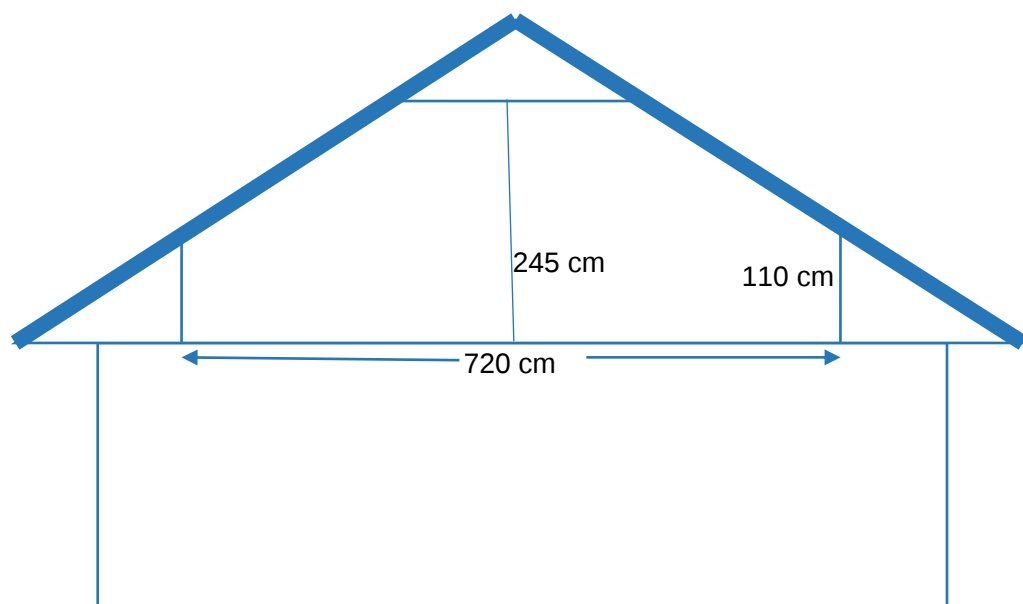

Nytt snitt

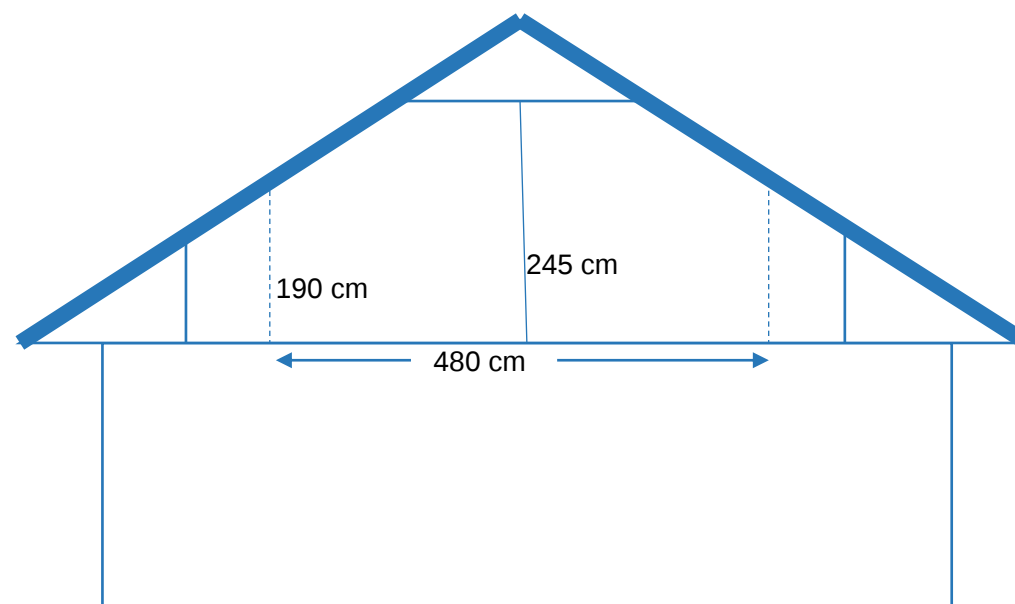

Eksisterende plantegning loft

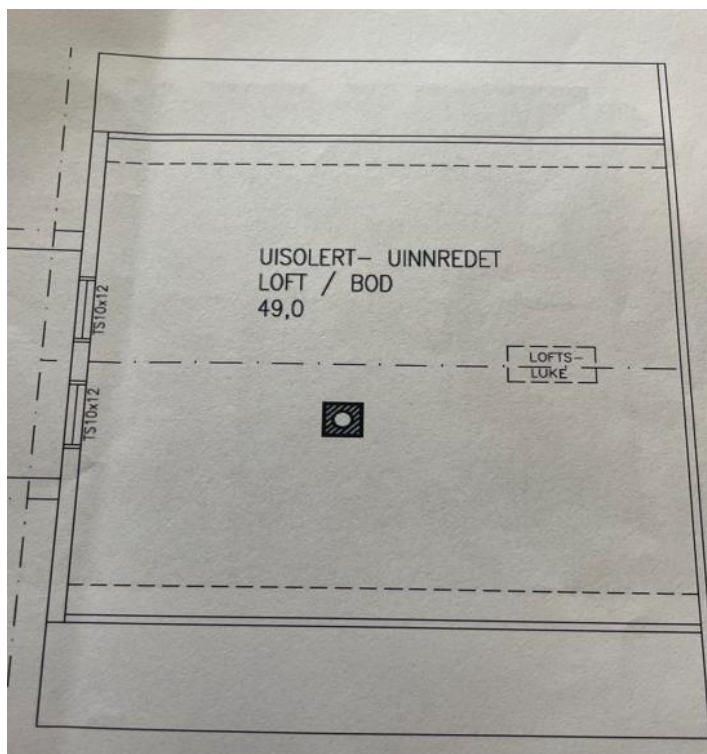

Ny plantegning loft

