




Radøy, gnr 77 bnr 88,
Data på innmålt grunnmur

28.01.2020

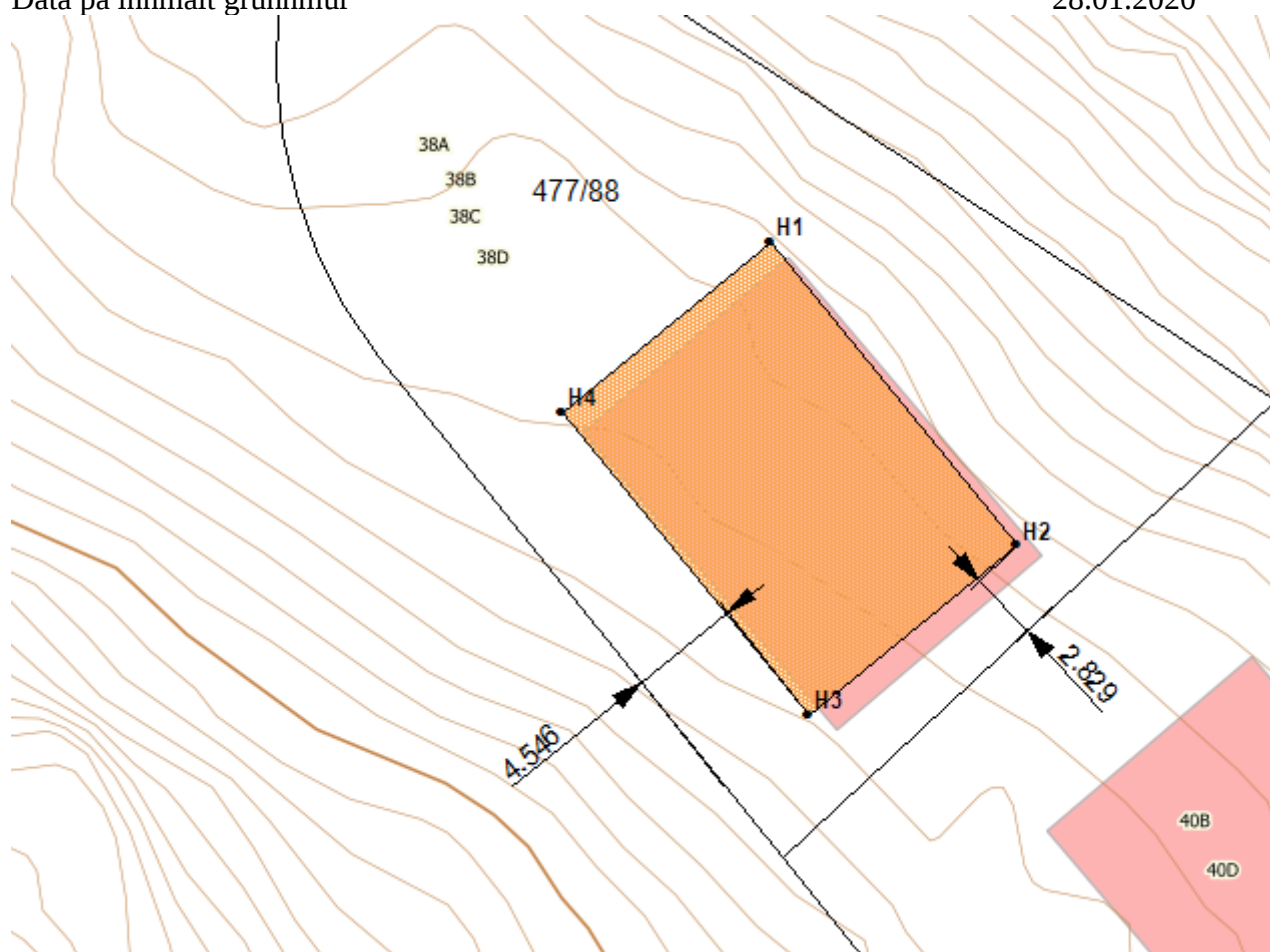

PunktID	N-koord.	Ø-koord.	Høyde
H1	6726767,21	290897,52	16,83
H2	6726754,81	290907,62	16,82
H3	6726747,86	290899,09	
H4	6726760,27	290888,99	