


D1

N6729004, Ø305902 +

29/12-2020

Einar Stusdal

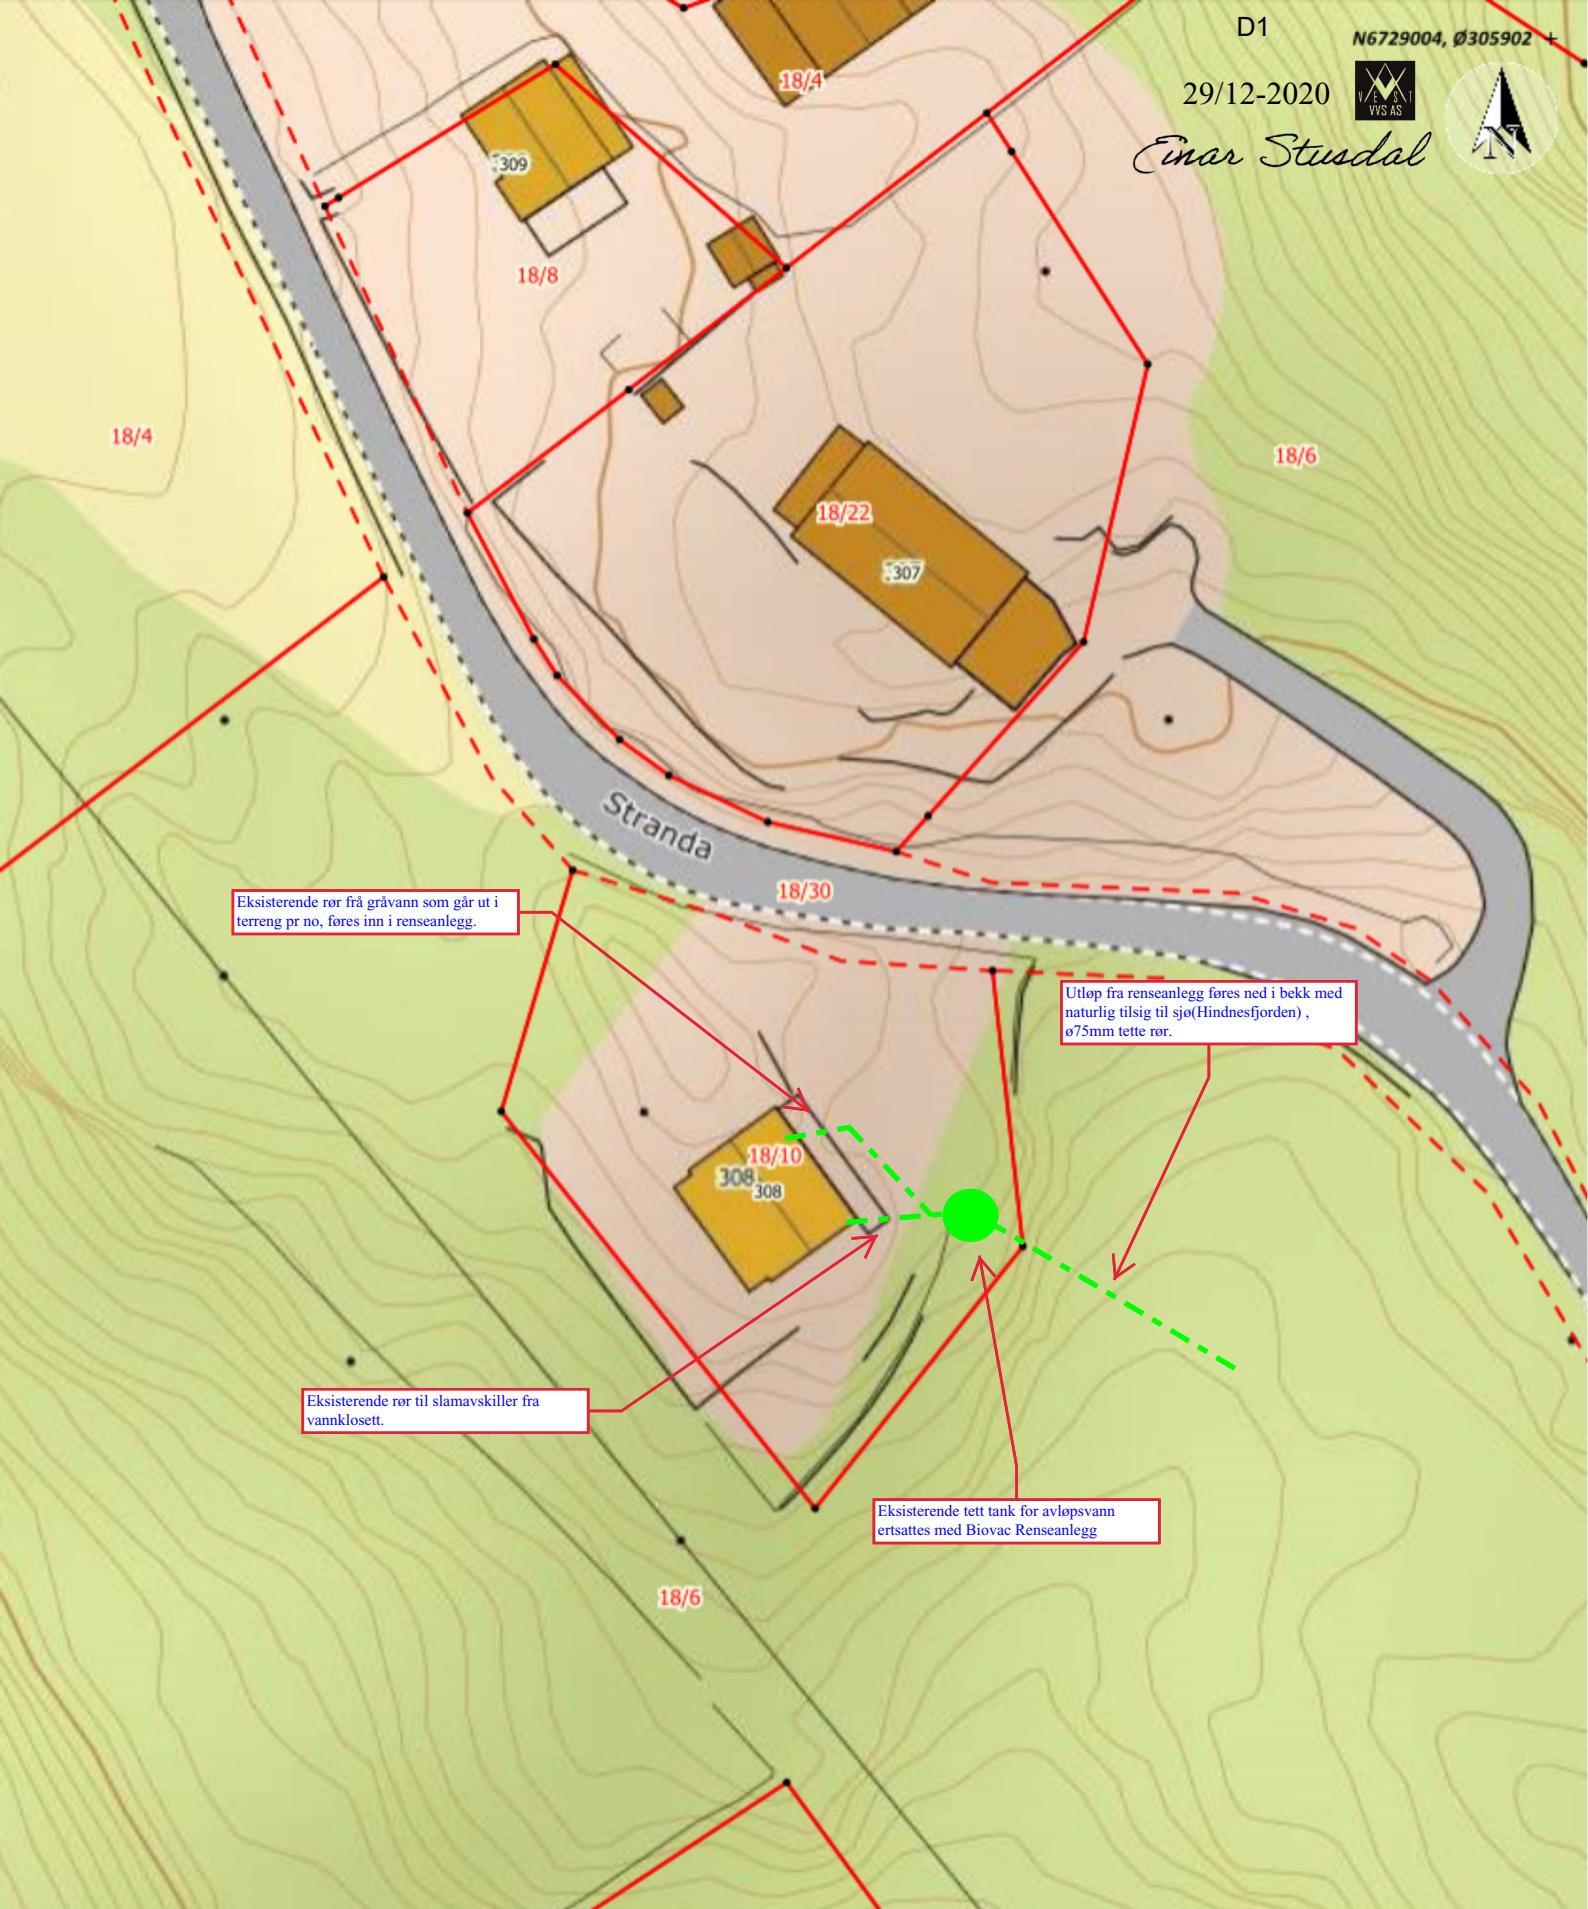

Situasjonskart -

Dato: 27-09-2020

**NHdigi.no**

Målestokk: 1:500

15m